PREPARED FOR:


LAKE GENEVA AREA REALTY
101 BROAD ST
LAKE GENEVA, WI.


PLAT OF SURVEY


- OF -

LOTS 11616, 11517, 11537 THRU 11541, OF BLOCK 207 OF THE FIFTH MAP OF LAKE COMO BEACH SUBDIVISION, BEING LOCATED IN THE TOWN OF GENEVA, WALWORTH COUNTY, WISCONSIN.

PATHFINDER SURVEYING INC.
(formerly)
J.K. SURVEYING INC.
P.O BOX 322
LAKE GENEVA, WI. 53147
WWW.PATHFINDERSURVEYING.NET
262-248-8303

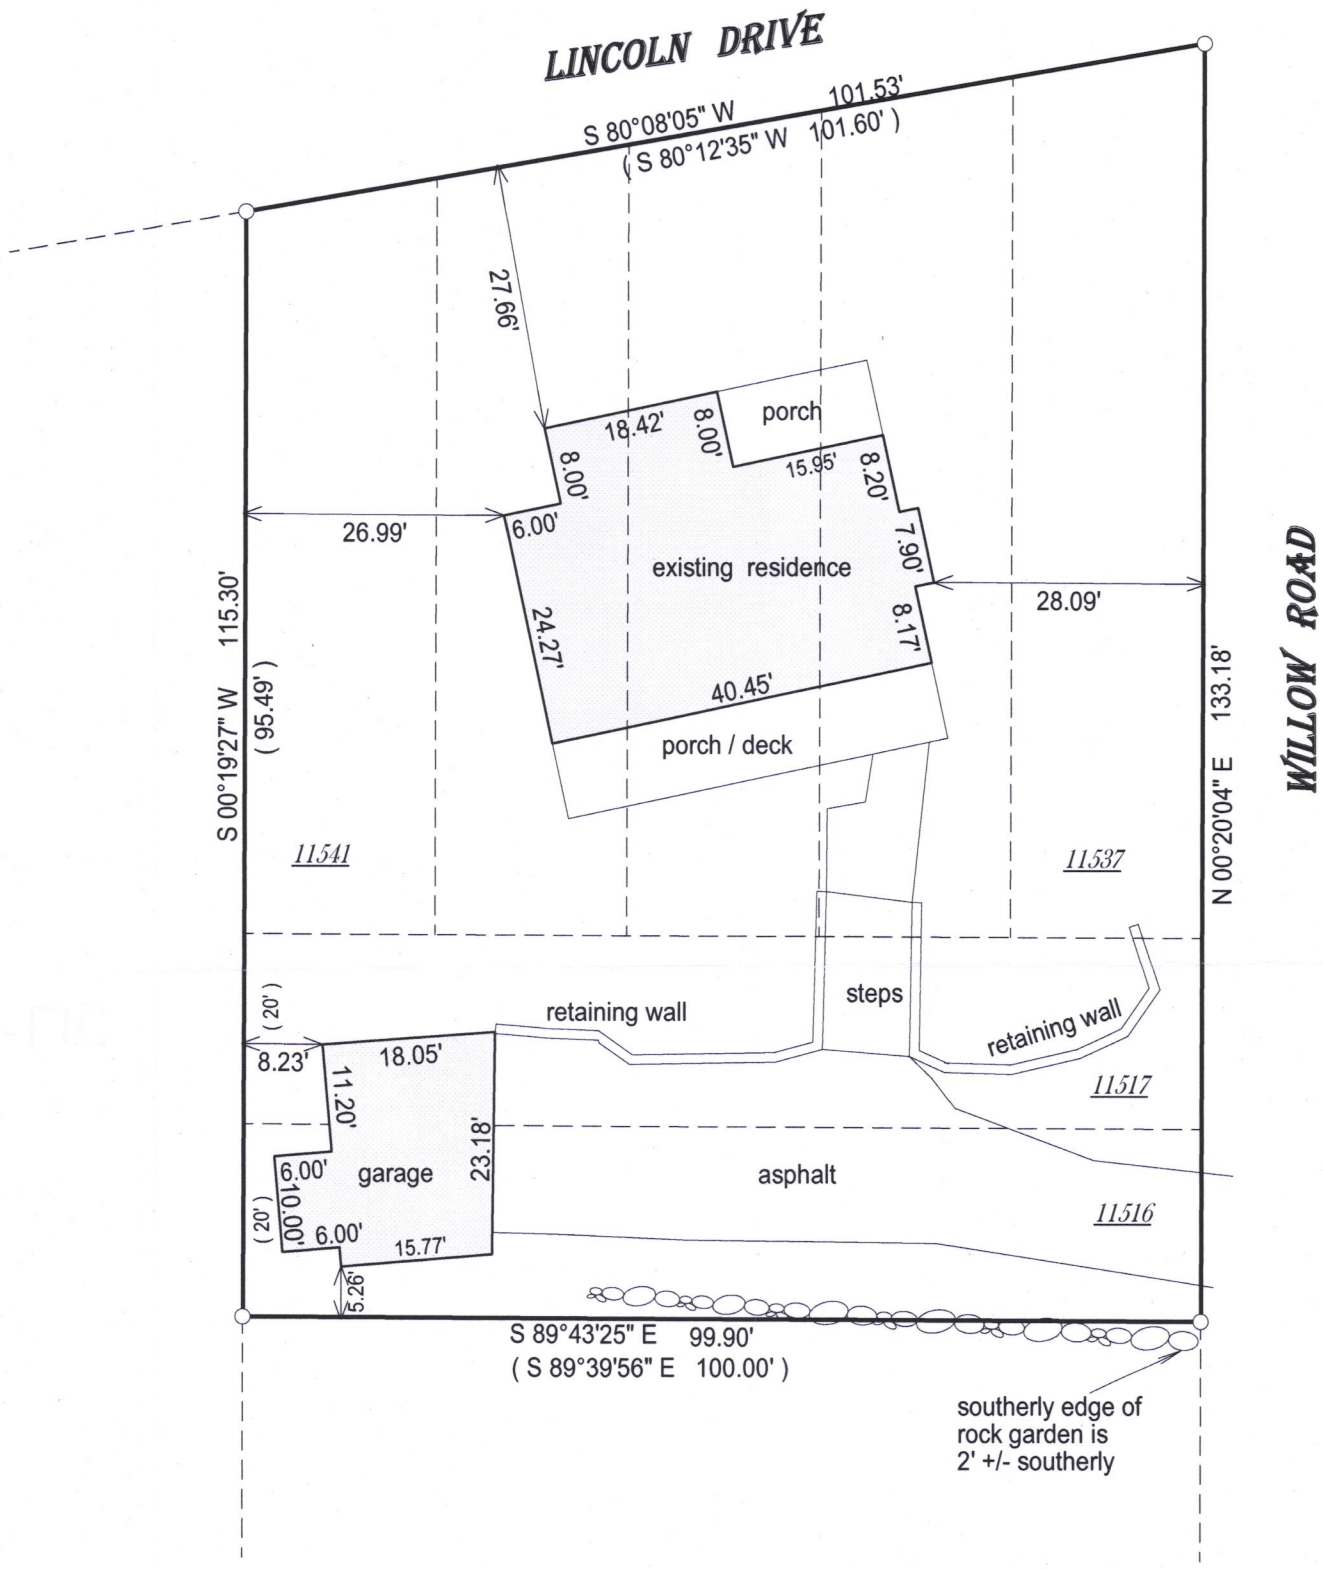

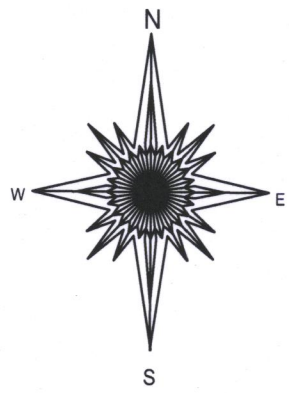

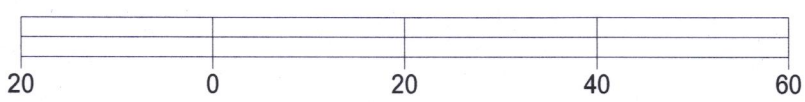

( )= recorded as

□ = found iron bar

○ = found iron pipe

● = set iron pipe

■ = set iron bar

SCALE 1" = 20'

JOB # 16-359

TAX ID # JLCB 02505

BASIS OF BEARING OF THIS PLAT: THE SUBDIVISION PLAT OF RECORD THE WEST LINE OF WILLOW WAS ASUMED TO BEAR N 0°20'04" E.

I hereby certify that I have surveyed the above- described property and the above map is a is a true representation thereof and shows the size and location of the property, its exterior boundaries, the location and dimensions of all structures thereon, fences, apparant easements and roadways and visible encroachments if any.

This survey is made for the present owners of the property, and those who purchase, mortgage, or guarantee the title thereto, within one year from the date hereof.

DATED THIS 14TH DAY OF NOVEMBER, 2016.

RECEIVED
JUN 21 2017
By



JEFFREY L KIMPS S - 2436
Wisconsin Professional Land Surveyor
(original if signed in red)

217-4311