
PREPARED FOR
MARGRET CANFIELD
@PROPERTIES
LAKE GENEVA, WI.

PATHFINDER SURVEYING INC.
(formerly)
J.K. SURVEYING INC.
P.O BOX 322
LAKE GENEVA, WI. 53147
WWW.PATHFINDERSURVEYING.NET
262-248-8303

PLAT OF SURVEY

- OF -

UNIT 04-30, GENEVA NATIONAL CONDOMINIUM No. 4, LOCATED IN TOWN 2 NORTH, RANGE 17 EAST, TOWN OF GENEVA, COUNTY OF WALWORTH AND STATE OF WISCONSIN.

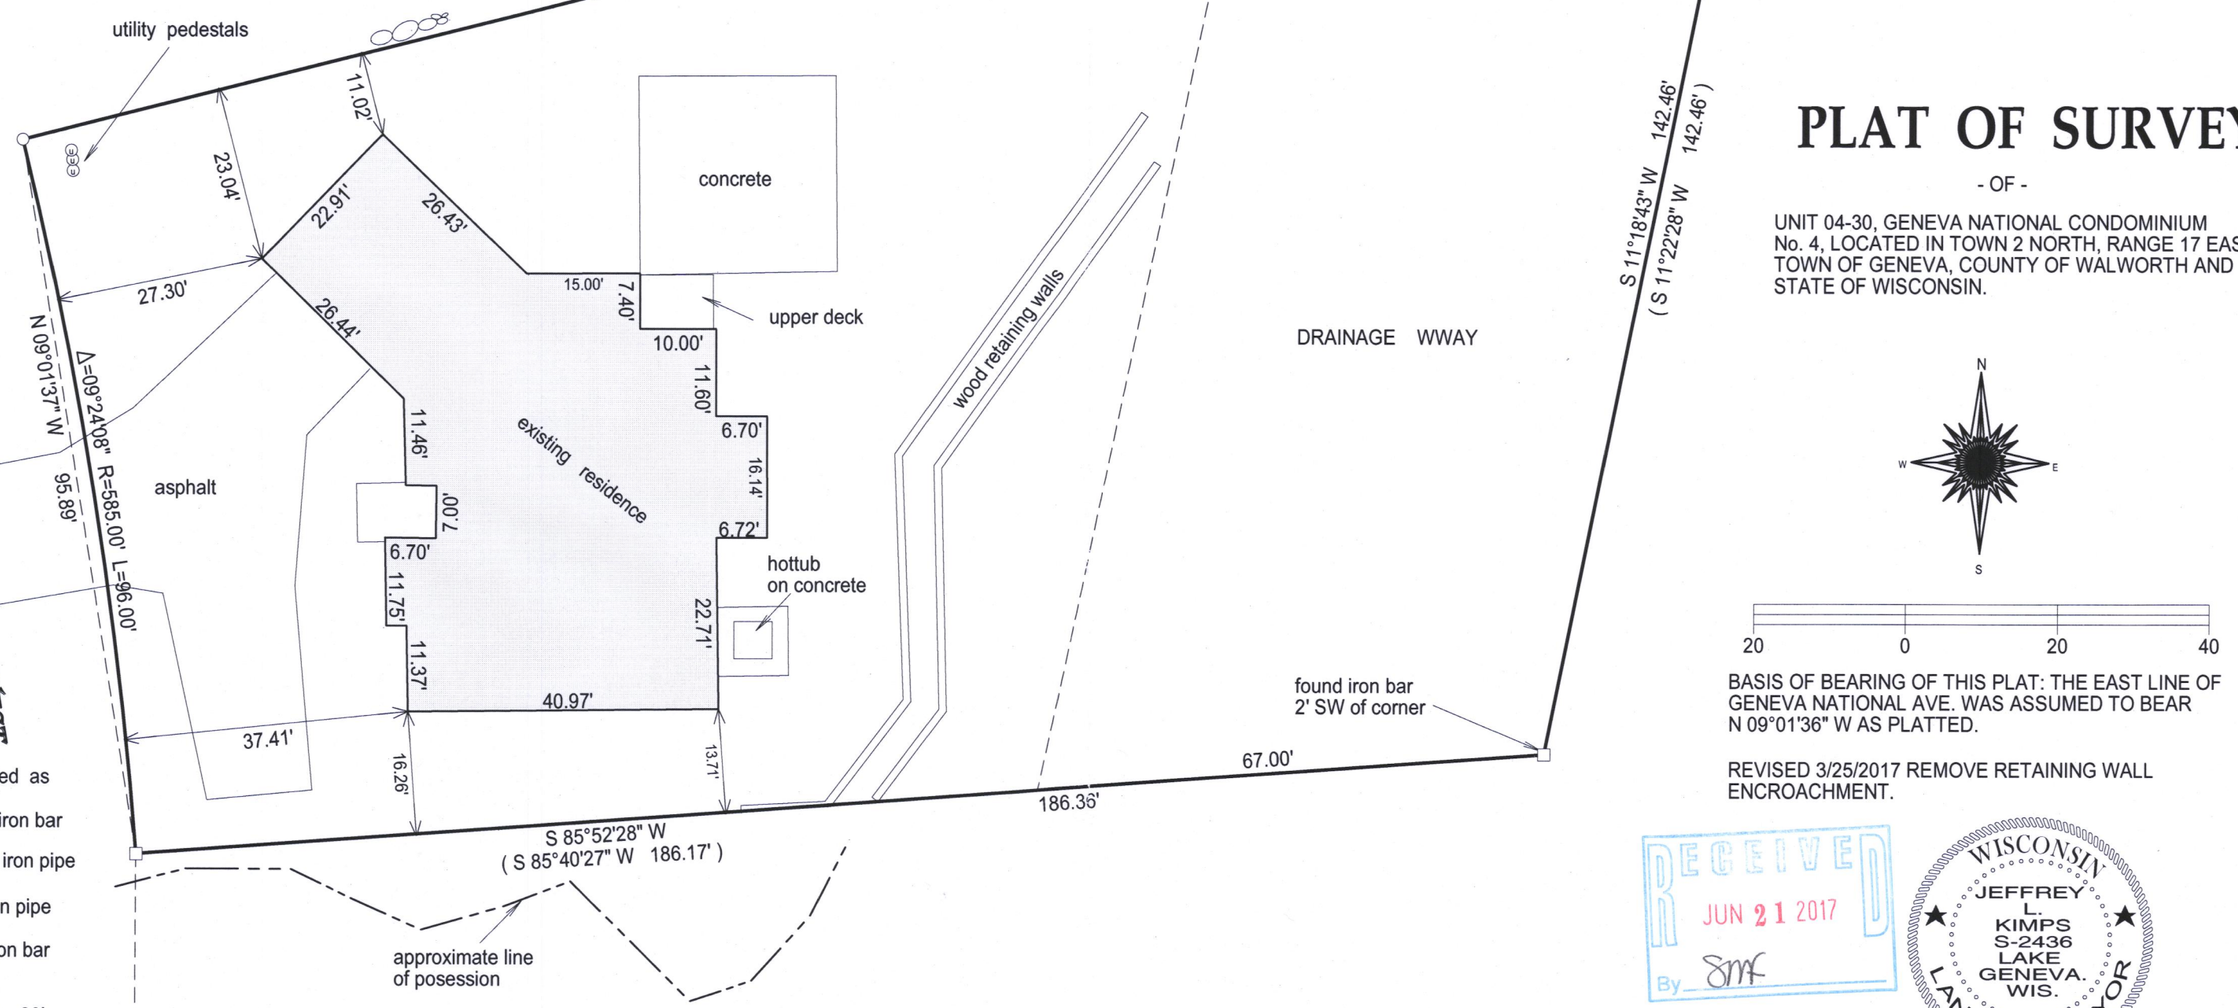

( )= recorded as
□ = found iron bar
○ = found iron pipe
● = set iron pipe
■ = set iron bar

SCALE 1" = 20'

JOB # 17-15

TAX ID # JGN4 00030

20 0 20 40

BASIS OF BEARING OF THIS PLAT: THE EAST LINE OF GENEVA NATIONAL AVE. WAS ASSUMED TO BEAR N 09°01'36" W AS PLATTED.

REVISED 3/25/2017 REMOVE RETAINING WALL ENCROACHMENT.

RECEIVED
JUN 21 2017
By SMF

WISCONSIN
JEFFREY L. KIMPS
S-2436
LAKE GENEVA. WIS.
LAND SURVEYOR

"I hereby certify that I have surveyed the above described property and that the above map is a true representation of its exterior boundary and shows the size and location of all visible structures, apparent easements and encroachments if any."

This survey is made for the present owners of the property, and those who purchase, mortgage, or guarantee the title thereto, within one year from the date hereof.

DATED THIS 31ST DAY OF JANUARY, 2017.

JEFFREY L KIMPS S-2436
Wisconsin Professional Land Surveyor
(original if signed in red)

217-4321