
HAROLD H. KOLB

REGISTERED PROFESSIONAL LAND SURVEYOR
LAKE GENEVA, WISCONSIN

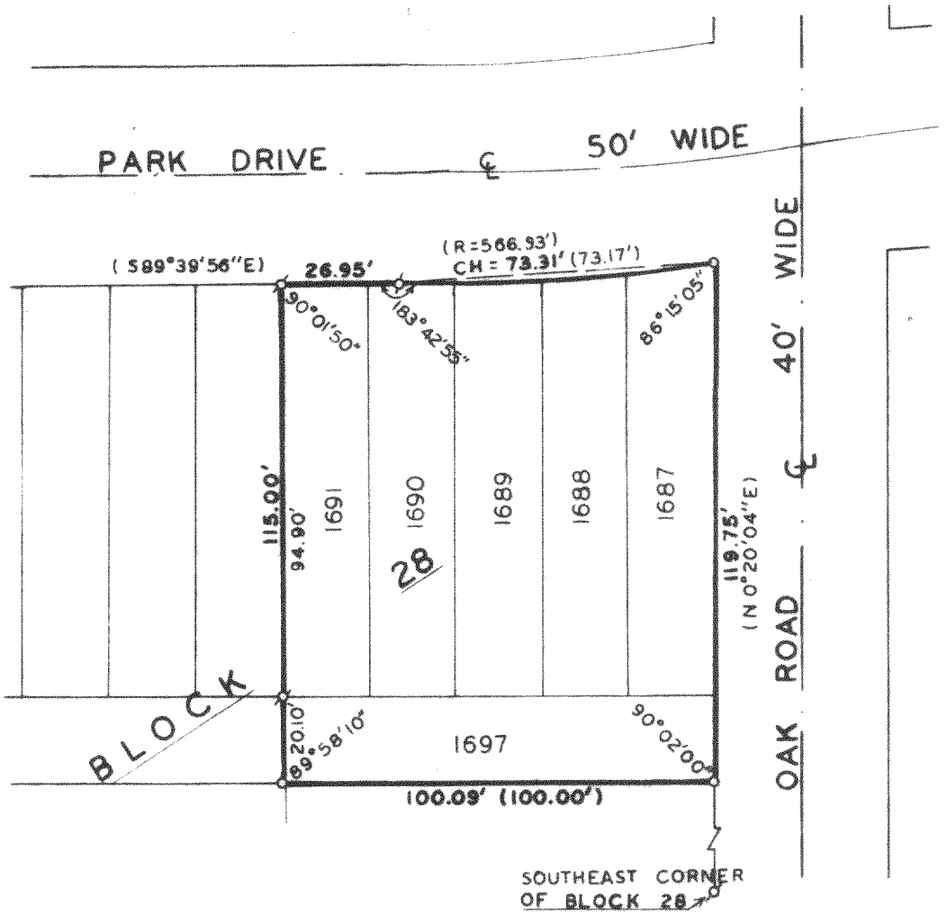

PLAT OF SURVEY OF

Lots 1687-1691 and lot 1697, Block 28, Lake Como Beach Subdivision, T2N, R17E, Walworth County, Wisconsin.

N

SCALE 1" = 40'

LEGEND

- ϕ — IRON PIPE FOUND
- O — IRON PIPE PLACED
- ● — CONCRETE MONUMENT
- x — SPIKE
- ( ) — AS PLATTED

OWNER: Max Misiurak
Park Drive Box 691
Lake Geneva, Wis.

ACCURACY: Distances ± 0.01'
Angles ± 05"
Error of closure less than 1/3000

I. HAROLD H. KOLB, DO HEREBY CERTIFY THAT I HAVE SURVEYED THE PROPERTY HEREON DESCRIBED ACCORDING TO THE OFFICIAL RECORDS, AND THAT THE PLAT HEREON IS A CORRECT REPRESENTATION OF THE LOT LINES.

WISCONSIN HAROLD H. KOLB S-187 LAKE GENEVA LAND SURVEYOR

Harold H. Kolb

HAROLD H. KOLB
WISCONSIN REGISTERED LAND SURVEYOR, S-187

DATE Feb. 17, 1975

JLCB-265

217-436