
HAROLD H. KOLB

REGISTERED PROFESSIONAL LAND SURVEYOR
LAKE GENEVA, WISCONSIN

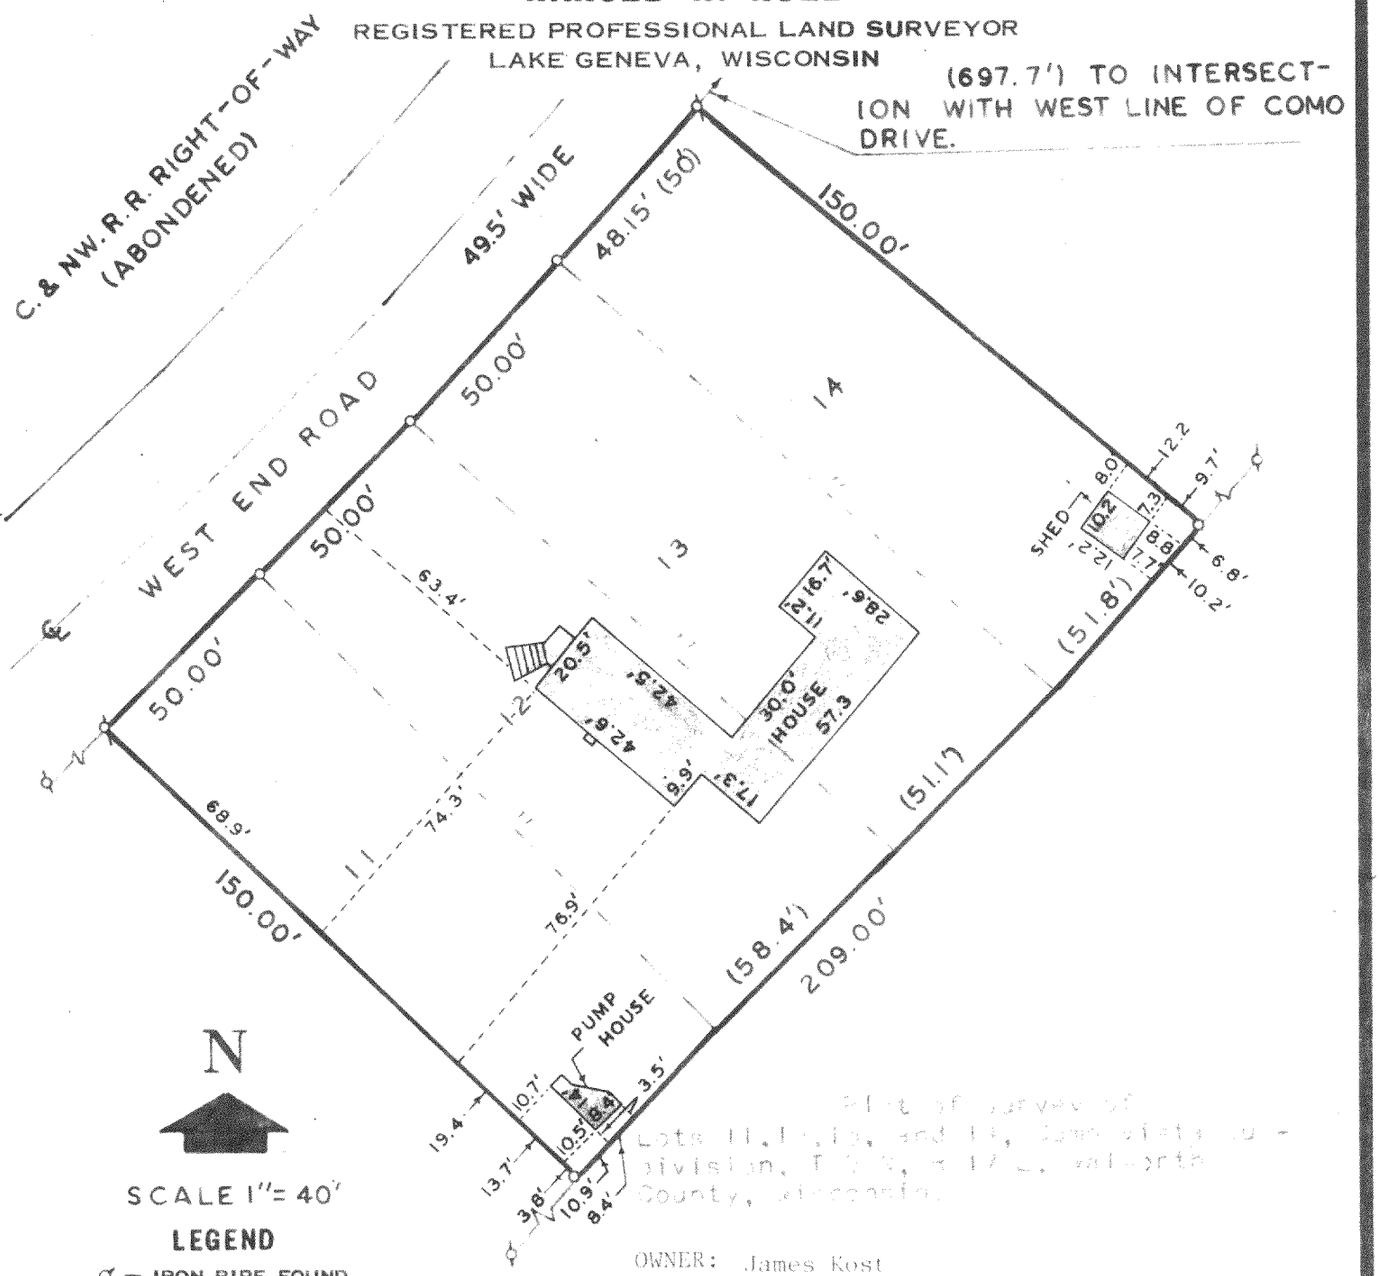

N

SCALE 1"= 40'

LEGEND

- ⌀ — IRON PIPE FOUND
- ○ — IRON PIPE PLACED
- ● — CONCRETE MONUMENT
- X — SPIKE
- ( ) — RECORDED DISTANCE

Plat of survey of
Lots 11, 12, 13, and 14, Campbells Subdivision, T 2 N, R 17 E, Walworth County, Wisconsin.

OWNER: James Kost

I, HAROLD H. KOLB, DO HEREBY CERTIFY THAT I HAVE SURVEYED THE PROPERTY HEREON DESCRIBED ACCORDING TO THE OFFICIAL RECORDS, AND THAT THE PLAT HEREON IS A CORRECT REPRESENTATION OF THE LOT LINES, and the principle lines of the buildings thereon.

Harold H. Kolb

HAROLD H. KOLB
WISCONSIN REGISTERED LAND SURVEYOR, S-187
DATE August 3, 1954

REVISED: March 31, 1975

WISCONSIN
HAROLD H. KOLB
S-187
LAKE GENEVA, WIS.
LAND SURVEYOR

217-437