
LAND-MARK SURVEYING
Mark L. Miritz
Wisconsin Professional Land Surveyor S-2582

N9330 Knuteson Drive
Whitewater, WI 53190
Phone:(262)495-3284
MARKMIRITZ@
LAND-MARKSURVEYING.COM

PLAT OF SURVEY

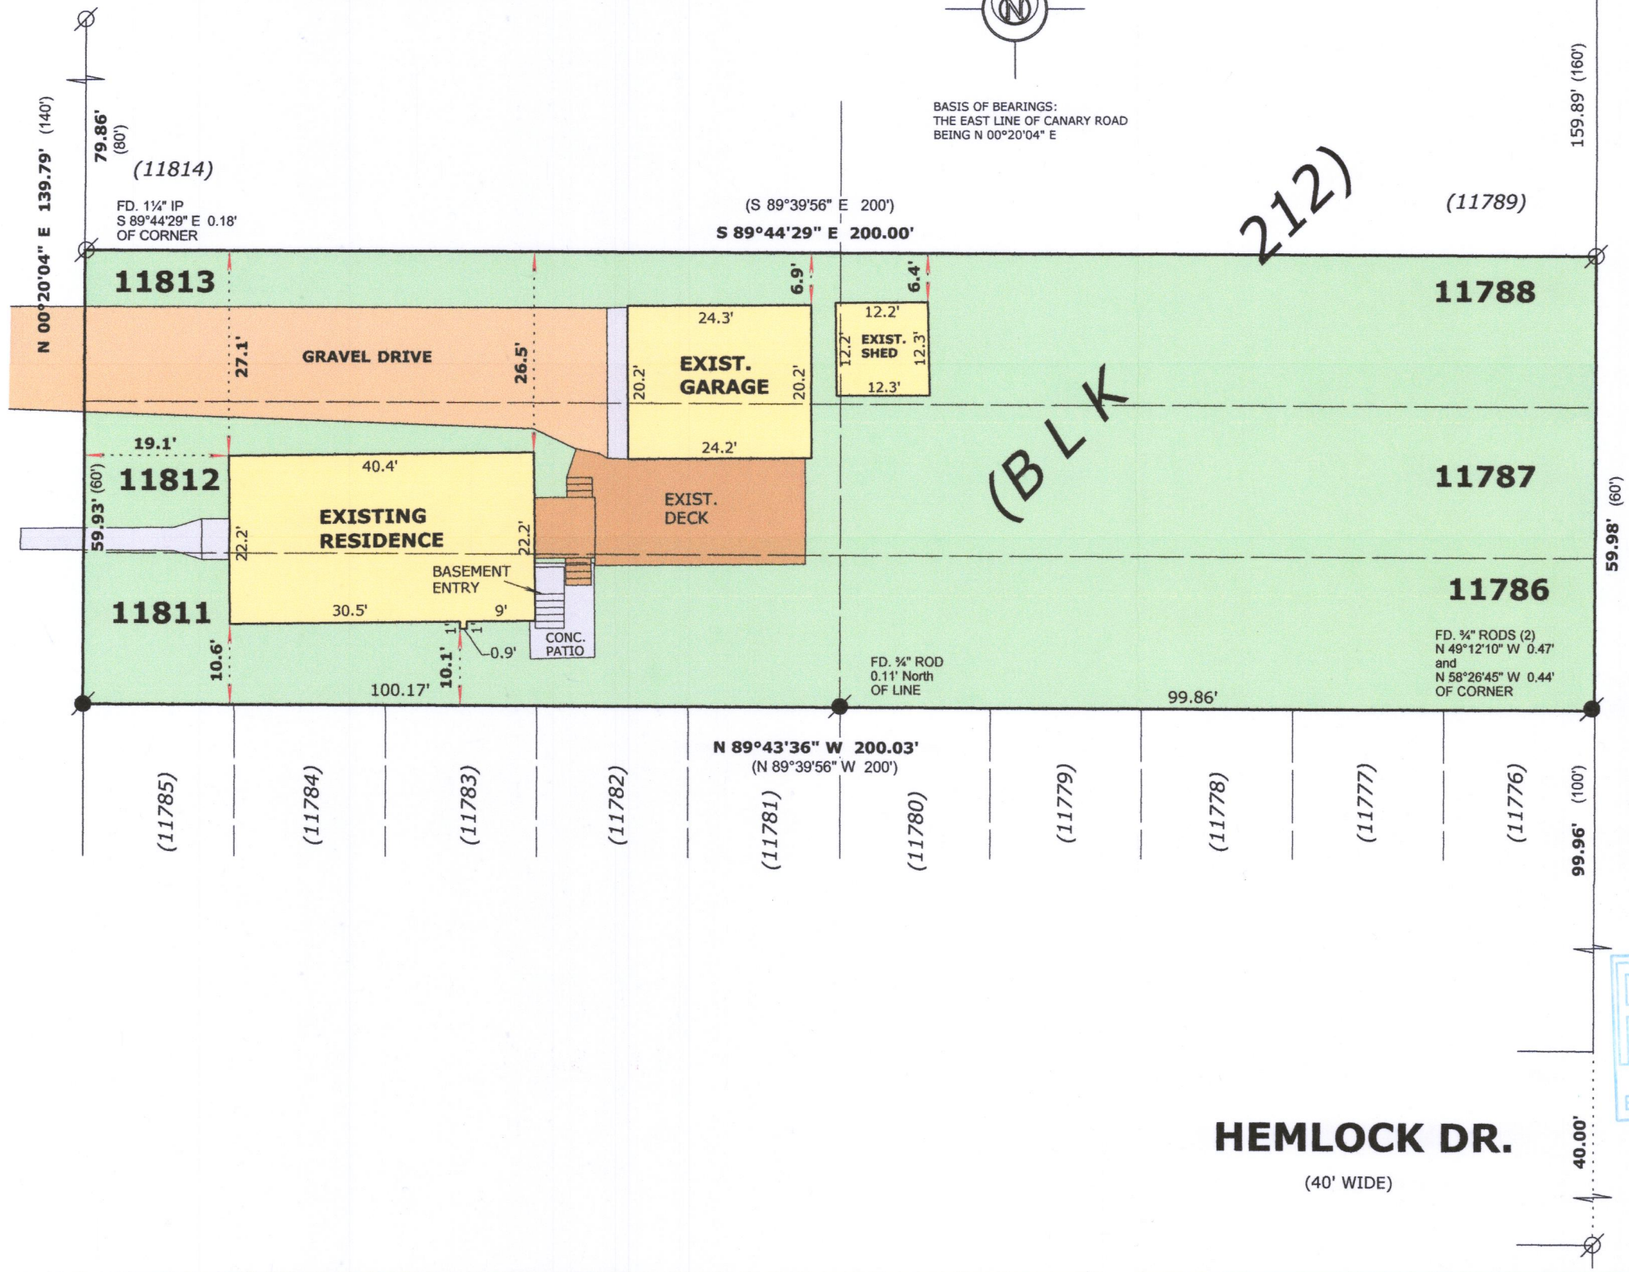

OWNER: DONALD G. JANOSEK
PAULA M. JANOSEK
5925 S. NEW ENGLAND
CHICAGO, IL. 60638

LEGAL DESCRIPTION:

LOCATED IN THE NORTHEAST 1/4, OF THE SOUTHEAST 1/4, SECTION 29, TOWNSHIP 2 NORTH, RANGE 17 EAST, IN THE TOWN OF GENEVA, WALWORTH COUNTY, WISCONSIN

LOTS 11786 THRU 11788 INCLUSIVE AND LOTS 11811 THRU 11813 INCLUSIVE, ALL IN BLOCK 212, LAKE COMO BEACH FIFTH MAP

WISCONSIN
MARK L. MIRITZ
S-2582
WHITEWATER, WI
LAND SURVEYOR

LEGEND

- FOUND IRON PIPE
- FOUND IRON ROD
- SET IRON ROD, 18" LONG, WEIGHING 1.5 LBS./LINEAL FT., 3/4" DIA.
- (x x) RECORDED AS DIMENSION
- —x—x— EXISTING FENCE

SCALE: 1 INCH = 20 FEET

"I hereby certify that the above described property has been surveyed by me or under my direction and that the above map is a true representation thereof and shows the size and location of the property, its exterior boundaries, the location of all visible structures and dimensions of all principal buildings thereon, boundary fences, apparent easements, roadways and visible encroachments, if any."
"This survey is made for the use of the present owners of the property, and also those who purchase, mortgage, or guarantee the title thereto within one year from date hereof."

Mark L. Miritz

MARK L. MIRITZ
WISCONSIN PROFESSIONAL
LAND SURVEYOR S-2582

DATE: December 14, 2017 **JOB NO.** 17.1203

RECEIVED
DEC 22 2017
By Jan

JLCB-2569 217-4399