PREPARED FOR
KEEFE EAL ESTATE


ORDERED BY
TAMMY HAASE


PLAT OF SURVEY

- OF -

UNIT 20-36 GENEVA NATIONAL CONDOMINIUM NO. 20 AS RECORDED UNDER DOC NO. 194896 IN THE NORTHWEST 1/4 AND THE SOUTHWEST 1/4 OF SECTION 29, TOWNSHIP 2 NORTH, RANGE 17 EAST, IN THE TOWN OF GENEVA, WALWORTH COUNTY, WISCONSIN.

PATHFINDER SURVEYING
(a NMB Company)
P.O BOX 322
LAKE GENEVA, WI. 53147
WWW.PATHFINDERSURVEYING.NET
262-248-8303

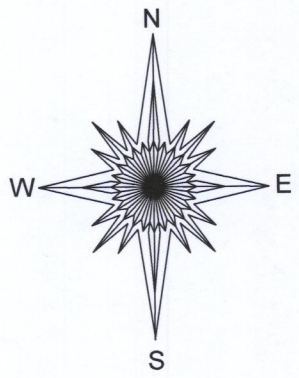

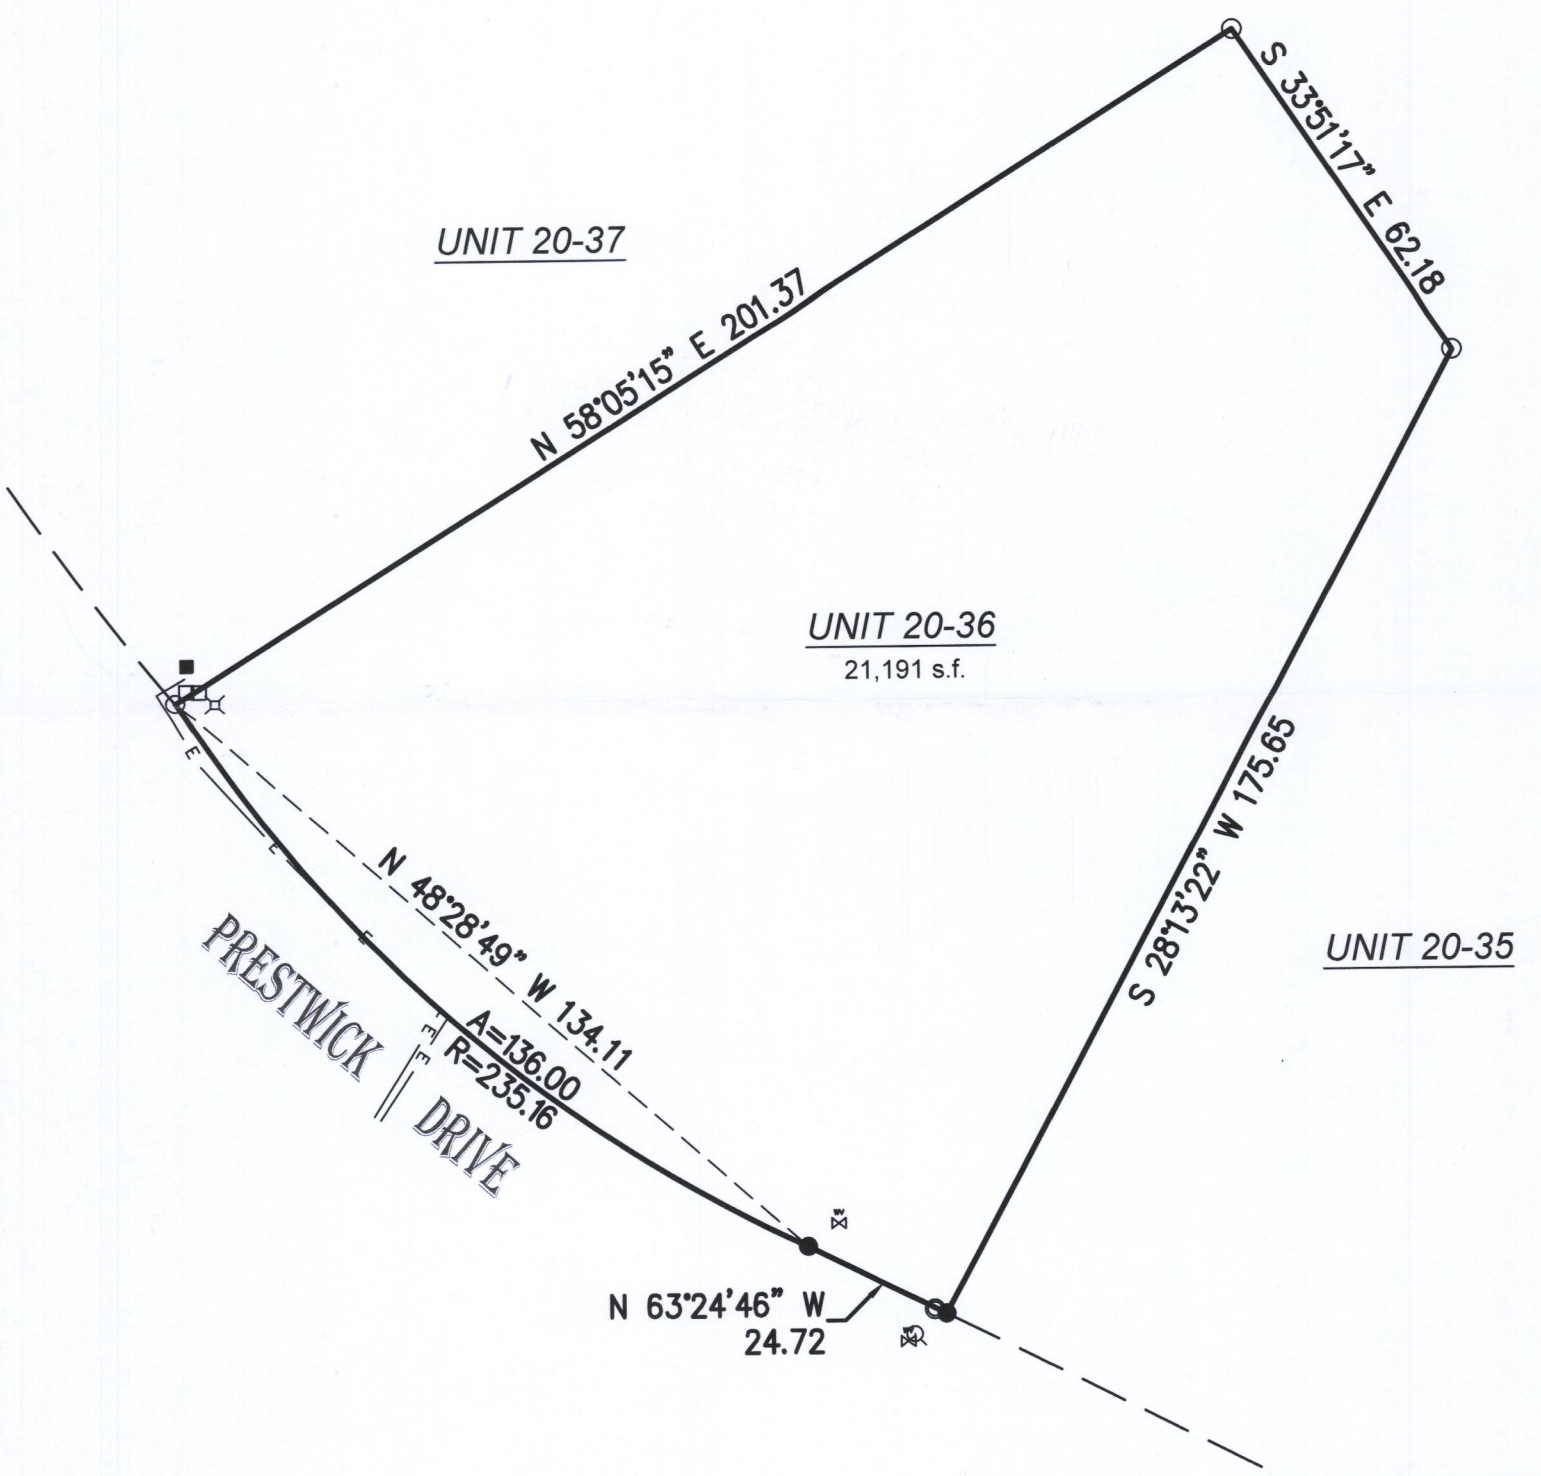

WV = water valve
= electric pedestal
= found iron pipe
= pad mount transformer
= communication box
= hydrant
= set 5/8" rebar

SCALE 1" = 30'

JOB # 2017.0272.01

TAX ID # JGN 2000036

30 0 30 60 90

BASIS OF BEARING OF THIS PLAT: THE PLAT OF GENEVA NATIONAL CONDOMINIUM NO. 20.

I hereby certify that I have surveyed the above- described property and the above map is a is a true representation thereof and shows the size and location of the property, its exterior boundaries, the location and dimensions of all structures thereon, fences, apparent easements and roadways and visible encroachments if any.

This survey is made for the present owners of the property, and those who purchase, mortgage, or guarantee the title thereto, within one year from the date hereof.

DATED THIS 28TH DAY OF NOVEMBER, 2017.

RECEIVED
APR 11 2018
By Jan

WISCONSIN
MARK R. MADSEN
S-2271
RACINE, WI
LAND SURVEYOR

MARK R. MADSEN S - 2271
Wisconsin Professional Land Surveyor

JGN 20-36 217-4418