
PREPARED FOR
ROBERT KINNUCAN


PLAT OF SURVEY

- OF -

LOT 13 TRINITY MOUNTAIN ESTATES A SUBDIVISION LOCATED IN THE NW 1/4, NE 1/4, SW 1/4 AND SE 1/4 OF THE SOUTHEAST 1/4 OF SECTION 13 AND THE NE 1/4 AND NW 1/4 OF THE NORTHEAST 1/4 OF SECTION 24, TOWNSHIP 2 NORTH, RANGE 17 EAST TOWN OF GENEVA, WALWORTH COUNTY, WISCONSIN.

PATHFINDER SURVEYING
(a NMB Company)
P.O BOX 322
LAKE GENEVA, WI. 53147
WWW.PATHFINDERSURVEYING.NET
262-248-8303

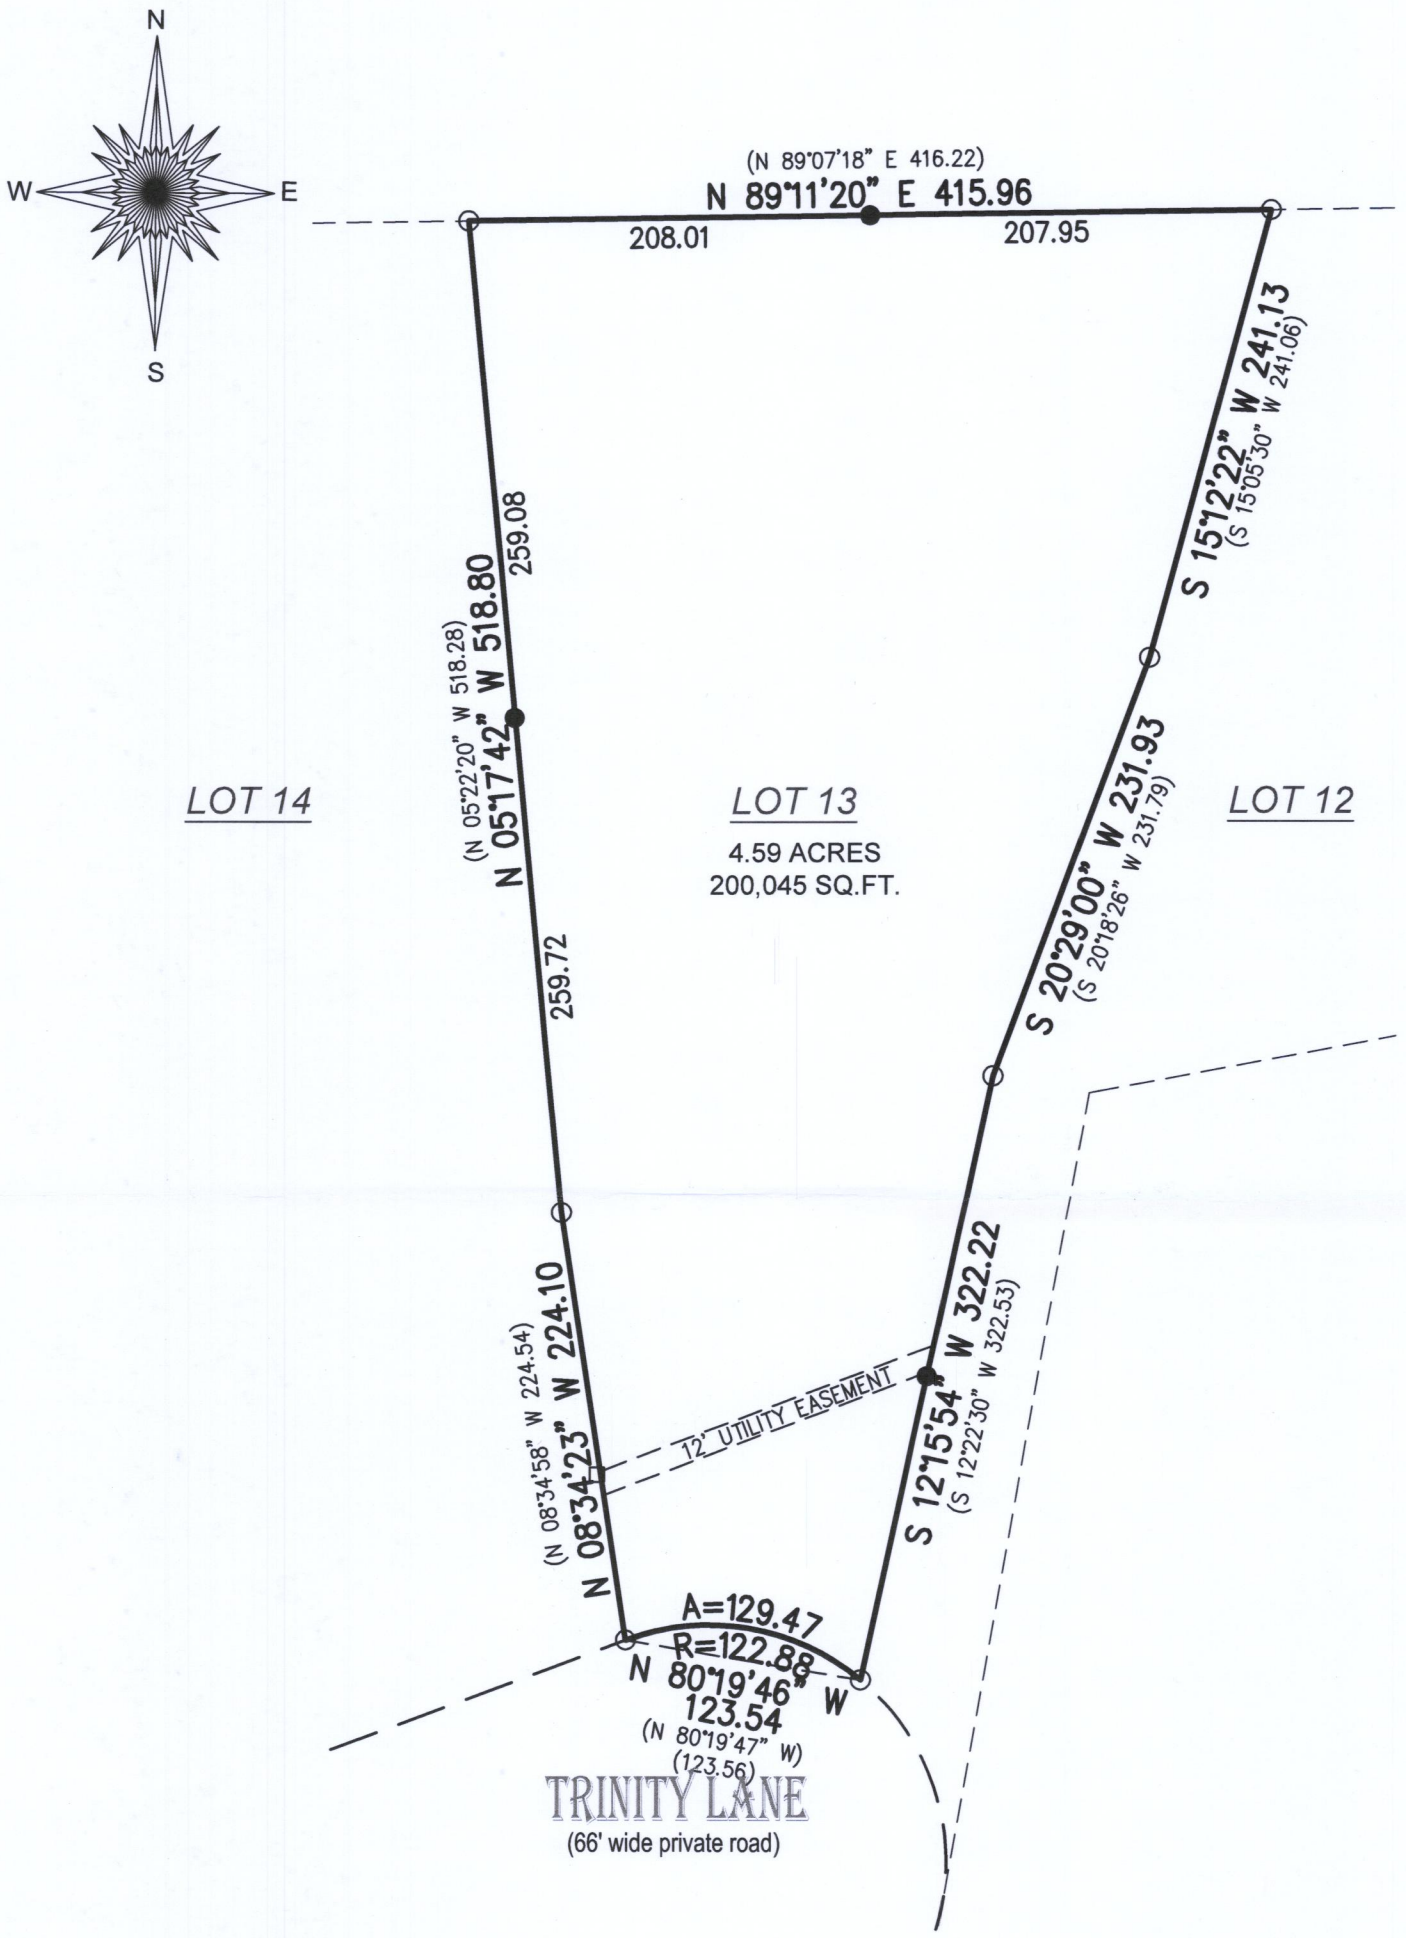

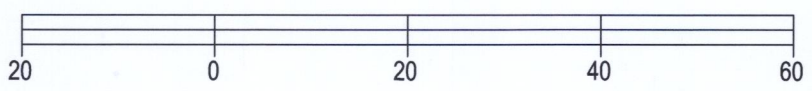

○ = found iron pipe
● = set 5/8" rebar
□ = communication box

SCALE 1" = 100'

JOB # 2017.0290.01

TAX ID # JTR00013

BASIS OF BEARING OF THIS PLAT: THE US STATE PLANE COORDINATE SYSTEM SOUTH ZONE, NAD 83. WISCORS.

I hereby certify that I have surveyed the above- described property and the above map is a is a true representation thereof and shows the size and location of the property, its exterior boundaries, the location and dimensions of all structures thereon, fences, apparent easements and roadways and visible encroachments if any.

This survey is made for the present owners of the property, and those who purchase, mortgage, or guarantee the title thereto, within one year from the date hereof.

DATED THIS 5TH DAY OF DECEMBER, 2017.

RECEIVED
APR 11 2018
By Jan

WISCONSIN
MARK R. MADSEN
S-2271
RACINE, WI
LAND SURVEYOR

MARK R. MADSEN S - 2271
Wisconsin Professional Land Surveyor

JTR-13 217-4424