AMBIT LAND SURVEYING
8120–312th Avenue
Wheatland, WI. 53105–8934
Licensed Professionals in
both Illinois & Wisconsin


PHONE: 262–537–4874
FAX: 262–537–4221
EMAIL: ambit@tds.net

PLAT OF SURVEY

OF

Lots 2196, 2197, 2198, 2199, 2200, 2201 and 2202, Block 36 of LAKE COMO BEACH SUBDIVISION THIRD MAP, being a subdivision located in Section 22, Township 2 North, Range 17 East of the 4th Principal Meridian, Walworth County, Wisconsin.

PARCEL IDENTIFICATION NO: JLCB 00374A

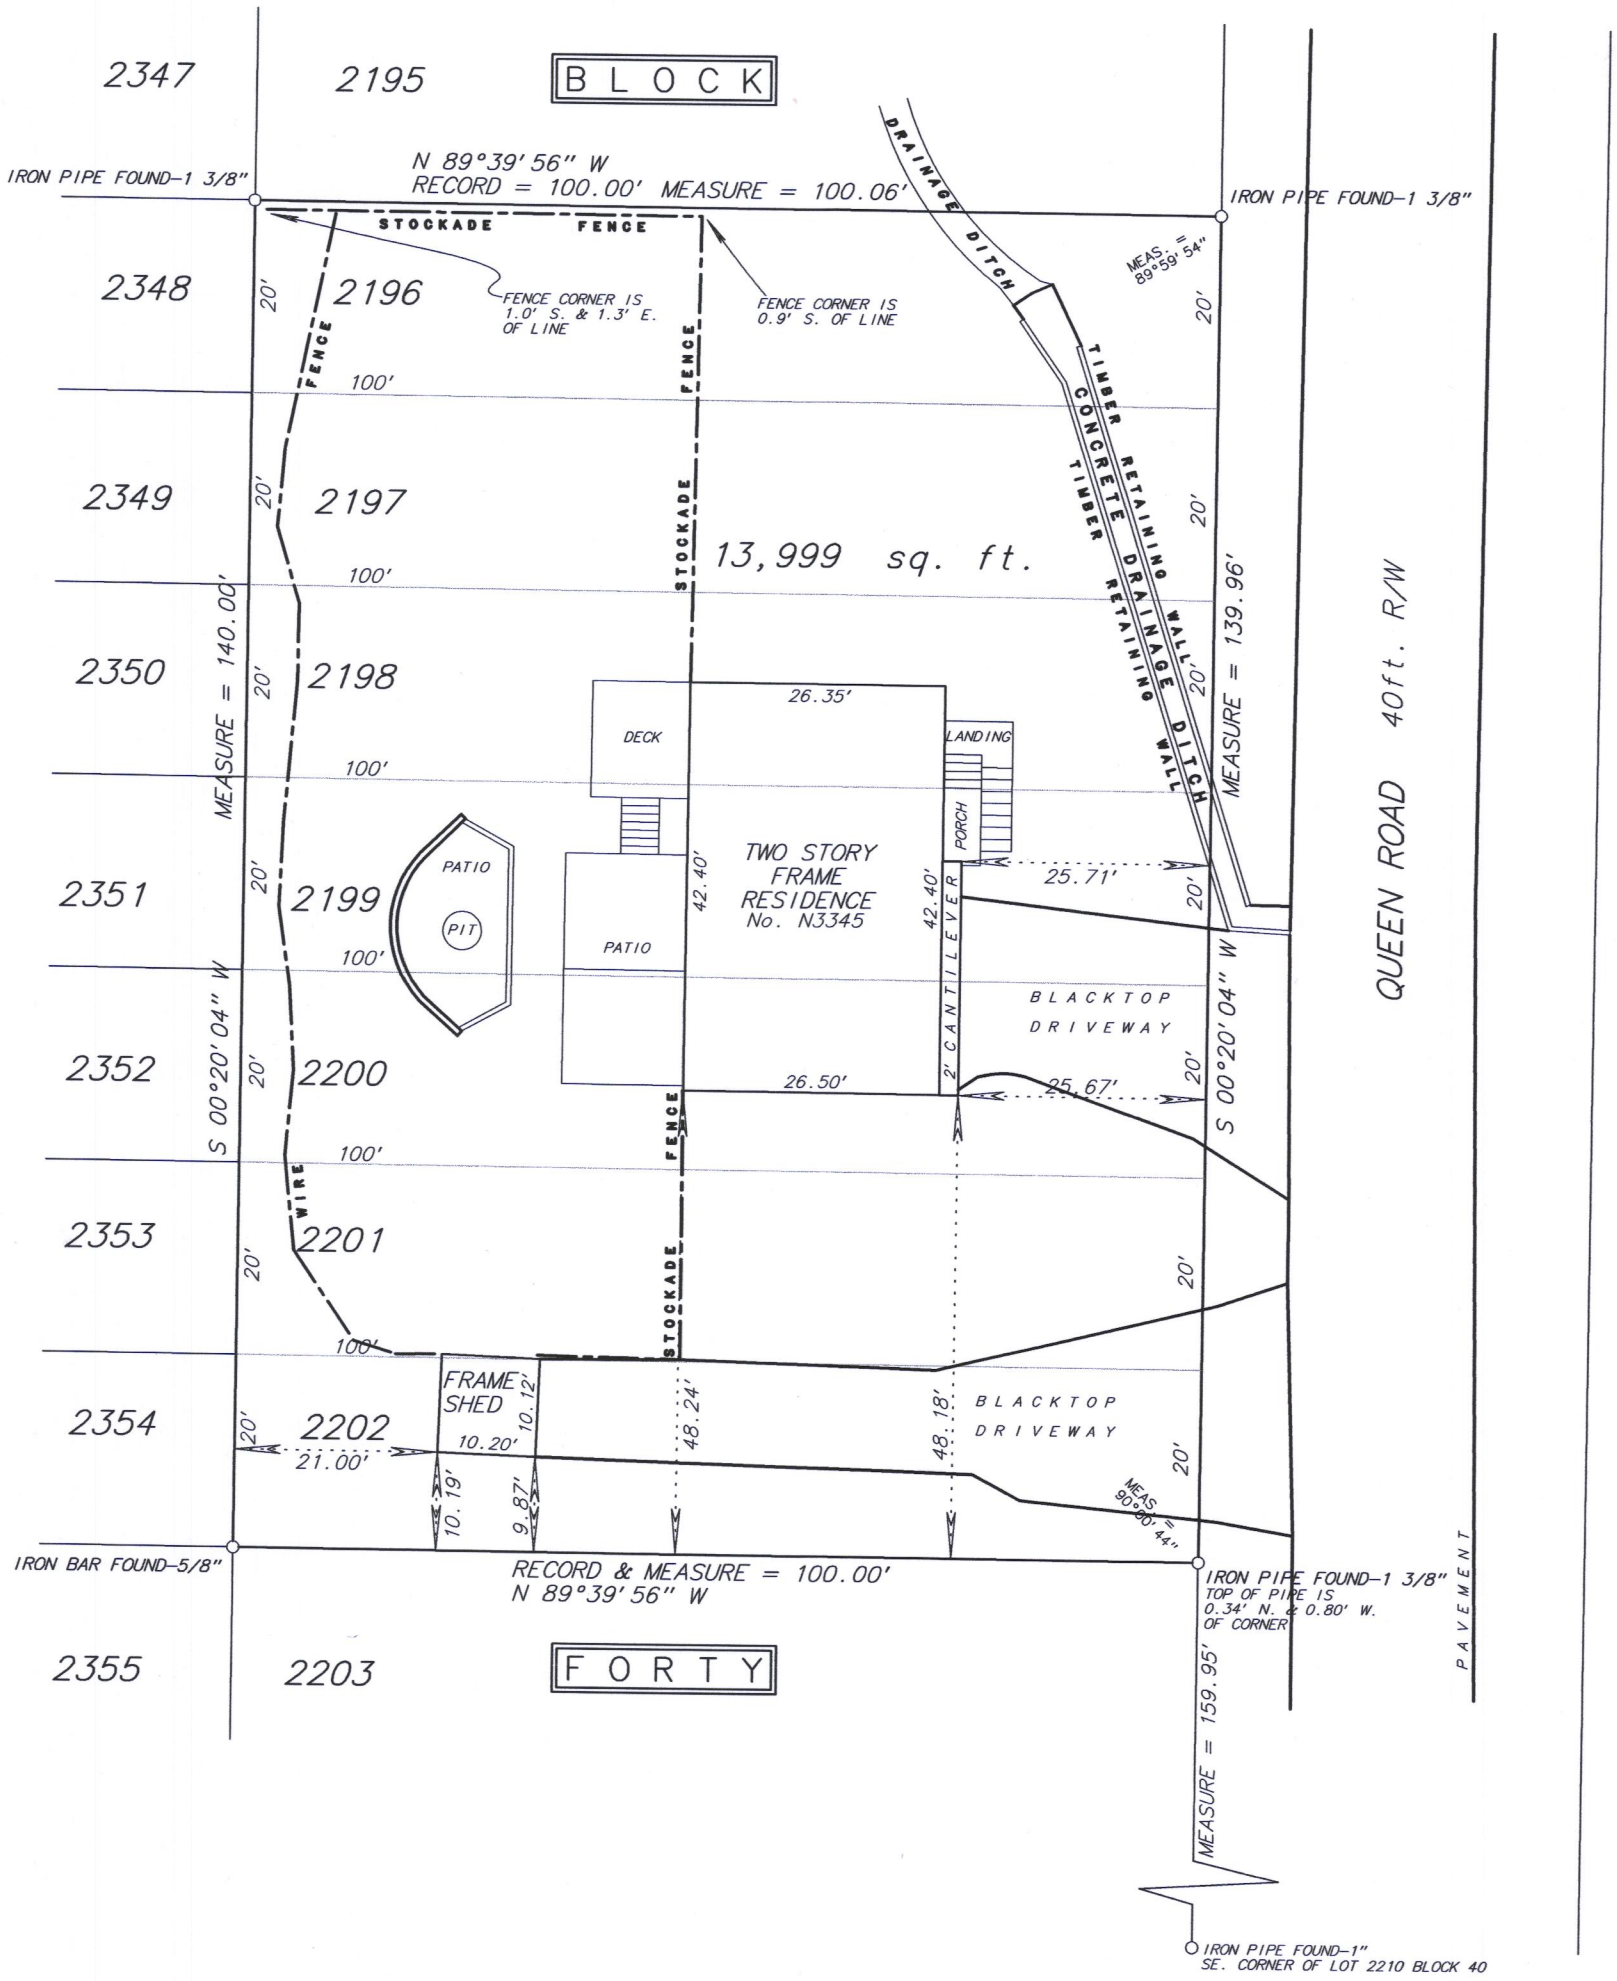

SCALE: 1 inch = 20 feet

ORDERED BY: C. Perzenski

JOB NO.: 17103

JLCB-374A

Fieldwork completed on and date of certification: August 31, 2017

I hereby certify that I have surveyed the above described property and the above plat is a true representation thereof and shows the size and location of the property, its exterior boundaries, the location and dimensions of all visible structures thereon, boundary fences, apparent easements and roadways and visible encroachments, if any.

This survey is made for the exclusive use of the present owners of the property, and also those who purchase, mortgage or guarantee the title thereto within ONE YEAR from the date hereof.

Dated at Bassett, Wisconsin this _____ day of _____ 2017.

OFFICE COPY

Mark A. Bolender
Wisconsin Professional Land Surveyor – 1784

217-4453