
**LAND-MARK SURVEYING**
**Mark L. Miritz**
**Wisconsin Professional Land Surveyor S-2582**

N9330 Knuteson Drive
Whitewater, WI 53190
Phone:(262)495-3284
MARKMIRITZ@
LAND-MARKSURVEYING.COM

**OWNER: MIKRUIT BUILDERS INC.**
**N3402 CLUBHOUSE DR.**
**LAKE GENEVA, WI. 53147**

# PLAT OF SURVEY

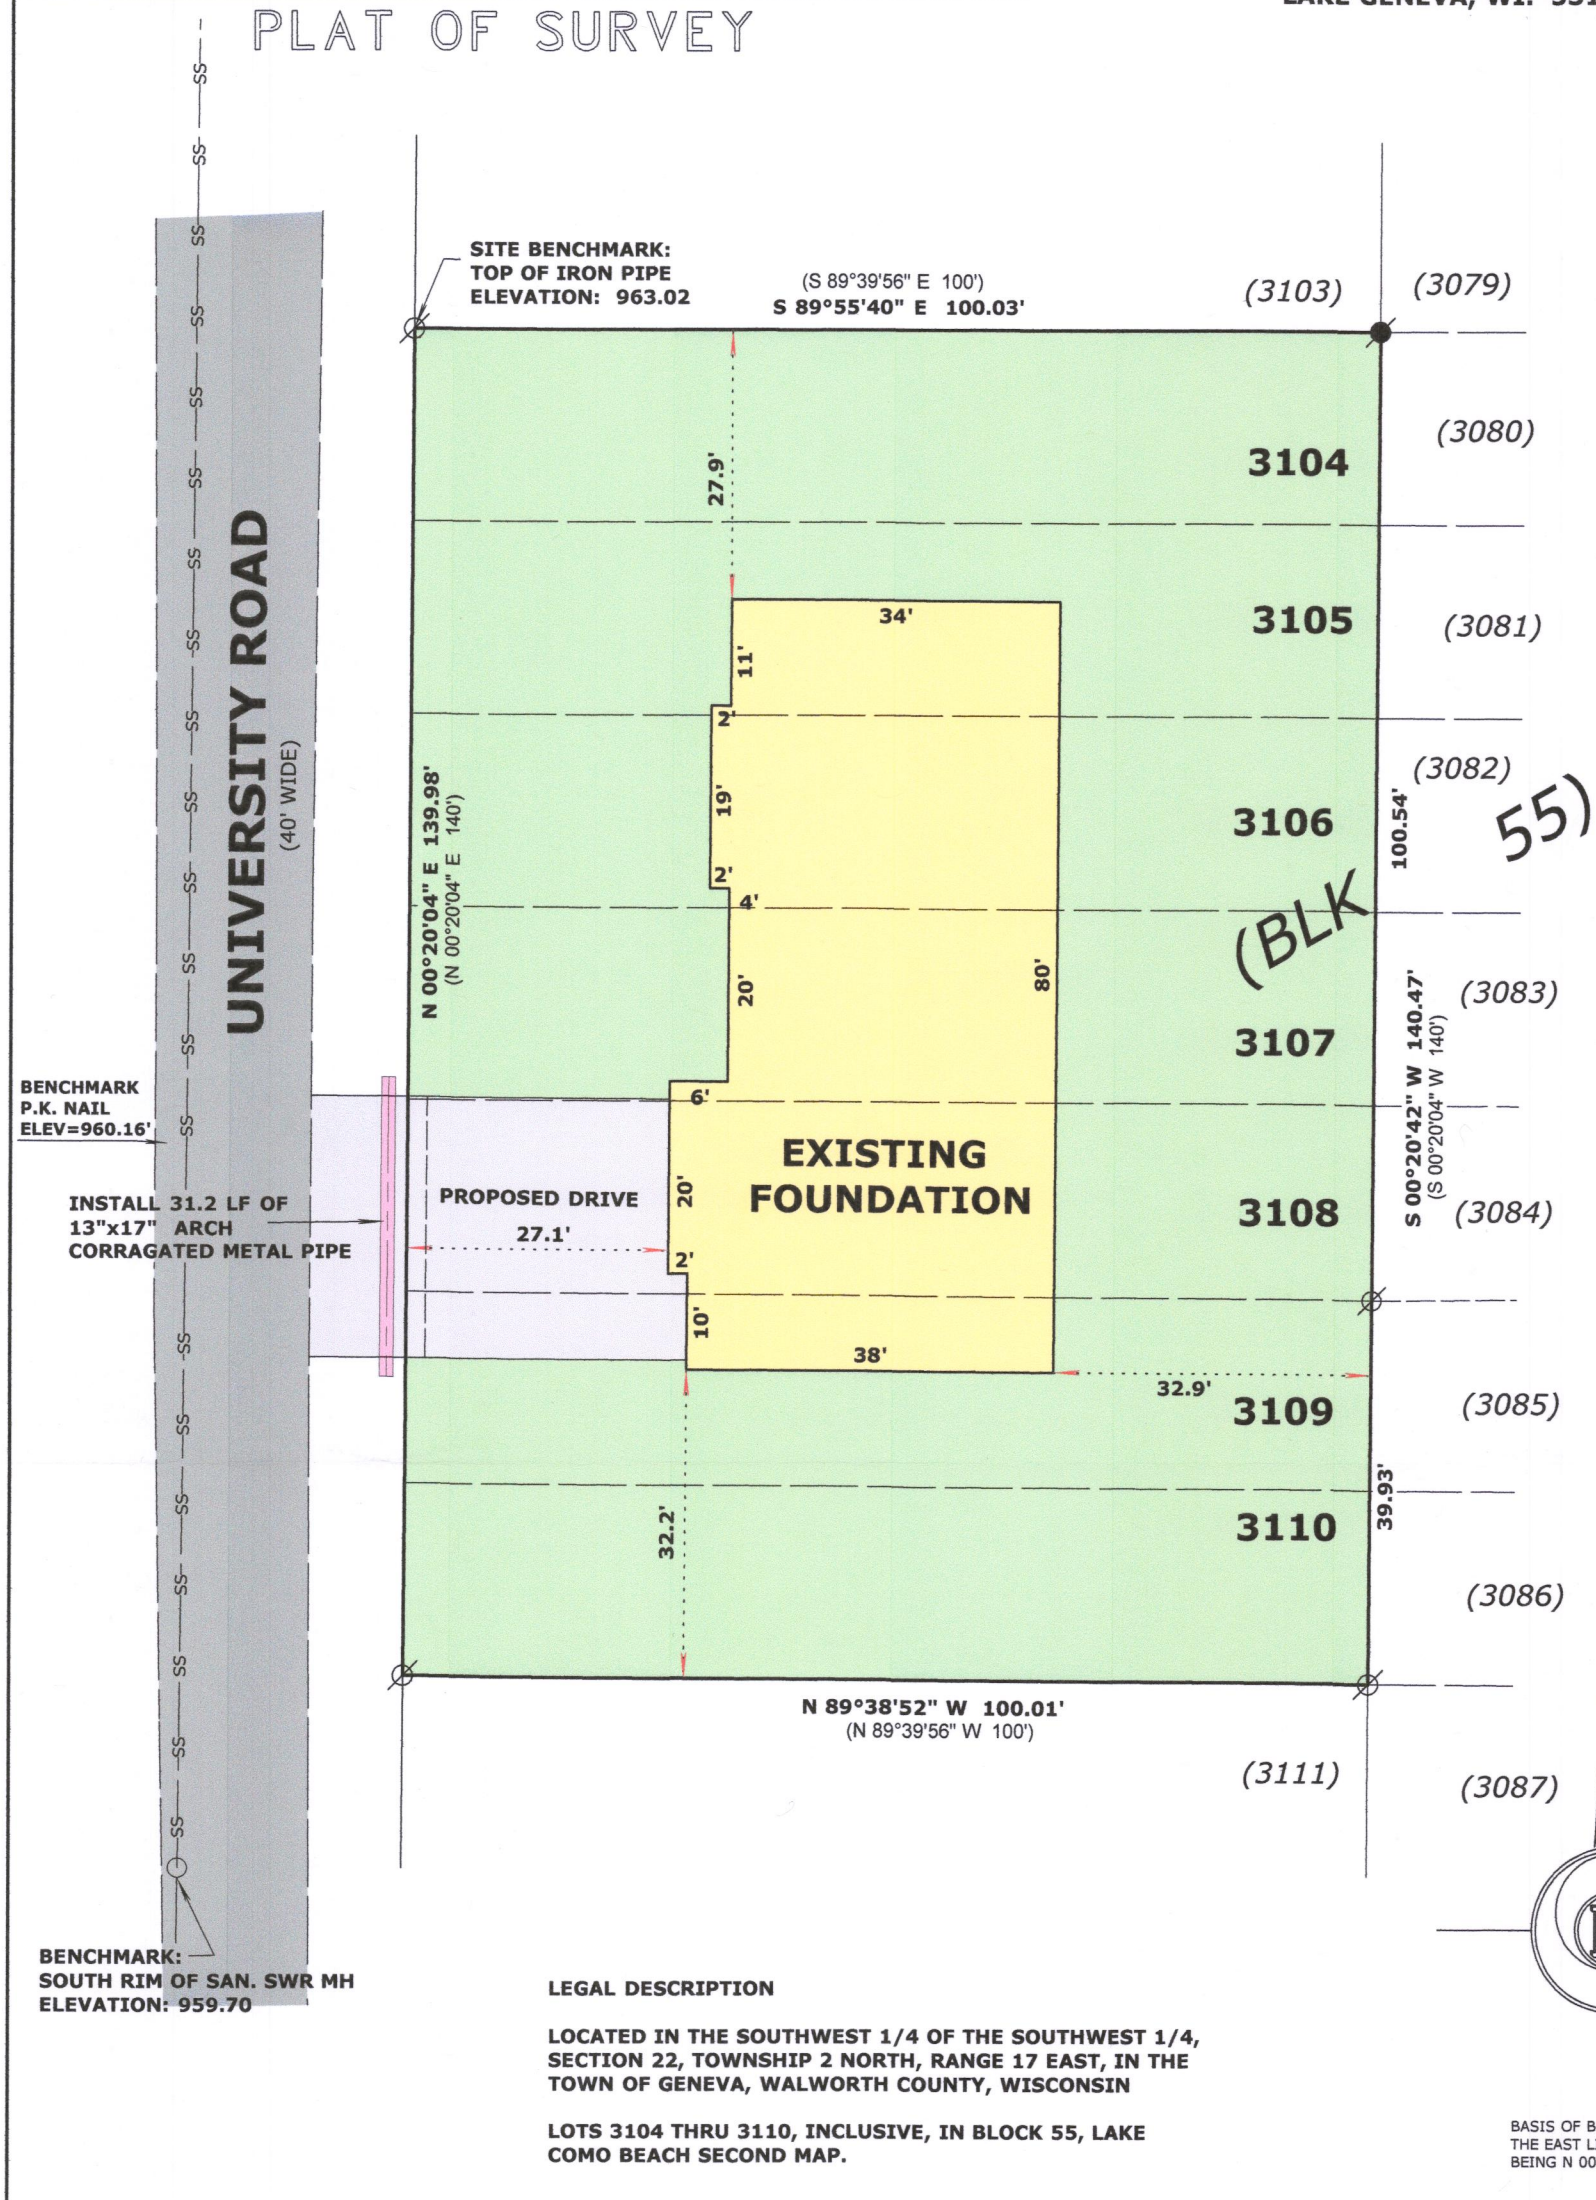


**LEGAL DESCRIPTION**

**LOCATED IN THE SOUTHWEST 1/4 OF THE SOUTHWEST 1/4, SECTION 22, TOWNSHIP 2 NORTH, RANGE 17 EAST, IN THE TOWN OF GENEVA, WALWORTH COUNTY, WISCONSIN**

**LOTS 3104 THRU 3110, INCLUSIVE, IN BLOCK 55, LAKE COMO BEACH SECOND MAP.**

BASIS OF BEARINGS:
THE EAST LINE OF UNIVERSITY RD.
BEING N 00°20'04" E

## LEGEND

- ⌀ FOUND IRON PIPE
- ● FOUND IRON ROD
- ( x x ) RECORDED AS DIMENSION

**SCALE: 1 INCH = 20 FEET**

RECEIVED
JUL 03 2018
By SMF

WISCONSIN
MARK L. MIRITZ
S-2582
WHITEWATER, WI
LAND SURVEYOR

"I hereby certify that the above described property has been surveyed by me or under my direction and that the above map is a true representation thereof and shows the size and location of the property, its exterior boundaries, the location of all visible structures and dimensions of all principal buildings thereon, boundary fences, apparent easements, roadways and visible encroachments, if any."
"This survey is made for the use of the present owners of the property, and also those who purchase, mortgage, or guarantee the title thereto within one year from date hereof."

Mark L. Miritz
**MARK L. MIRITZ**
**WISCONSIN PROFESSIONAL LAND SURVEYOR S-2582**

**REVISED APRIL 23, 2018 TO SHOW FOUNDATION "AS BUILT"**

**DATE:** December 11, 2017 **JOB NO.** 17.1204

JLCB-560

17-4463