
PLAT OF SURVEY
UNIT 20–41 OF GENEVA NATIONAL CONDOMINIUM NO. 20

LOCATED IN PART OF THE SW 1/4 OF THE NW 1/4 OF SECTION 29, TOWN 2 NORTH, RANGE 17 EAST, TOWN OF GENEVA, WALWORTH COUNTY, WISCONSIN

GRID NORTH
WISCONSIN STATE PLANE COORDINATE SYSTEM SOUTH ZONE

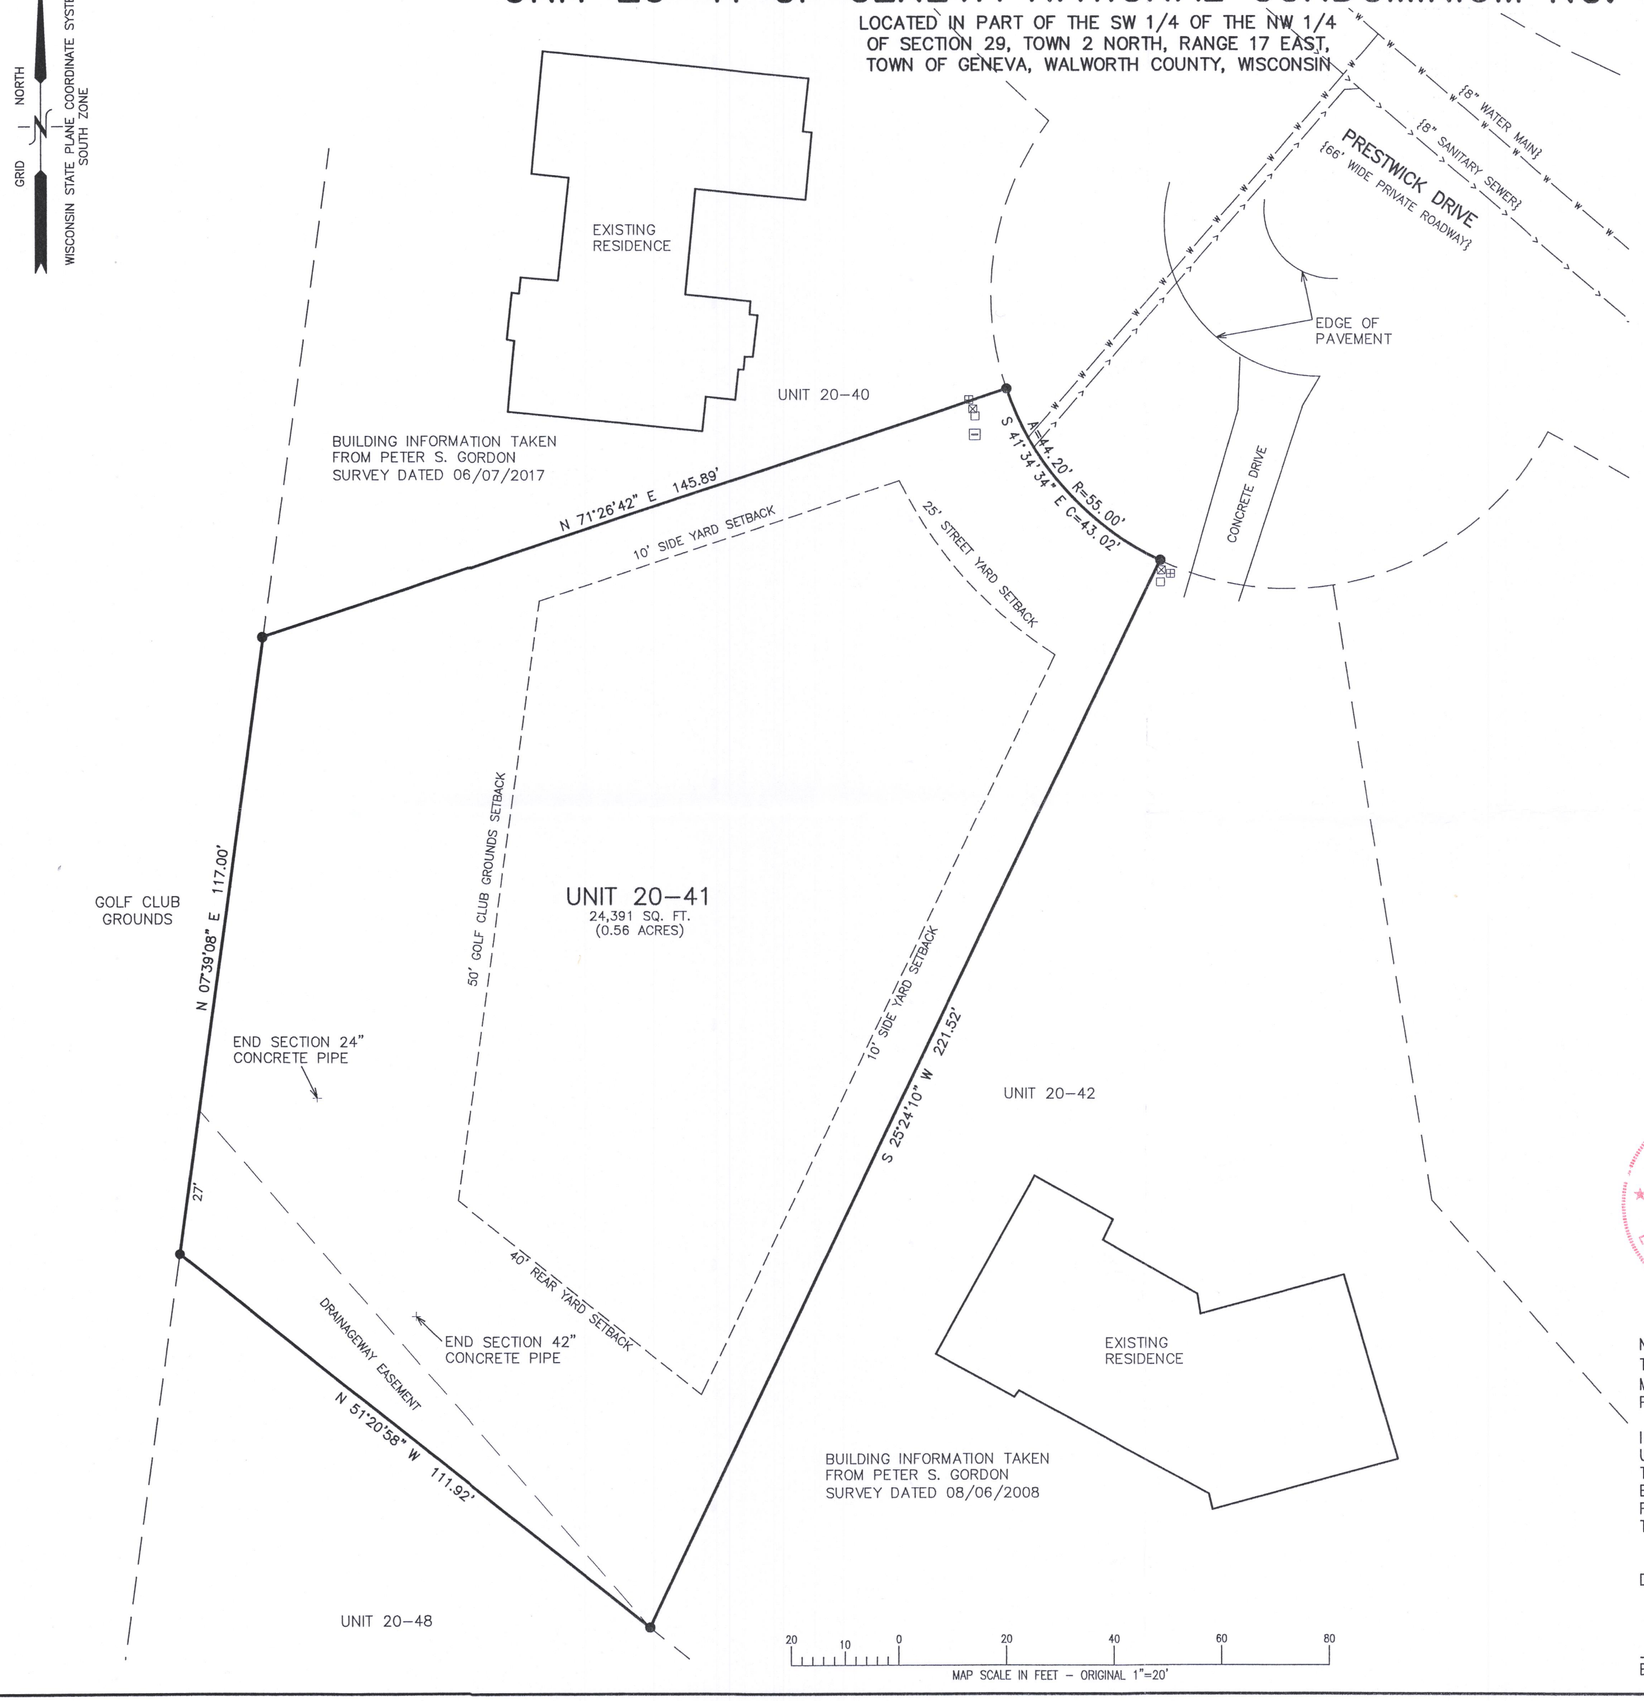

LEGEND

- ● = FOUND REBAR STAKE
- ⊠ = TELEPHONE BOX
- ⊞ = ELECTRIC BOX
- □ = CABLE BOX
- ⊟ = ELECTRIC TRANSFORMER
- {XXX} = RECORDED AS

WISCONSIN BRIAN M. CARLSON S-2039 ROCKFORD, ILL. LAND SURVEYOR

RECEIVED APR 16 2019 By Jan

NOTE: COPIES OF THIS MAP TO WHICH THE FOLLOWING CERTIFICATE WILL APPLY SHOW THE SURVEYOR'S ORIGINAL SEAL AND SIGNATURE IN RED INK. COPIES BY ANY OTHER MEANS MAY HAVE ALTERATIONS WHICH DO NOT REPRESENT THE SURVEYOR'S WORK PRODUCT.

I HEREBY CERTIFY THAT THE ABOVE DESCRIBED PROPERTY HAS BEEN SURVEYED UNDER MY DIRECTION AND THAT THE ABOVE MAP IS A TRUE REPRESENTATION THEREOF AND SHOWS THE SIZE AND LOCATION OF THE PROPERTY AND ITS EXTERIOR BOUNDARIES. THIS SURVEY IS MADE FOR THE USE OF THE PRESENT OWNERS OF THE PROPERTY, AND ALSO THOSE WHO PURCHASE, MORTGAGE, OR GUARANTEE THE TITLE THERETO WITHIN ONE YEAR FROM THE DATE HEREOF.

DATED: 03/15/2019 – RESURVEYED

BRIAN M. CARLSON P.L.S. 2039

JGN 20-41 217-4546

X:\PROJECTS\3269\CONDO_20\UNIT_41\3269_20_41_19\ACAD\3269-20-41-19.DWG

PLAT OF SURVEY
1660 PRESTWICK DRIVE
LAKE GENEVA, WI 53147

– WORK ORDERED BY –
J. PHILLIP HUTTON
14843 S. 5TH AVENUE
PHOENIX, AZ 85045

FARRIS, HANSEN & ASSOCIATES, INC.
ENGINEERING – ARCHITECTURE – SURVEYING
7 RIDGWAY COURT P.O. BOX 437
ELKHORN, WISCONSIN 53121
OFFICE: (262) 723-2098 FAX: (262) 723-5886

REVISIONS

PROJECT NO. 3269-20-41.19
DATE: 08/26/2005
SHEET NO. 1 OF 1