
# PLAT OF SURVEY & TOPOGRAPHIC MAPPING
## UNIT 56–03 GENEVA NATIONAL CONDOMINIUM NO. 56

LOCATED IN PART OF THE SE 1/4 OF THE NE 1/4
OF SECTION 31, TOWN 2 NORTH, RANGE 17 EAST,
TOWN OF GENEVA, WALWORTH COUNTY, WISCONSIN

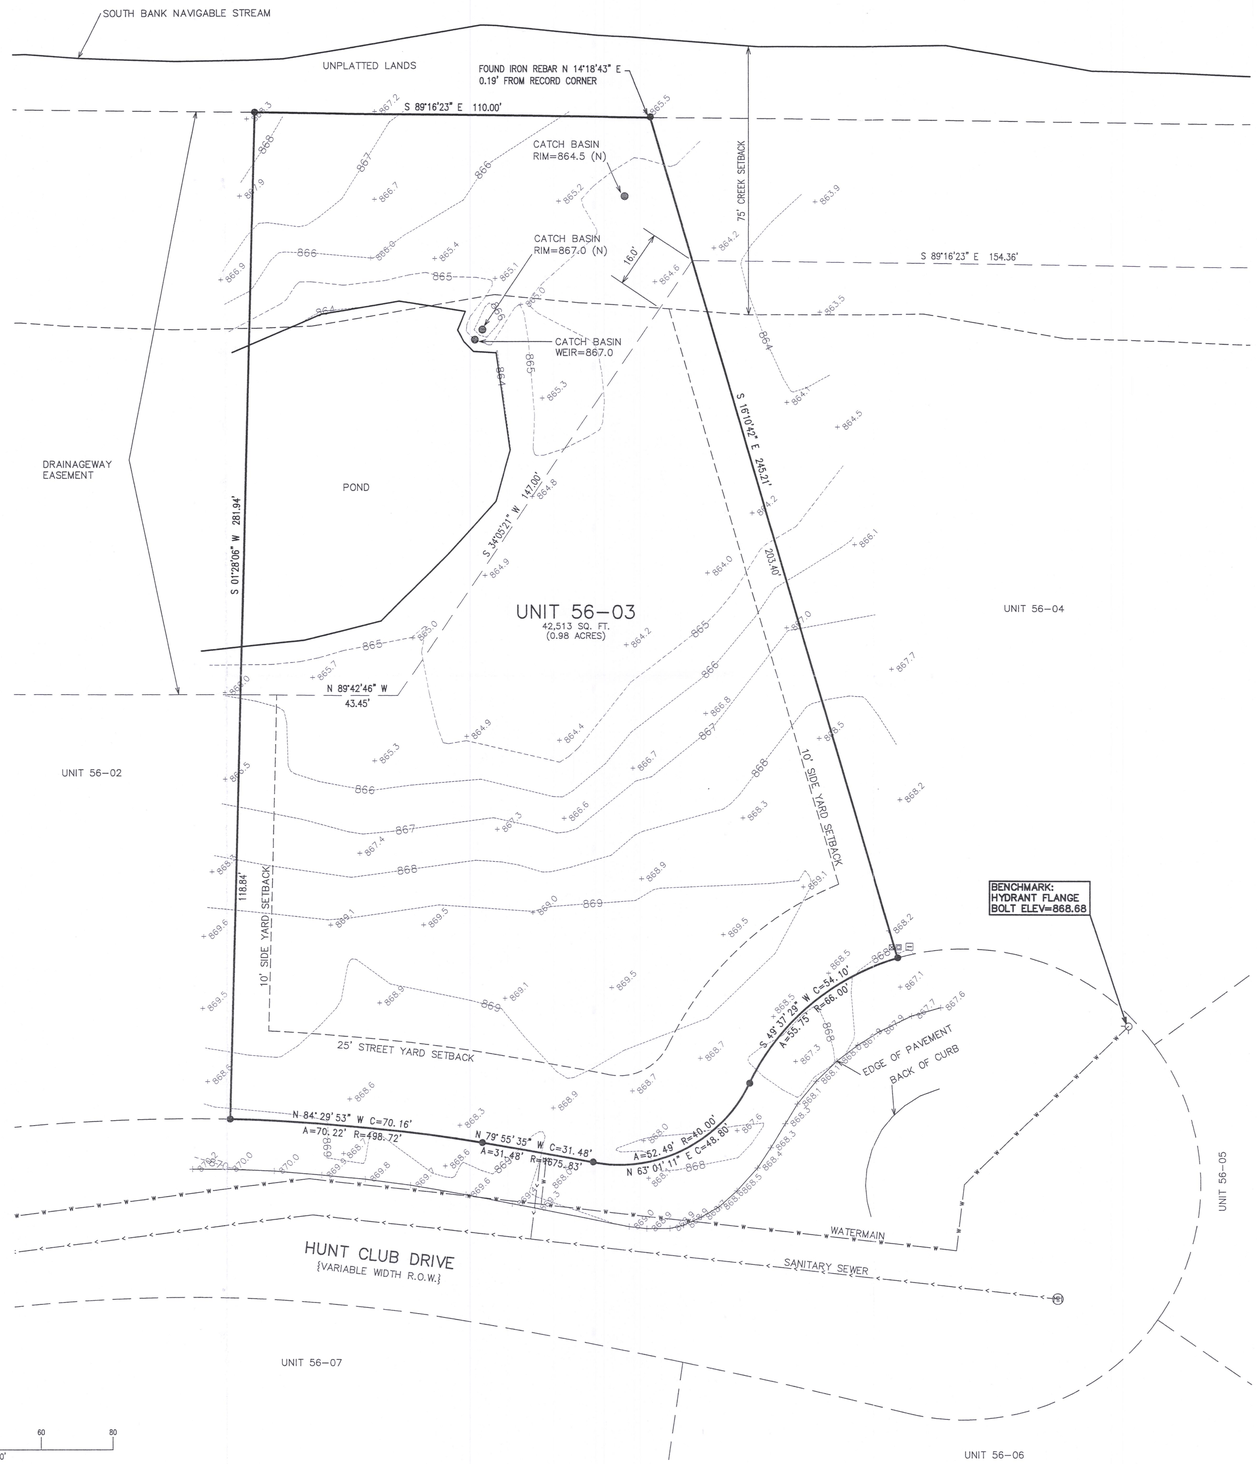


### LEGEND

- ● = FOUND REBAR STAKE
- ☿ = HYDRANT
- ⋈ = WATER VALVE
- (SS) = SANITARY SEWER MANHOLE
- ● = CATCH BASIN
- ⊠ = TELEPHONE BOX
- ⊡ = CABLE BOX
- ⊟ = ELECTRIC TRANSFORMER
- {XXX} = RECORDED AS
- +XXX.X = EXISTING GROUND ELEVATION
- ----XXXX---- = EXISTING LAND CONTOURS

RECEIVED
JUL 9 2019
By

NOTE: COPIES OF THIS MAP TO WHICH THE FOLLOWING CERTIFICATE WILL APPLY SHOW THE SURVEYOR'S ORIGINAL SEAL AND SIGNATURE IN RED INK. COPIES BY ANY OTHER MEANS MAY HAVE ALTERATIONS WHICH DO NOT REPRESENT THE SURVEYOR'S WORK PRODUCT.

I HEREBY CERTIFY THAT THE ABOVE DESCRIBED PROPERTY HAS BEEN SURVEYED UNDER MY DIRECTION AND THAT THE ABOVE MAP IS A TRUE REPRESENTATION THEREOF AND SHOWS THE SIZE AND LOCATION OF THE PROPERTY AND ITS EXTERIOR BOUNDARIES. THIS SURVEY IS MADE FOR THE USE OF THE PRESENT OWNERS OF THE PROPERTY, AND ALSO THOSE WHO PURCHASE, MORTGAGE, OR GUARANTEE THE TITLE THERETO WITHIN ONE YEAR FROM THE DATE HEREOF.

DATED: 05/22/2019

BRIAN M. CARLSON P.L.S. 2039

WISCONSIN
BRIAN M. CARLSON
S-2039
ROCKFORD, ILL.
LAND SURVEYOR

TOPOGRAPHIC SURVEY
UNIT 56–03 ON HUNT CLUB DRIVE
LAKE GENEVA, WI 53147

– WORK ORDERED BY –
LOWELL CUSTOM HOMES
401 GENEVA NATIONAL AVENUE SUITE 6
LAKE GENEVA, WI 53147


FARRIS, HANSEN & ASSOCIATES, INC.
ENGINEERING – ARCHITECTURE – SURVEYING
7 RIDGWAY COURT P.O. BOX 437
ELKHORN, WISCONSIN 53121
OFFICE: (262) 723–2098 FAX: (262) 723–5886


REVISIONS
05/22/2019 – LB
TOPO. SURVEY

PROJECT NO.
3269–56–03

DATE
05/22/2019

SHEET NO.
1 OF 1

X:\PROJECTS\3269\CONDO_56\NOVLOTS\UNIT_03\ACAD\3269–56–03.DWG

JGN 50-3 217-4559