


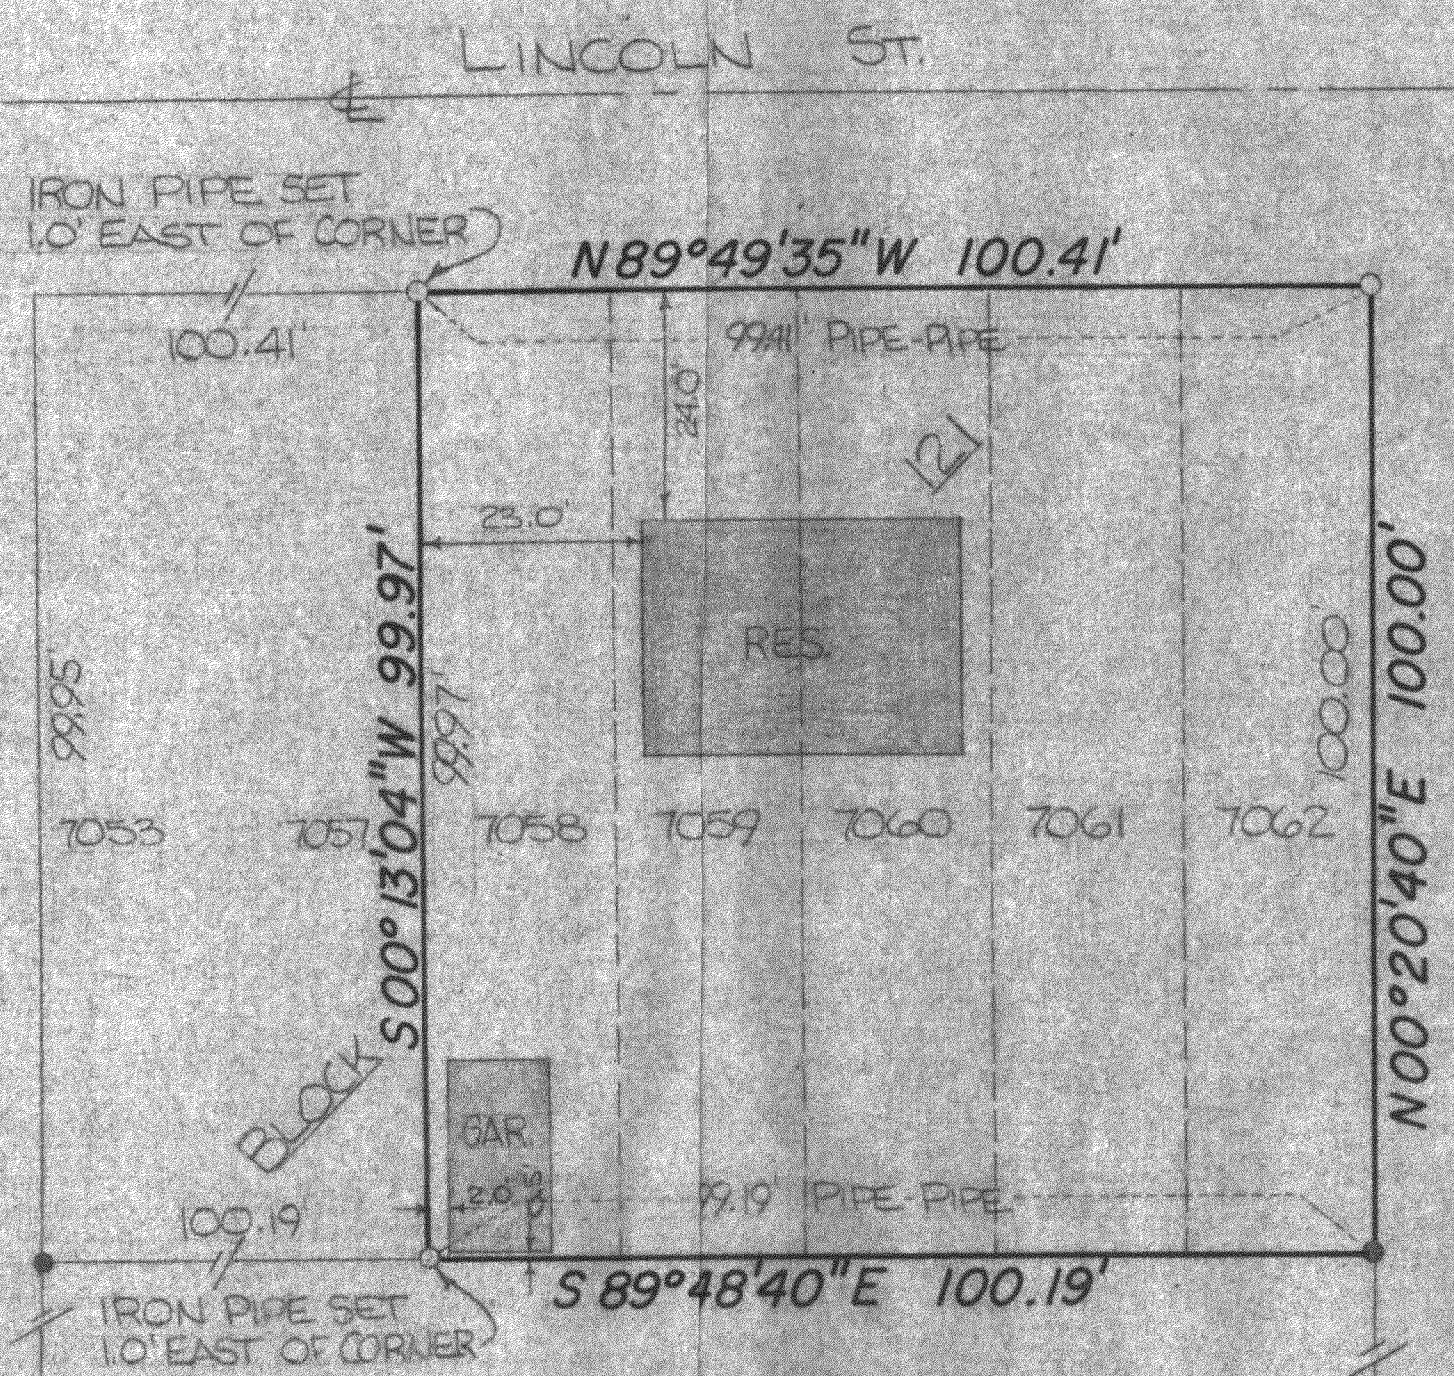


LEGEND
 ● IRON PIPE FOUND
 ○ IRON PIPE SET

DESCRIPTION
 LOTS 7058, 7059, 7060, 7061, & 7062 OF LAKE COMO BEACH A SUBDIVISION LOCATED IN T2N R1E, WALWORTH COUNTY, WISCONSIN.

CERTIFICATE
 I, JOSEPH M. BIAGI, SURVEYOR DO HEREBY CERTIFY THAT I HAVE SURVEYED THE LAND HEREON DESCRIBED.

DATE:
 SEPTEMBER 5, 1975

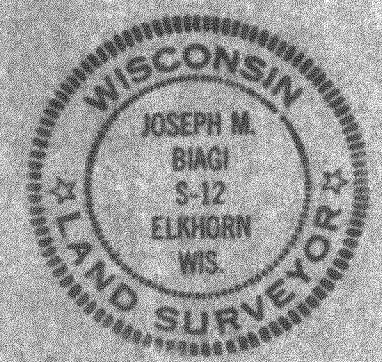

Joseph M. Biagi
 JOSEPH M. BIAGI S-12

REVISIONS			LOTS 7058-7062 LAKE COMO		
NO.	DATE	BY	BEACH SUBDIVISION		
1					
2					
3			DRAWN BY	SCALE 1"=20'	MATERIAL
4			CHK'D	DATE 9-5-75	DRAWING NO.
5			TRACED	APP'D	90-75