
HAROLD H. KOLB

REGISTERED PROFESSIONAL LAND SURVEYOR

LAKE GENEVA, WISCONSIN

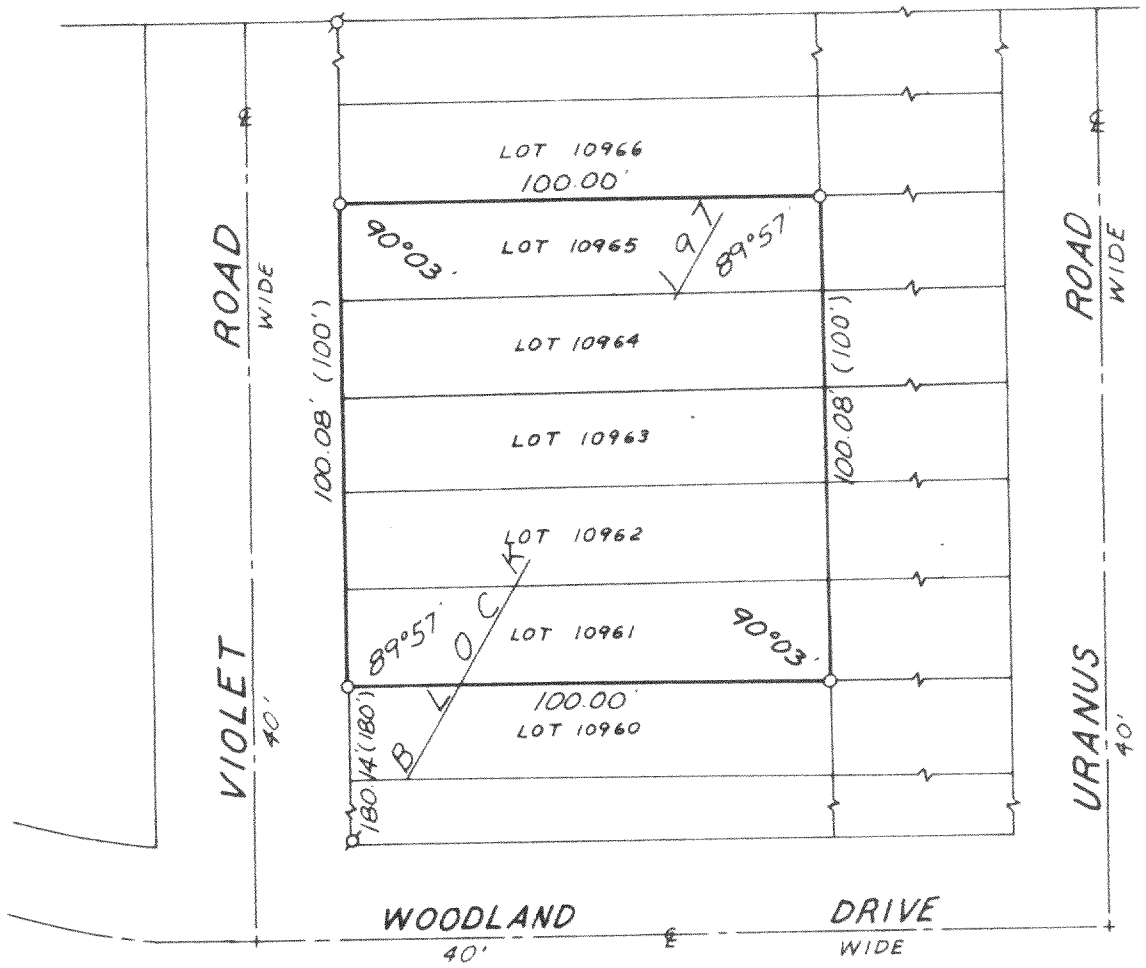

PLAT OF SURVEY OF

LOTS 10961-10965, BLOCK 197, LAKE COMO BEACH SUBDIVISION, WALWORTH COUNTY, WISCONSIN.

ORDERED BY: BRUCE HUNT
ROUTE 2--BOX 335-R
LAKE GENEVA, WI 53147

N

Scale 1" = 40'

LEGEND

O — IRON PIPE PLACED. 1" x 24" 1.13 LB./LIN. FT.

● — CONCRETE MONUMENT. 5" DIA. x 30"

I, HAROLD H. KOLB, DO HEREBY CERTIFY THAT I HAVE SURVEYED THE PROPERTY HEREON DESCRIBED ACCORDING TO THE OFFICIAL RECORDS, AND THAT THE PLAT HEREON IS A CORRECT REPRESENTATION OF THE LOT LINES.

Harold H. Kolb

HAROLD H. KOLB
WISCONSIN REGISTERED LAND SURVEYOR, S-187

DATE OCTOBER 12, 1978

BRUNING 40-105 1M-6-71 LLCB-2352

217-462K