
LAND-MARK SURVEYING
Mark L. Miritz
Wisconsin Professional Land Surveyor S-2582

N9330 Knuteson Drive
Whitewater, WI 53190
Phone:(262)495-3284
MARKMIRITZ@
LAND-MARKSURVEYING.COM

PLAT OF SURVEY

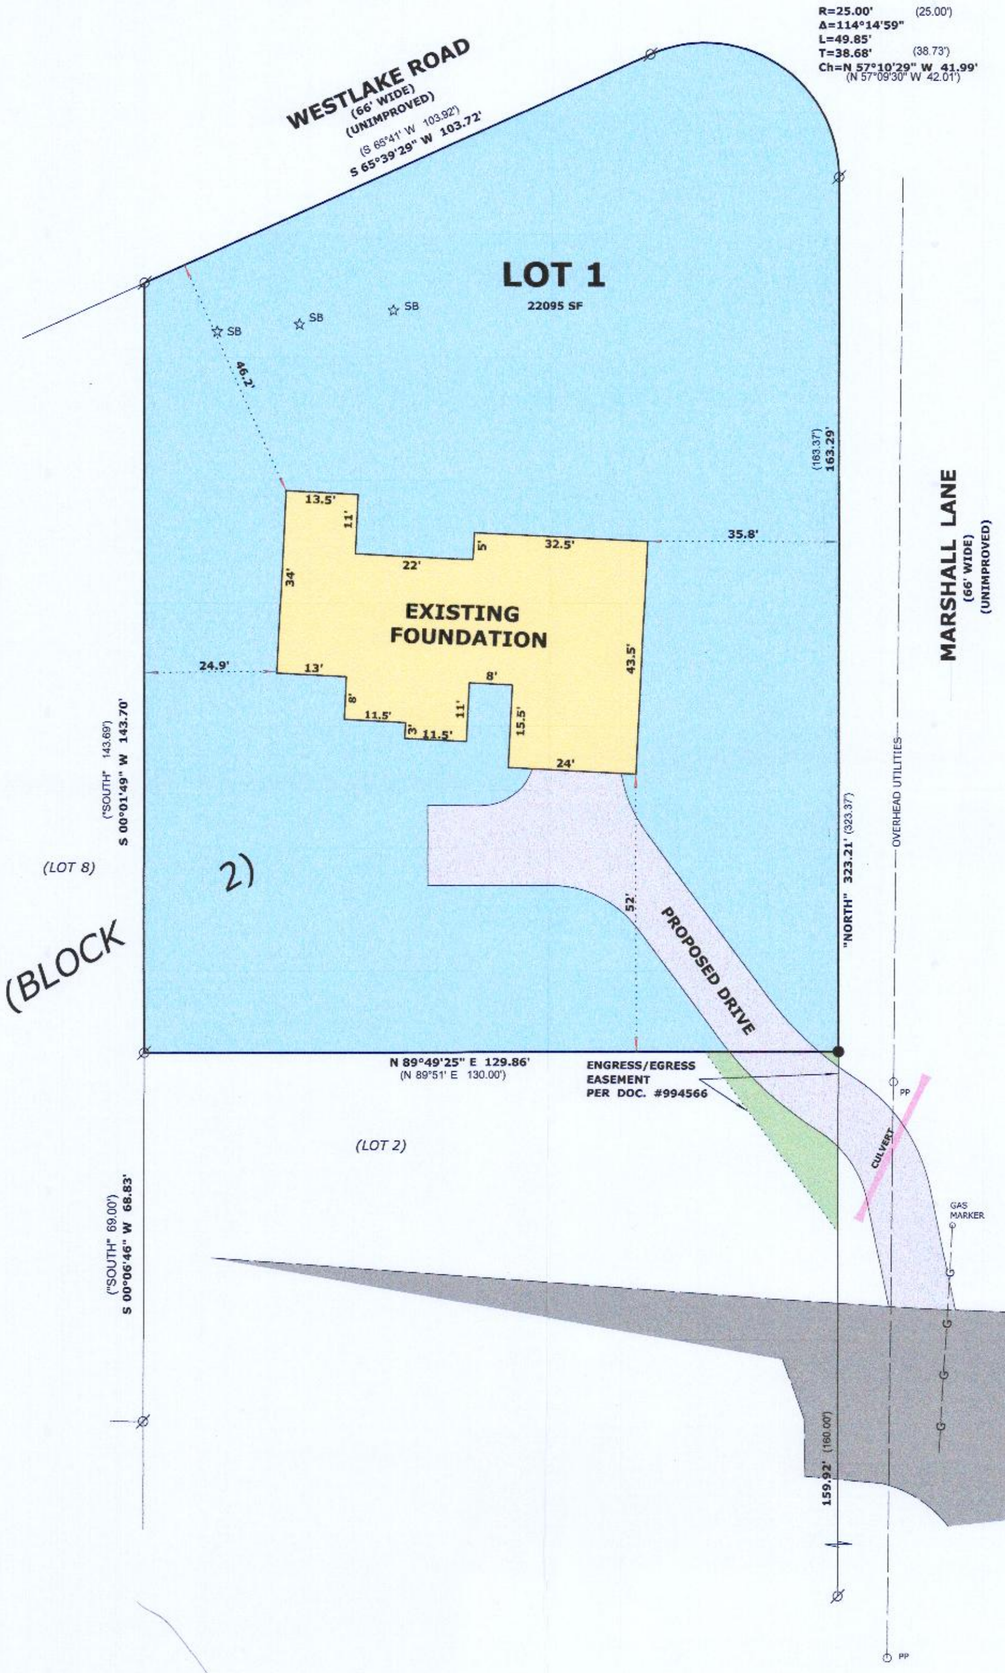

LEGAL DESCRIPTION:

LOCATED IN THE SOUTHEAST 1/4 OF THE NORTHWEST 1/4, SECTION 26, TOWNSHIP 2 NORTH, RANGE 17 EAST, IN THE TOWN OF GENEVA, WALWORTH COUNTY, WISCONSIN

LOT 1, BLOCK 2, HAWTHORNE HILLS SUBDIVISION

BASIS OF BEARINGS:
The West Line of Marshall Lane
Being "NORTH"

VERTICAL DATUM
To adjust elevations shown to the 1983 Vertical Datum
Add 114.00 feet to all elevations shown.

OWNER:
JOEL LAZZARONI
N4236 COUNTY RD. NN
ELKHORN, WI. 53121

RECEIVED
APR 28 2020
By

LEGEND

- ∅ FOUND IRON PIPE
- ● SET IRON ROD, 18" LONG, WEIGHING 1.5 LBS./LINEAL FT., 3/4" DIA.
- (x x) RECORDED AS DIMENSION

SCALE: 1 INCH= 20 FEET

"I hereby certify that the above described property has been surveyed by me or under my direction and that the above map is a true representation thereof and shows the size and location of the property, its exterior boundaries, the location of all visible structures and dimensions of all principal buildings thereon, boundary fences, apparent easements, roadways and visible encroachments, if any." "This survey is made for the use of the present owners of the property, and also those who purchase, mortgage, or guarantee the title thereto within one year from date hereof."

WISCONSIN
MARK L. MIRITZ
S-2582
WHITEWATER, WI
LAND SURVEYOR

Mark L. Miritz
MARK L. MIRITZ
WISCONSIN PROFESSIONAL
LAND SURVEYOR S-2582

REVISED DEC. 23, 2019 TO SHOW FOUNDATION "AS BUILT"

DATE: September 12, 2019 JOB NO. 19.812

JHH-9

217-4638