LAND-MARK SURVEYING
Mark L. Miritz
Wisconsin Professional Land Surveyor S-2582


N9330 Knuteson Drive
Whitewater, WI 53190
Phone:(262)495-3284
MarkMiritz@
Land-MarkSurveying.com

PLAT OF SURVEY

LEGAL DESCRIPTION

LOCATED IN THE NORTHEAST 1/4 OF THE NORTHWEST 1/4, SECTION 28, TOWNSHIP 2 NORTH, RANGE 17 EAST, IN THE TOWN OF GENEVA, WALWORTH COUNTY, WISCONSIN.

LOTS 6573 THRU 6580 (INCLUSIVE), BLOCK 113, LAKE COMO BEACH

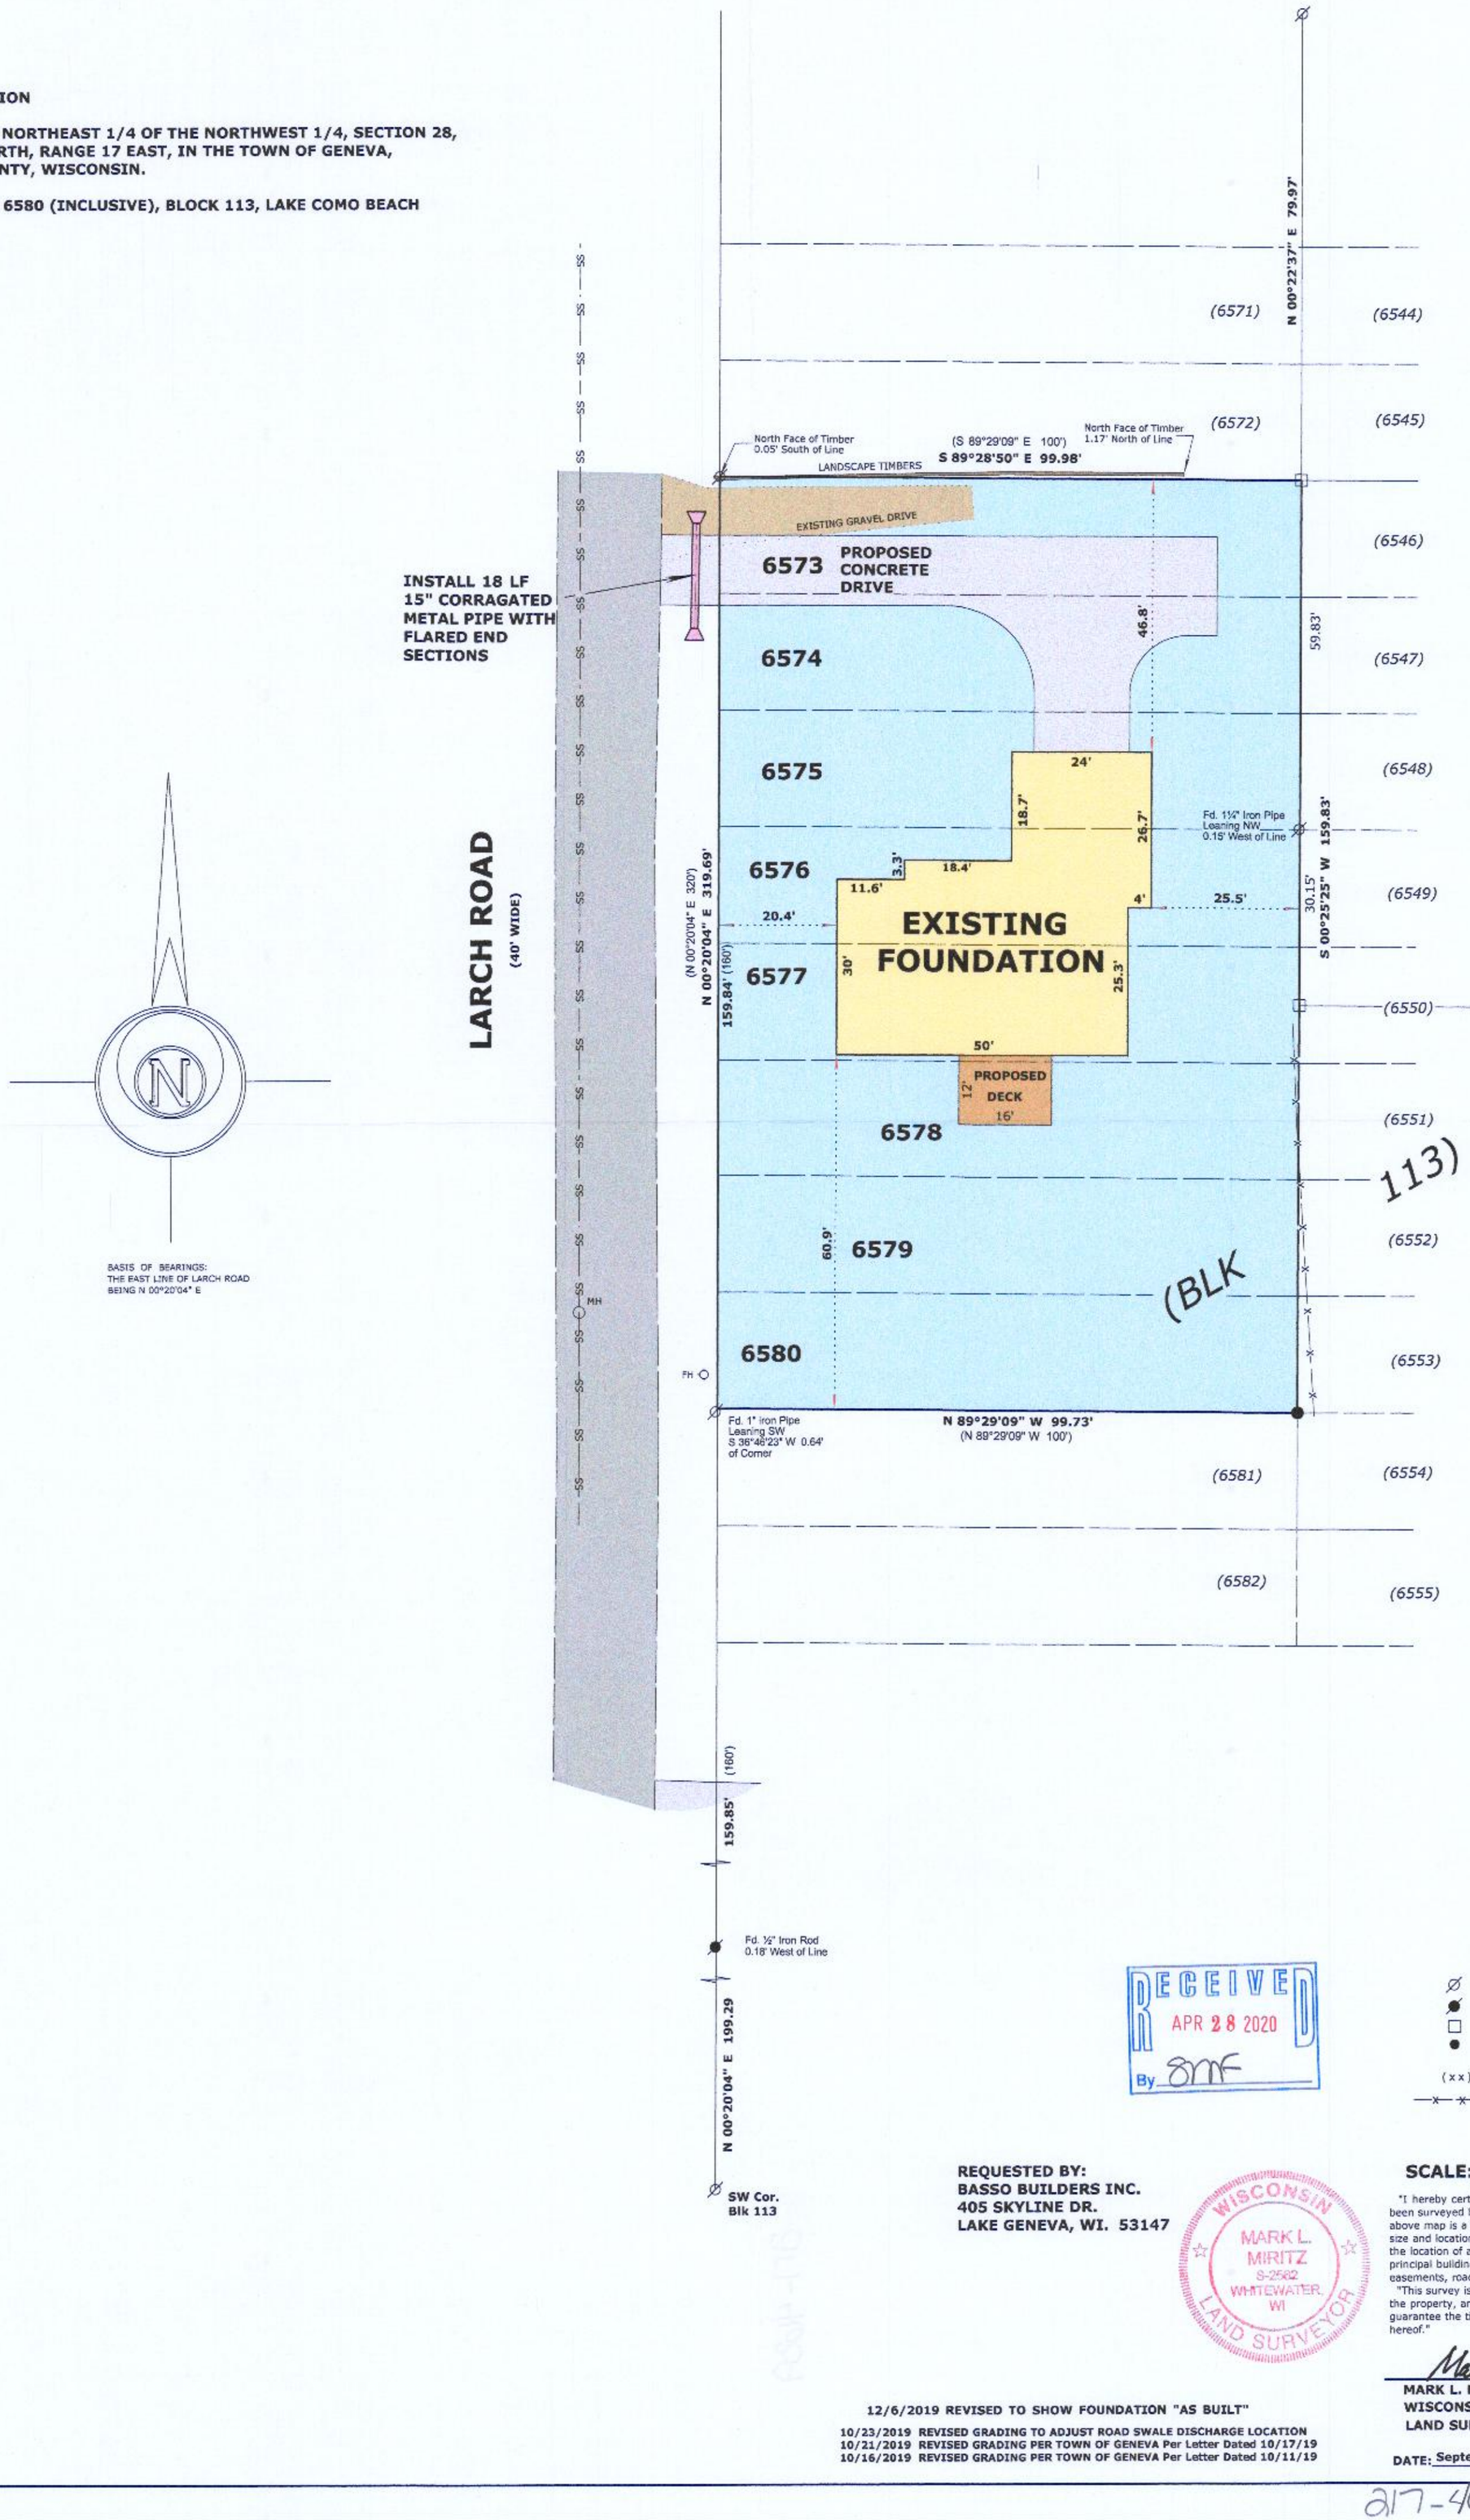

BASIS OF BEARINGS:
THE EAST LINE OF LARCH ROAD
BEING N 00°20'04" E

RECEIVED
APR 28 2020
By

LEGEND

- FOUND IRON PIPE
- FOUND IRON ROD
- FOUND CONCRETE MONUMENT
- SET IRON ROD, 18" LONG, WEIGHING 1.5 LBS./LINEAL FT., 3/4" DIA.
- (x x) RECORDED AS DIMENSION
- —x—x— EXISTING FENCE

REQUESTED BY:
BASSO BUILDERS INC.
405 SKYLINE DR.
LAKE GENEVA, WI. 53147

WISCONSIN
MARK L. MIRITZ
S-2582
WHITEWATER, WI
LAND SURVEYOR

SCALE: 1 INCH = 20 FEET

"I hereby certify that the above described property has been surveyed by me or under my direction and that the above map is a true representation thereof and shows the size and location of the property, its exterior boundaries, the location of all visible structures and dimensions of all principal buildings thereon, boundary fences, apparent easements, roadways and visible encroachments, if any."
"This survey is made for the use of the present owners of the property, and also those who purchase, mortgage, or guarantee the title thereto within one year from date hereof."

Mark L. Miritz

MARK L. MIRITZ
WISCONSIN PROFESSIONAL
LAND SURVEYOR S-2582

12/6/2019 REVISED TO SHOW FOUNDATION "AS BUILT"
10/23/2019 REVISED GRADING TO ADJUST ROAD SWALE DISCHARGE LOCATION
10/21/2019 REVISED GRADING PER TOWN OF GENEVA Per Letter Dated 10/17/19
10/16/2019 REVISED GRADING PER TOWN OF GENEVA Per Letter Dated 10/11/19

DATE: September 25, 2019 **JOB NO. 19.902**

JLCB - 1373

217-4639