LAND-MARK SURVEYING
Mark L. Miritz
Wisconsin Professional Land Surveyor S-2582

N9330 Knuteson Drive
Whitewater, WI 53190
Phone:(262)495-3284
MarkMiritz@
Land-MarkSurveying.com

PLAT OF SURVEY

LEGAL DESCRIPTION

LOCATED IN THE NORTHEAST 1/4 OF THE NORTHWEST 1/4, SECTION 28, TOWNSHIP 2 NORTH, RANGE 17 EAST, IN THE TOWN OF GENEVA, WALWORTH COUNTY, WISCONSIN.

LOTS 6573 THRU 6580 (INCLUSIVE), BLOCK 113, LAKE COMO BEACH

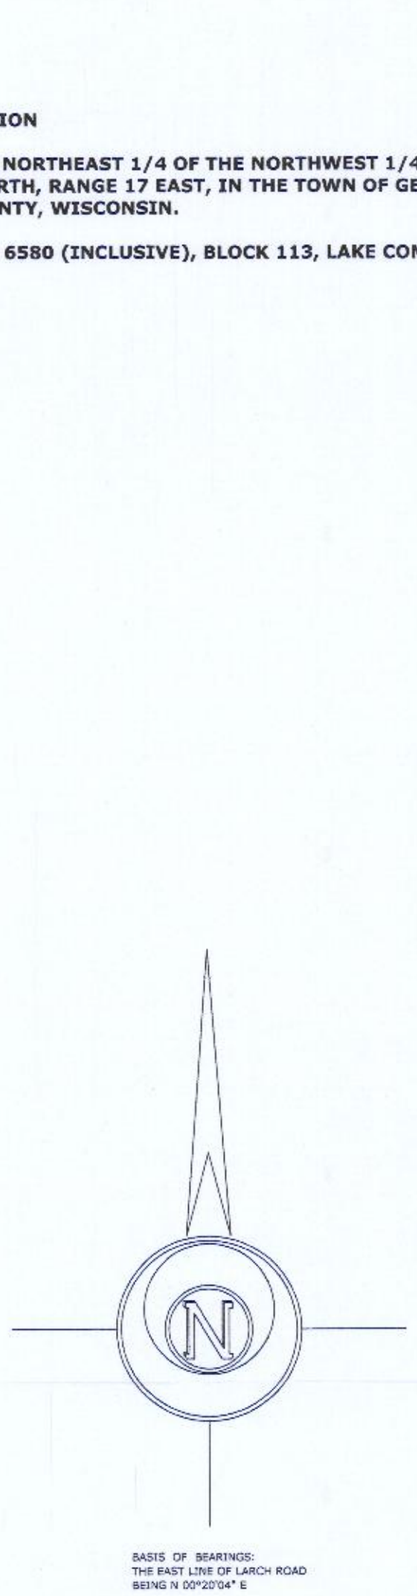

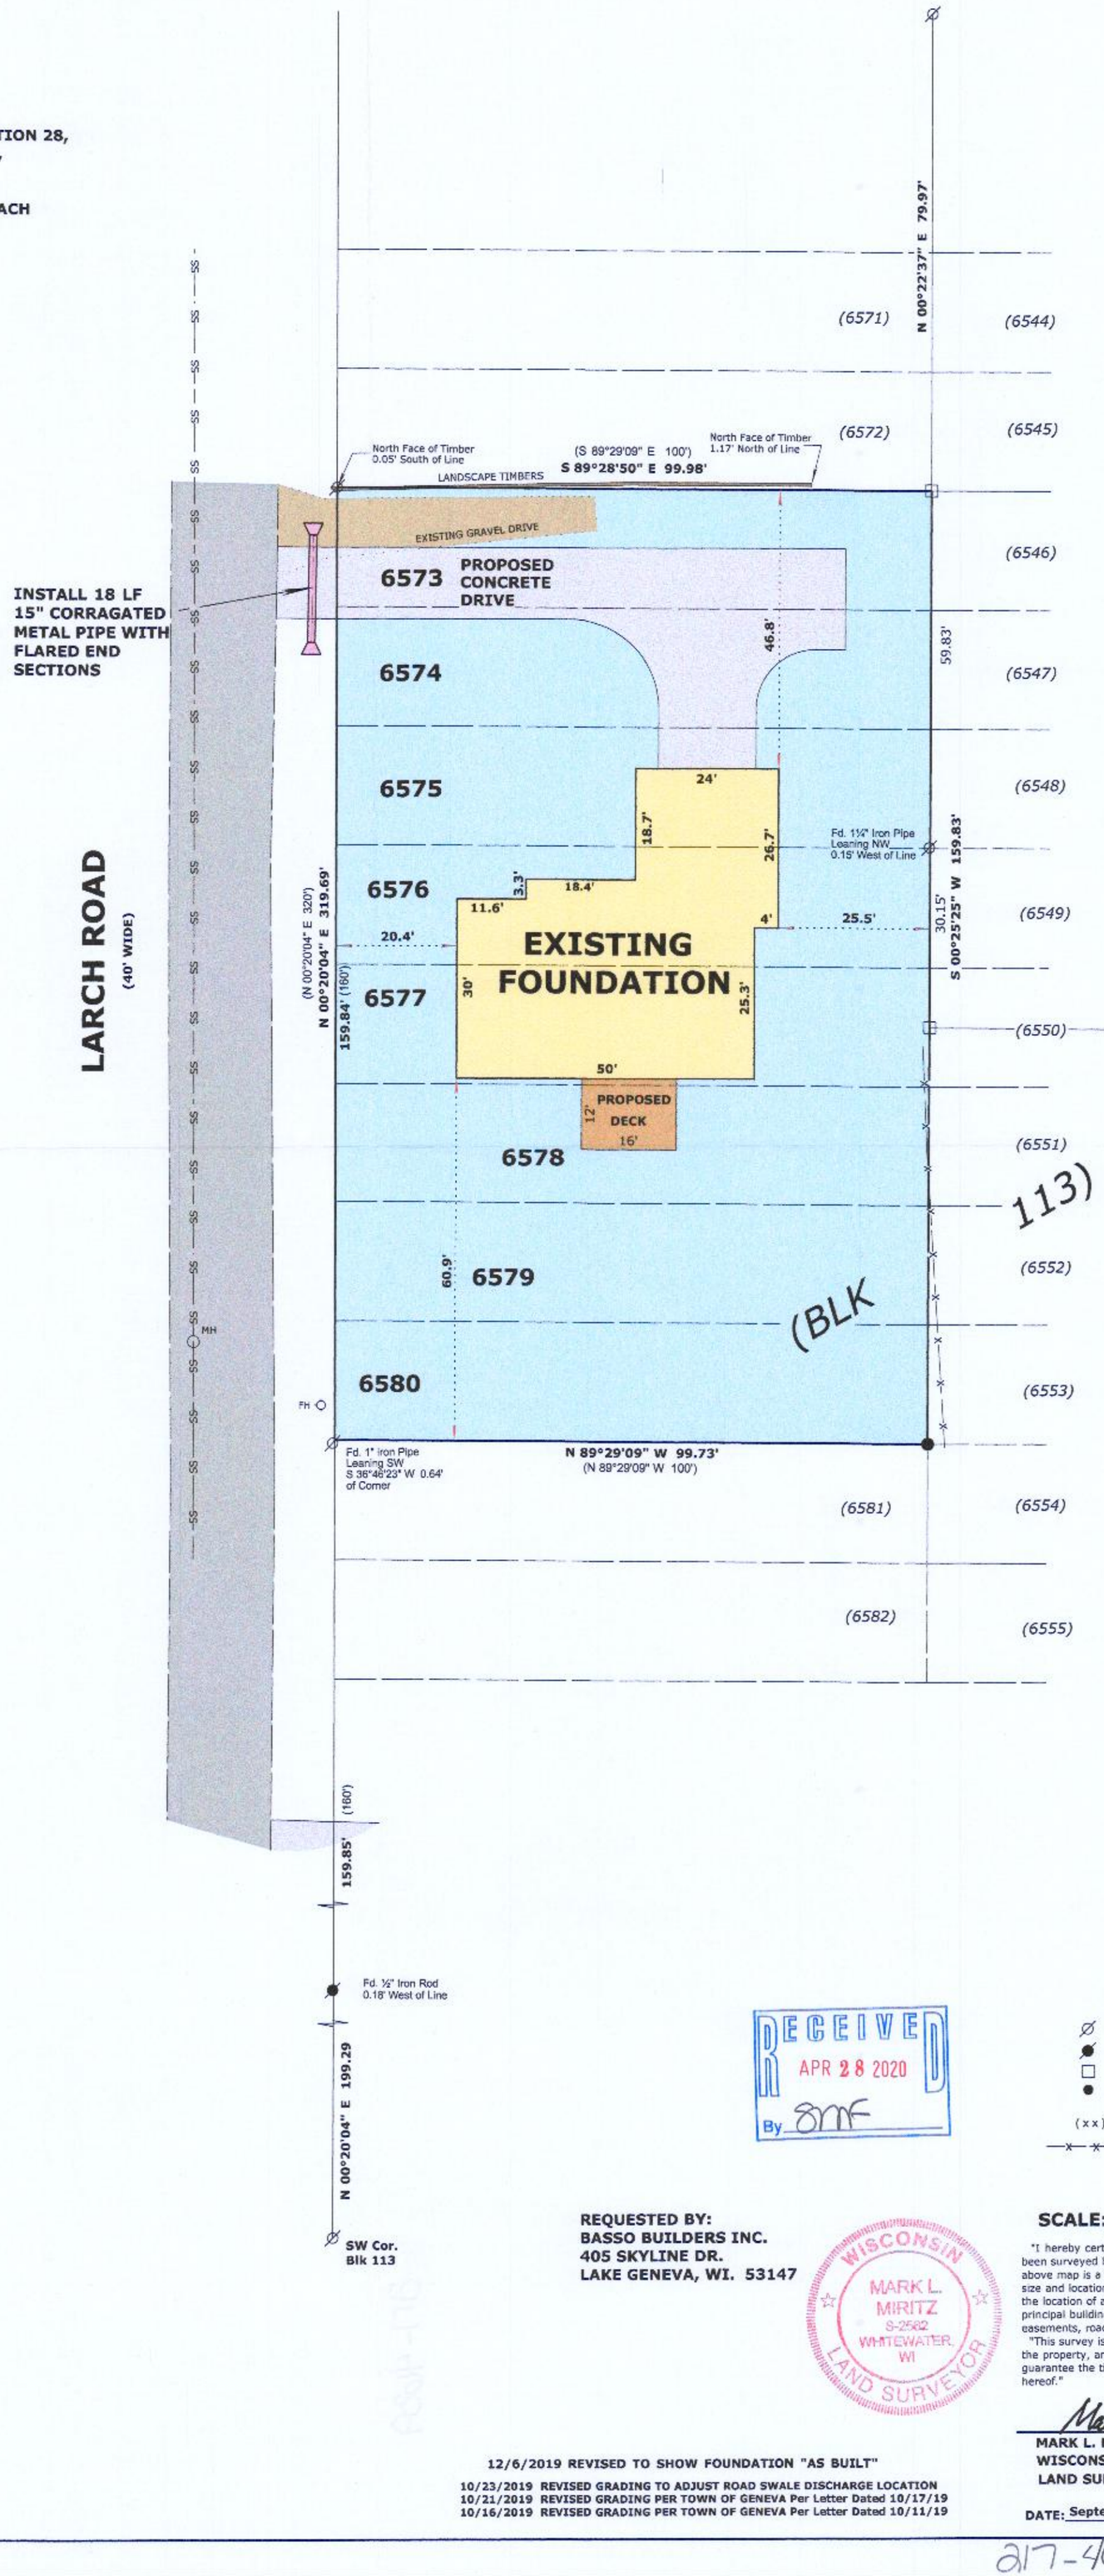

RECEIVED
APR 28 2020
By SMF

REQUESTED BY:
BASSO BUILDERS INC.
405 SKYLINE DR.
LAKE GENEVA, WI. 53147

LEGEND

- Ø — FOUND IRON PIPE
- ● — FOUND IRON ROD
- □ — FOUND CONCRETE MONUMENT
- ● — SET IRON ROD, 18" LONG, WEIGHING 1.5 LBS./LINEAL FT., 3/4" DIA.
- (xx) — RECORDED AS DIMENSION
- —x—x— — EXISTING FENCE

SCALE: 1 INCH = 20 FEET

"I hereby certify that the above described property has been surveyed by me or under my direction and that the above map is a true representation thereof and shows the size and location of the property, its exterior boundaries, the location of all visible structures and dimensions of all principal buildings thereon, boundary fences, apparent easements, roadways and visible encroachments, if any."
"This survey is made for the use of the present owners of the property, and also those who purchase, mortgage, or guarantee the title thereto within one year from date hereof."

WISCONSIN MARK L. MIRITZ S-2582 WHITEWATER, WI LAND SURVEYOR

Mark L. Miritz

MARK L. MIRITZ
WISCONSIN PROFESSIONAL
LAND SURVEYOR S-2582

DATE: September 25, 2019 **JOB NO. 19.902**

12/6/2019 REVISED TO SHOW FOUNDATION "AS BUILT"
10/23/2019 REVISED GRADING TO ADJUST ROAD SWALE DISCHARGE LOCATION
10/21/2019 REVISED GRADING PER TOWN OF GENEVA Per Letter Dated 10/17/19
10/16/2019 REVISED GRADING PER TOWN OF GENEVA Per Letter Dated 10/11/19

JLCB - 1373

217-4639