
PLAT OF SURVEY
–OF–

LOTS 10648 THROUGH 10652, BLOCK 193 AND LOTS 10658 THROUGH 10661, BLOCK 193 ALL IN THE FIFTH MAP OF LAKE COMO BEACH, TOWN OF GENEVA, WALWORTH COUNTY, WISCONSIN.

SURVEY FOR: ERIK SEAVER
SURVEY ADDRESS: W4086 LAKE SHORE DRIVE

TOTAL IMPERVIOUS SURFACE
6,303 sq. ft.

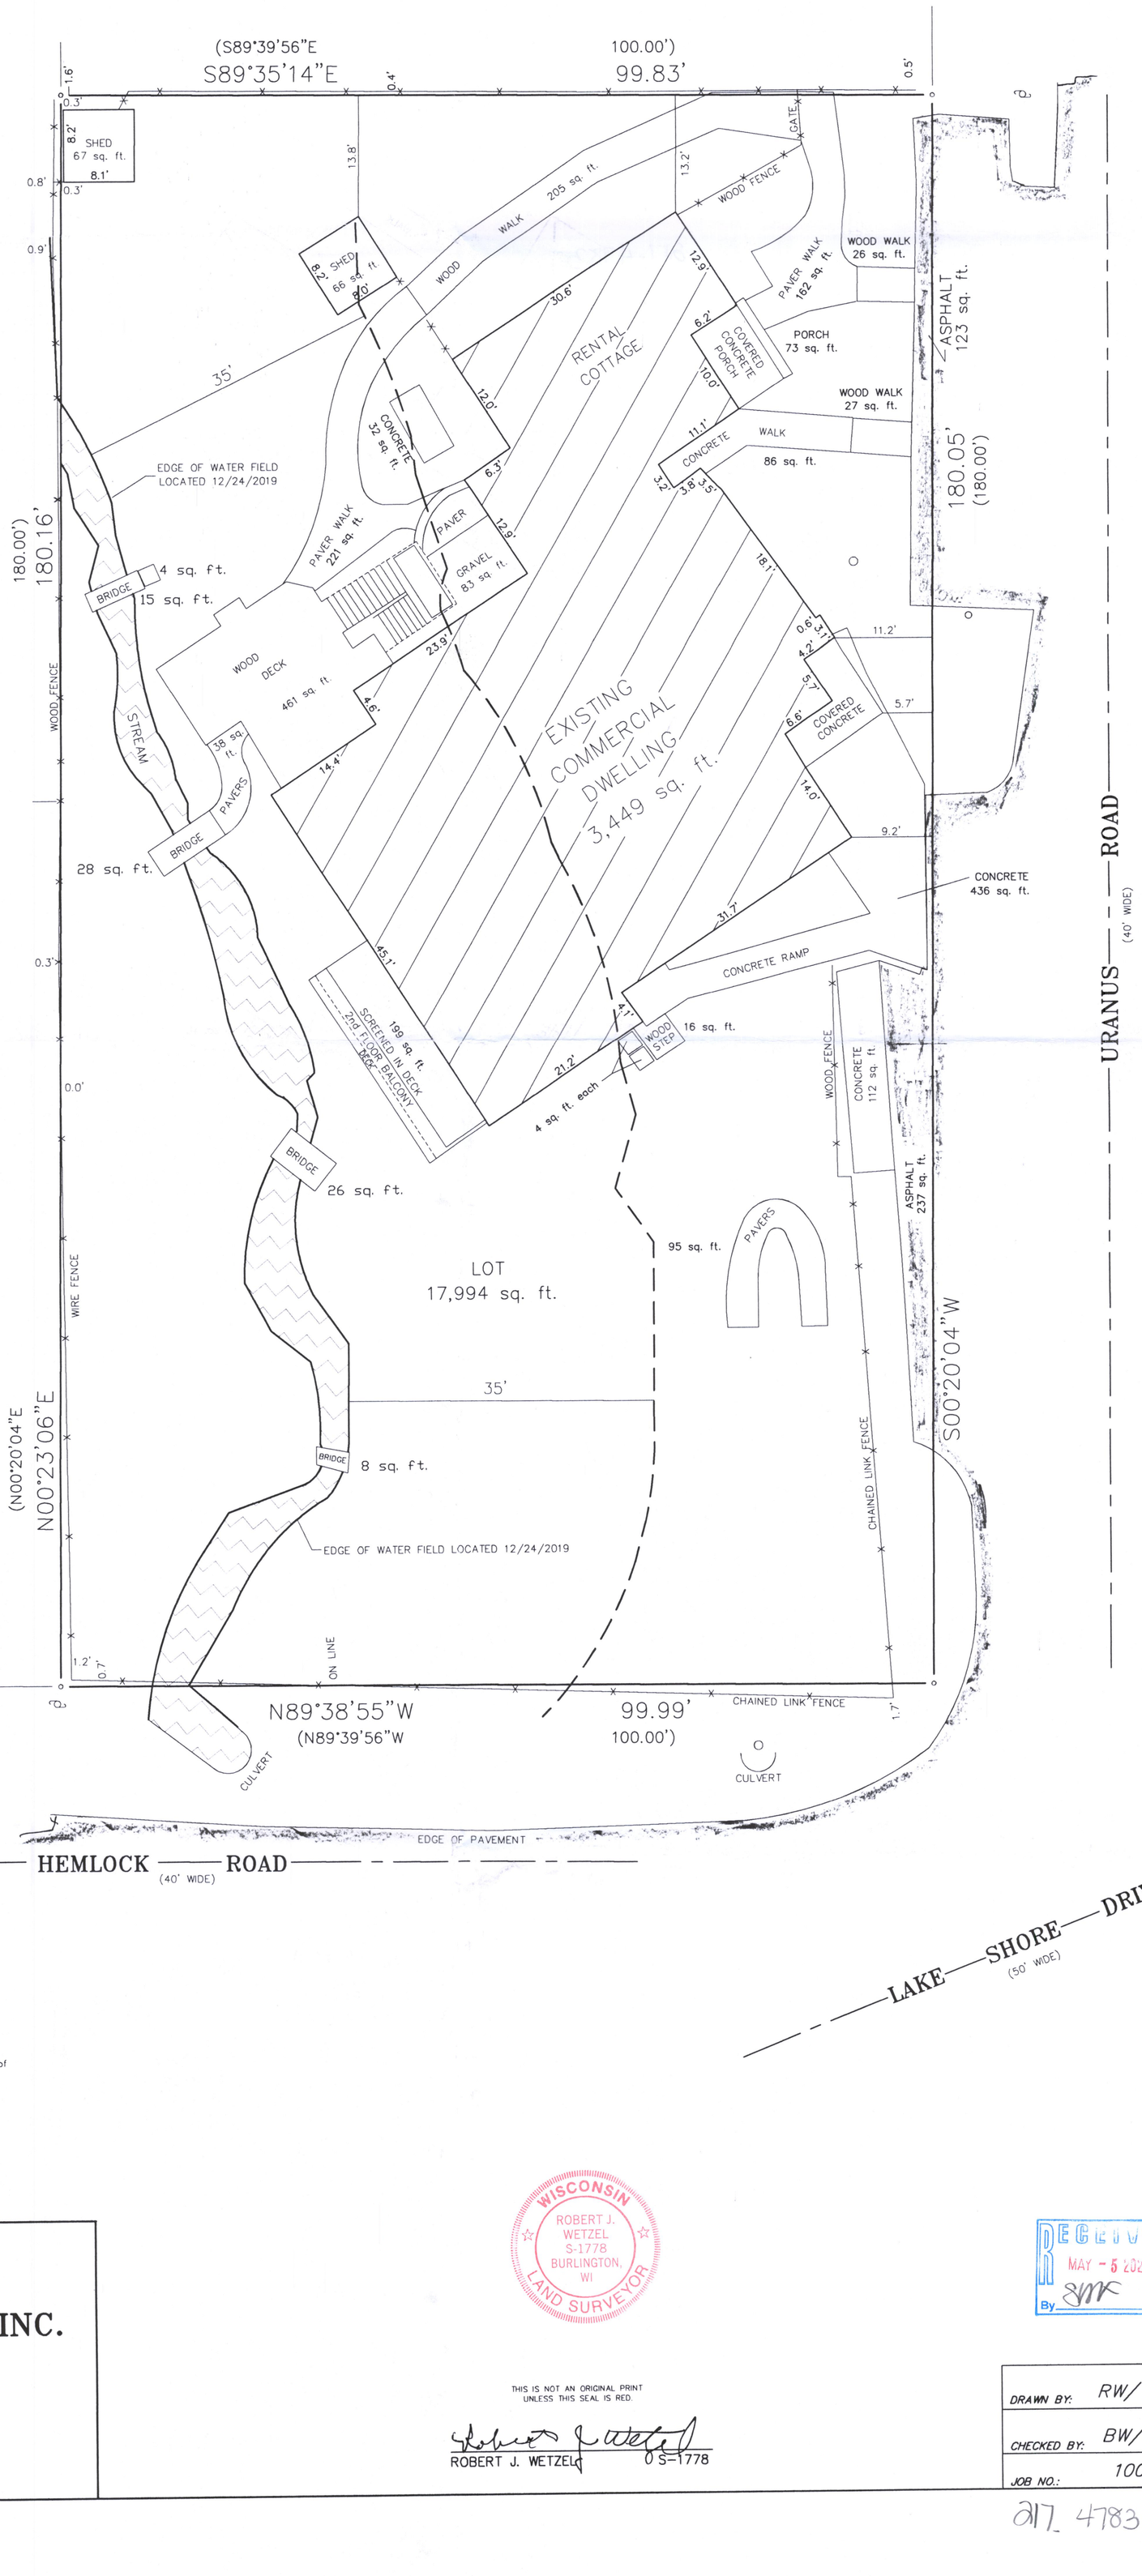

GRAPHIC SCALE
10 5 0 10
SCALE: 1" = 10'

LEGEND
- o FOUND IRON PIPE
- UTILITY POLE
- ( ) RECORDED AS

BEARINGS HEREON RELATE TO THE WEST LINE OF URANUS ROAD, ASSUMED BEARING S00°20'04"W.

NOTE: REVISED TO SHOW NEW ASPHALT AND WOOD WALKS IN NORTHEAST CORNER OF LOT.

"I hereby certify that I have surveyed the above described property and that the above map is a correct representation thereof and shows the size and location of the property, its exterior boundaries, the location of all visible structures and dimensions of all principal buildings thereon, boundary fences, apparent easements, roadways and encroachments, if any."

"This survey is made for the use of the present owners of the property, and those who purchase, mortgage, or guarantee the title thereto within one year from date hereof."

B.W. SURVEYING, INC.
412 N. PINE STREET
BURLINGTON, WI 53105
(262)–767–0225

WISCONSIN
ROBERT J. WETZEL
S-1778
BURLINGTON, WI
LAND SURVEYOR

THIS IS NOT AN ORIGINAL PRINT UNLESS THIS SEAL IS RED.

ROBERT J. WETZEL S-1778

RECEIVED
MAY – 5 2021
By

REVISED: JANUARY 19, 2021
REVISED: FEBRUARY 5, 2020
REVISED: DECEMBER 30, 2019

DRAWN BY: RW/ MTB	DATE: 12/ 26/ 2019
CHECKED BY: BW/ DW	DRAWING NO.: 10021d
JOB NO.: 10021	SHEET 1 OF 1

JLCB-2313

217 4783