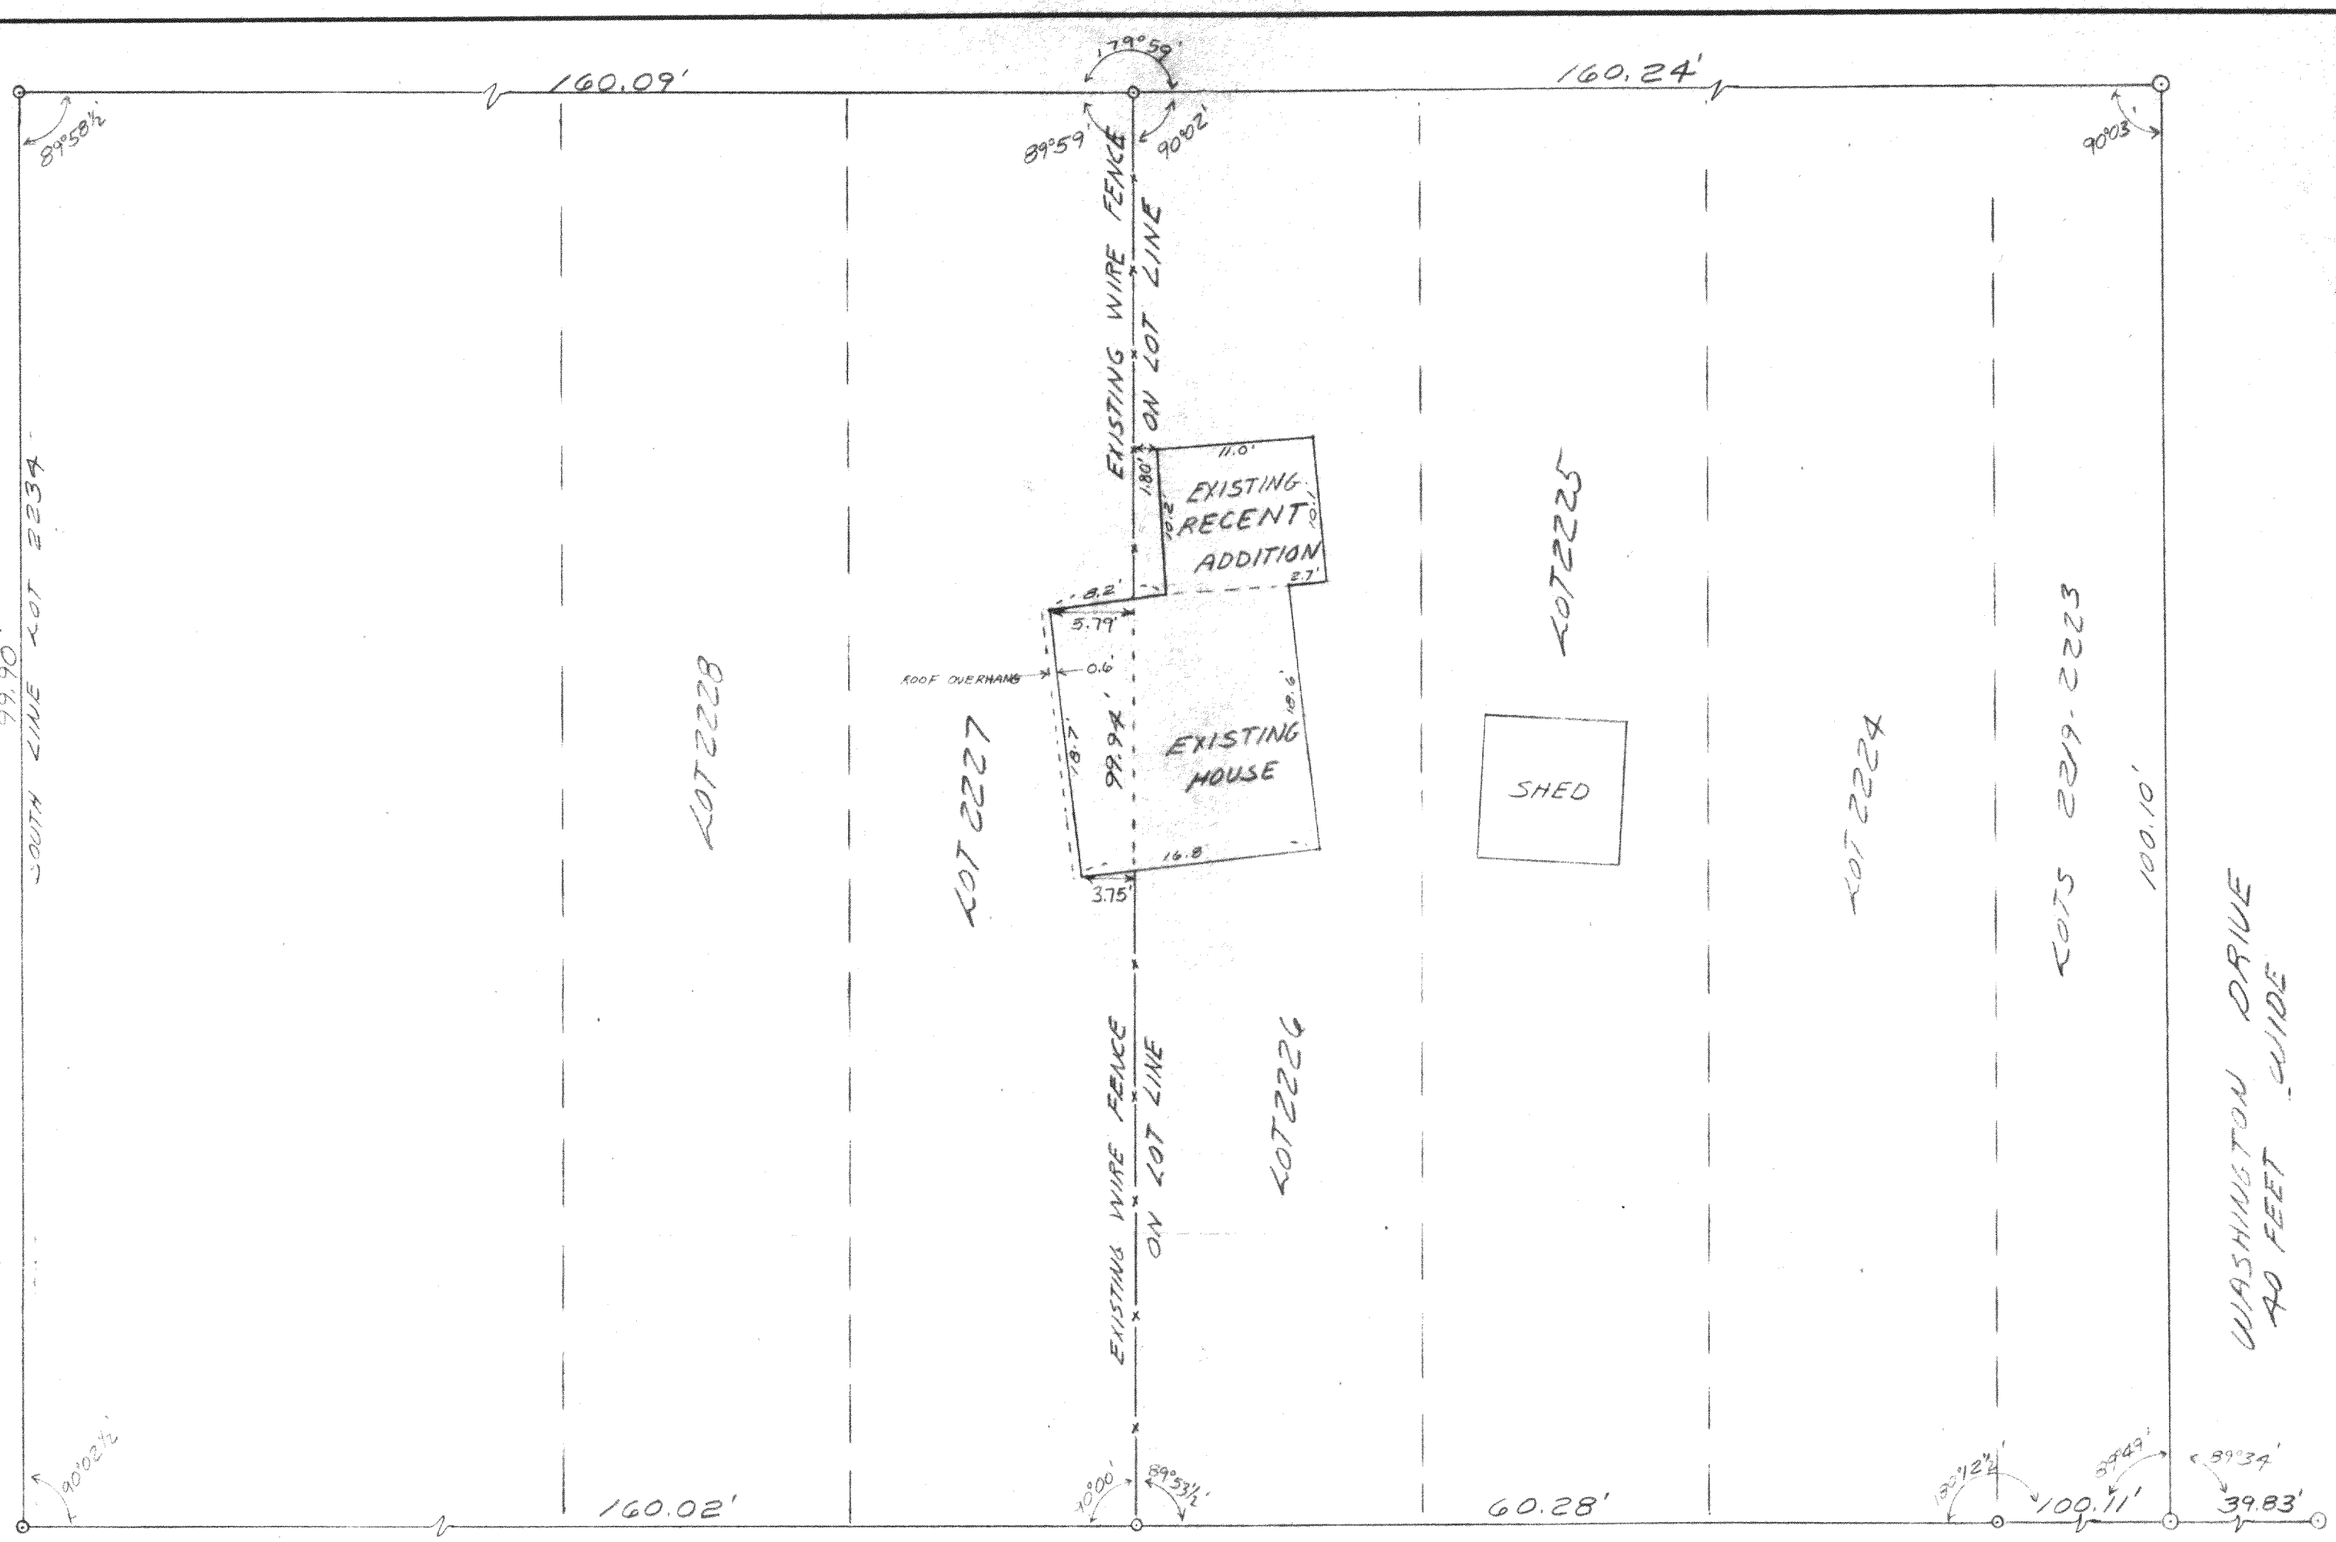

Legend

⊙ = Found Iron Pipe 1" O.D.

⊙ = Found Iron Pipe 2" O.D.

10 5 0 10 20 30 40 50 60

GRAPHIC SCALE IN FEET

WISCONSIN THOMAS P. A. JENSEN S-1694 ELKHORN, WIS. LAND SURVEYOR

JLLB-380 + 381

PLAT OF SURVEY

OF

HOUSE ON LINE BETWEEN LOT 2226 AND LOT 2227 OF LAKE COMO BEACH SUBDIVISION LOCATED IN SW 1/4 SEC. 22, T. 2N., R. 17E., WALWORTH COUNTY, WISCONSIN

Thomas P. A. Jensen
DEPUTY CO. SURVEYOR

SCALE 1" = 10'

DATE 15 OCT 1975

217-479

NO. 175H 300 9-68

~~217-129~~