
PLAT OF SURVEY

BUILDING 5 OF LOT 15 OF CONDOMINIUM 59 OF GENEVA NATIONAL

BEING PART OF THE SE 1/4 OF THE NW 1/4 OF SECTION 31, TOWN 2 NORTH, RANGE 17 EAST
TOWN OF GENEVA, WALWORTH COUNTY, WISCONSIN

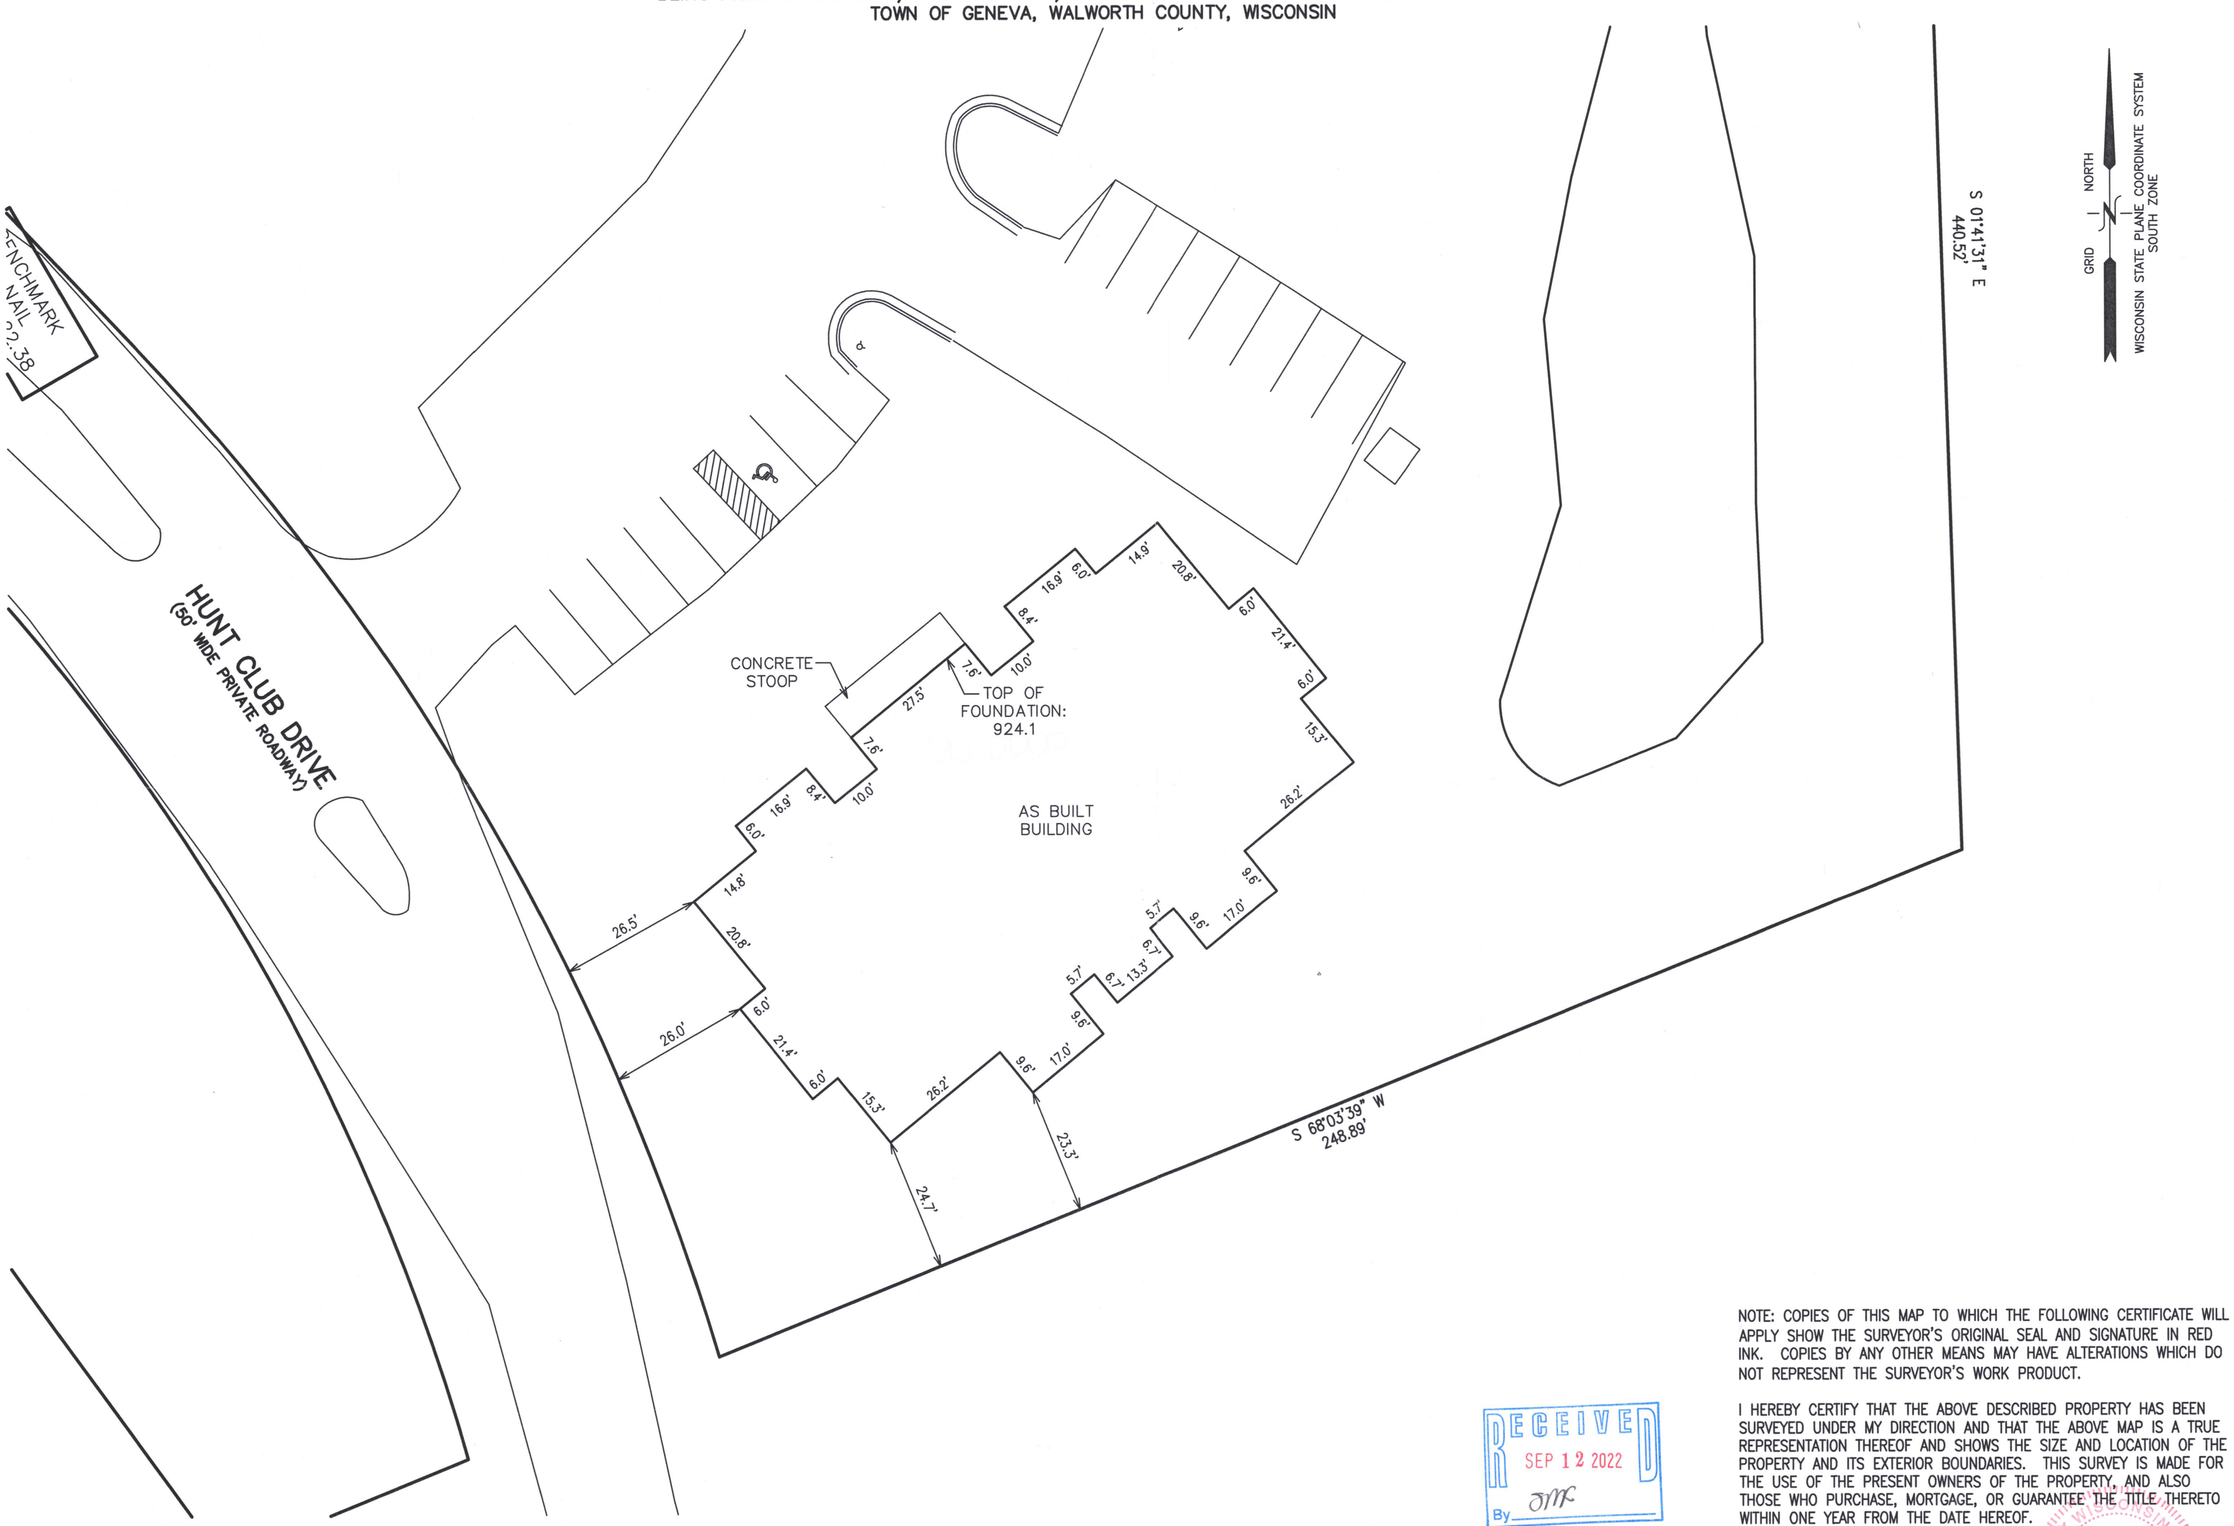

20 10 0 20 40 60 80
MAP SCALE IN FEET – ORIGINAL 1"=20'

NOTE: COPIES OF THIS MAP TO WHICH THE FOLLOWING CERTIFICATE WILL APPLY SHOW THE SURVEYOR'S ORIGINAL SEAL AND SIGNATURE IN RED INK. COPIES BY ANY OTHER MEANS MAY HAVE ALTERATIONS WHICH DO NOT REPRESENT THE SURVEYOR'S WORK PRODUCT.

I HEREBY CERTIFY THAT THE ABOVE DESCRIBED PROPERTY HAS BEEN SURVEYED UNDER MY DIRECTION AND THAT THE ABOVE MAP IS A TRUE REPRESENTATION THEREOF AND SHOWS THE SIZE AND LOCATION OF THE PROPERTY AND ITS EXTERIOR BOUNDARIES. THIS SURVEY IS MADE FOR THE USE OF THE PRESENT OWNERS OF THE PROPERTY, AND ALSO THOSE WHO PURCHASE, MORTGAGE, OR GUARANTEE THE TITLE THERETO WITHIN ONE YEAR FROM THE DATE HEREOF.

DATED: 2/22/2022

CHRISTOPHER A. HODGES P.L.S. 2760

WISCONSIN CHRISTOPHER A HODGES 2760 PALMYRA WIS. LAND SURVEYOR

RECEIVED SEP 12 2022 By JMF

AS-BUILT
HUNT CLUB DRIVE
LAKE GENEVA, WI 53147

– WORK ORDERED BY –
LOWELL CUSTOM HOMES
401 GENEVA NATIONAL AVE, SUITE 6
LAKE GENEVA, WI 53147

FARRIS, HANSEN & ASSOCIATES, INC.
ENGINEERING – ARCHITECTURE – SURVEYING
7 RIDGWAY COURT P.O. BOX 437
ELKHORN, WISCONSIN 53121
OFFICE: (262) 723-2098 FAX: (262) 723-5886

REVISIONS
8/31/2022 – DHC
ASBUILT FOUNDATION

PROJECT NO.
3269.59.15
DATE:
2/22/2022
SHEET NO.
1 OF 1

X:\Projects\3269\CONDO_59\3269_59_15\ACAD\FHA_3269.59 Bld 5-AB.dwg

JGN 59-5

917-5003