
Vanderstappen
Land Surveying, Inc.
www.vandersinc.com
1316 N. Madison St.
Woodstock, Illinois 60098
ph. 815-337-8310 fax 815-337-8314
"Always faithful to the property line"

PLAT OF SURVEY

Lots 1139 through 1143, both inclusive, and Lots 1172 through 1175, both inclusive, in Block 19 of Lake Como Beach Third Map Plat, Town of Lake Geneva, Walworth County, Wisconsin.

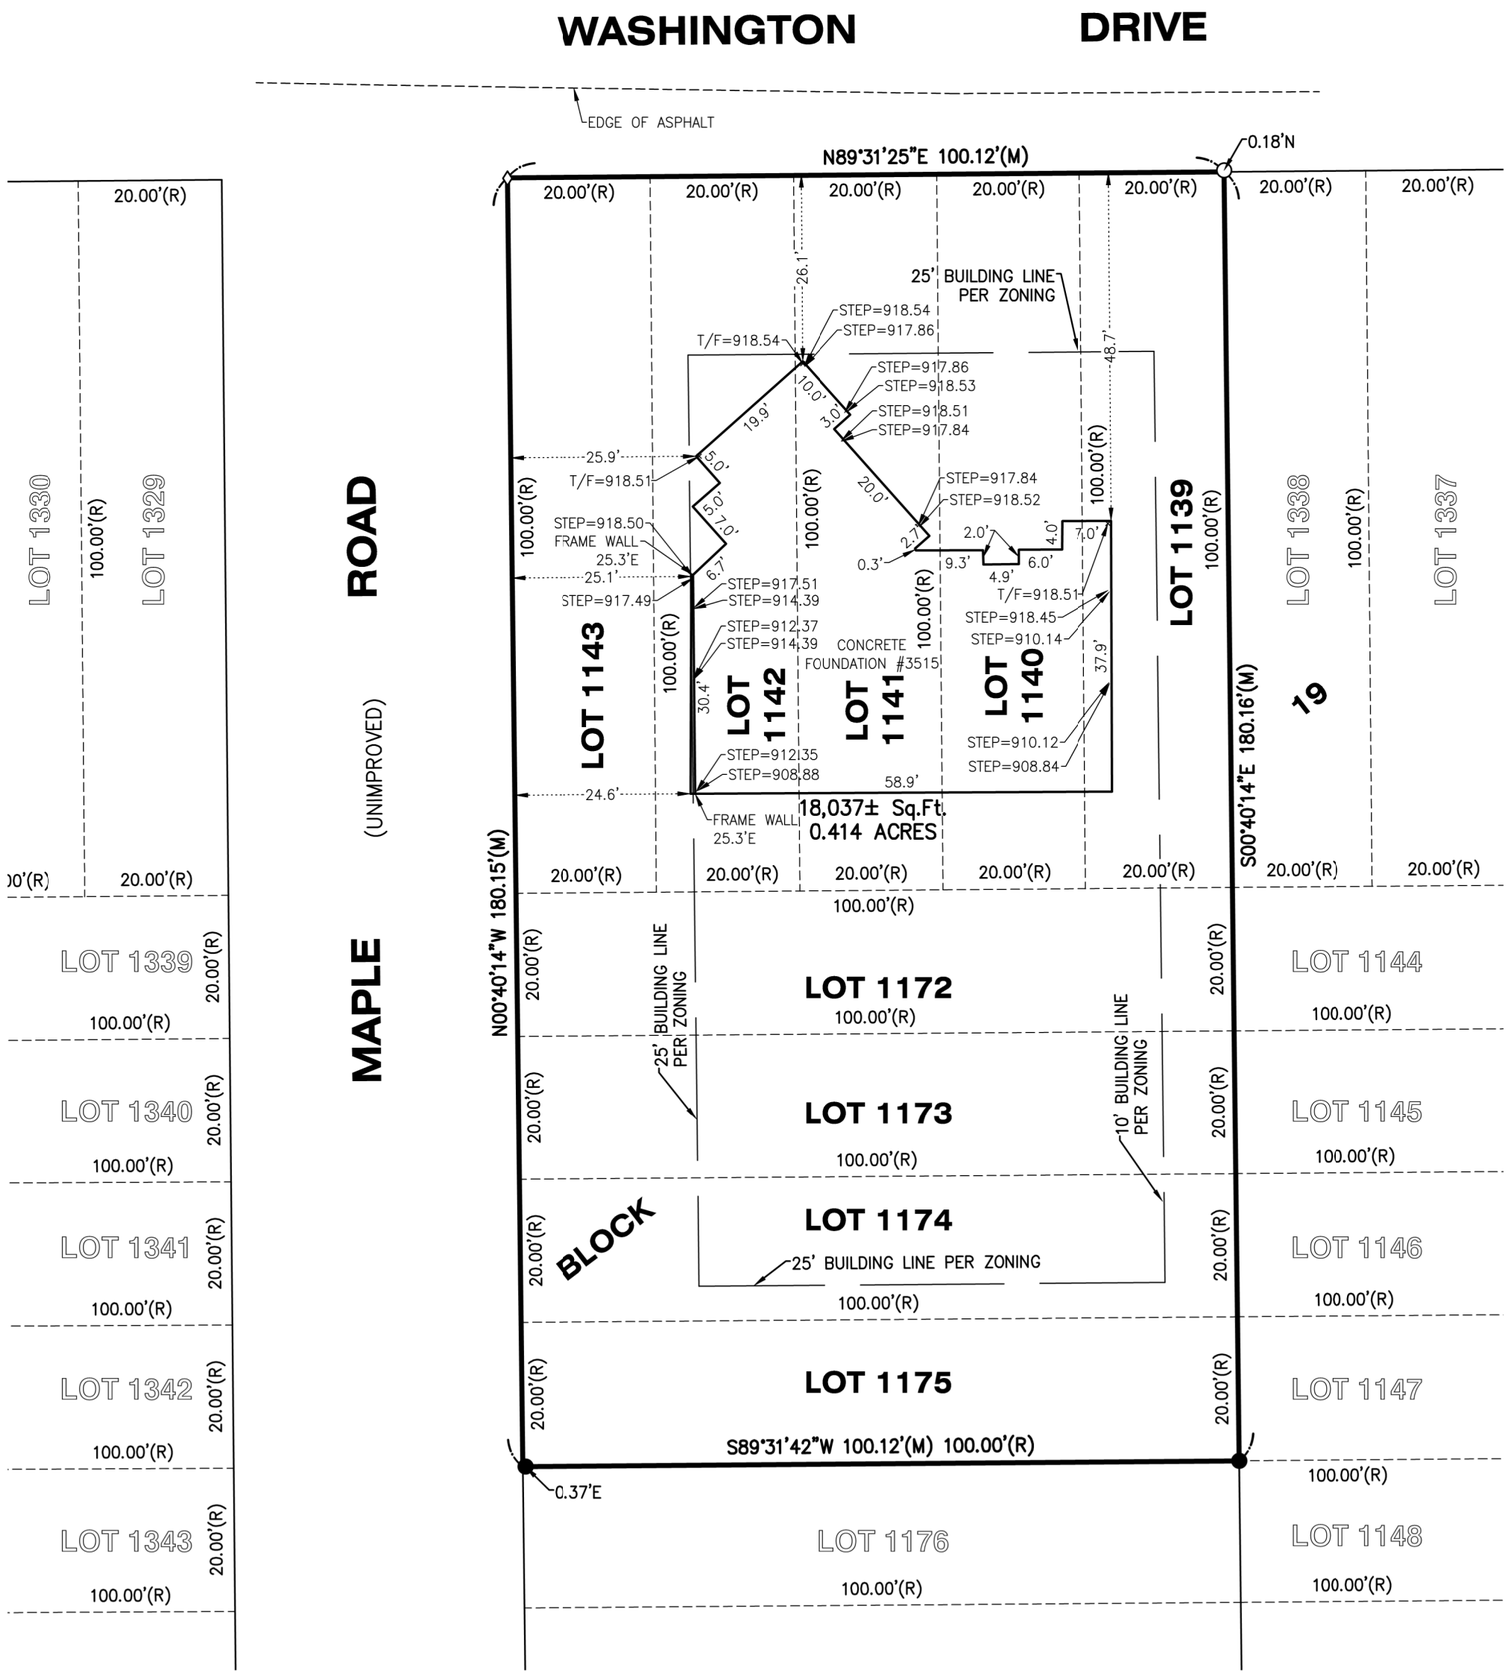

LEGEND	
◊	FOUND ANGLE IRON
●	FOUND IRON BAR
○	FOUND IRON PIPE
(M)	MEASURED
(R)	RECORD

20' 0' 20' 40'
SCALE: 1" = 20'

NOTE: Only those Building Line Restrictions or Easements shown on a Recorded Subdivision Plat are shown hereon unless the description ordered to be surveyed contains a proper description of the required building lines or easements.
- **No distance should be assumed by scaling.**
- **No underground improvements have been located unless shown and noted.**
- **No representation as to ownership, use, or possession should be hereon implied.**
- **This Survey and Plat of Survey are void without original embossed or colored seal and signature affixed.**

Compare your description and site markings with this plat and AT ONCE report any discrepancies which you may find.

WISCONSIN
ARTHUR P. GRITMACKER S-3021 WOODSTOCK ILLINOIS
LAND SURVEYOR

REVISED 02/07/22 – WEST FOUNDATION/FRAME CALLS – SES

STATE OF ILLINOIS)
) S.S.
COUNTY OF McHENRY)

In my professional opinion, and based on my observations, I hereby certify that the above described property has been surveyed under my direction and that the above map is a true representation thereof and shows the size and location of all visible structures, and dimensions of all principle buildings thereon, boundary fences, apparent easements, roadways, and visible encroachments, if any. This survey is made for the use of the present owners of the property, and also those who purchase, mortgage, or guarantee the title thereto within one year from the date hereof.

Dated at Woodstock, McHenry County, Illinois 11/17 A.D., 20 21.

Vanderstappen Land Surveying, Inc.
Design Firm No. 184-002792

By: Arthur Gritmacker
Wisconsin Registered Land Surveyor No. S3021

CLIENT: SCHULDT BUILDERS & REMODELING
DRAWN BY: CKV **CHECKED BY:** APG
SCALE: 1"=20' **SEC.** 22 **T.** 02 **R.** 17 **E.**
BASIS OF BEARING: ASSUMED
P.I.N.: JLCB 00143
JOB NO.: 210484-A **I.D.** FND
FIELDWORK COMP.: 11/15/21 **BK.** ____ **PG.** ____
ALL DISTANCES SHOWN IN FEET AND DECIMAL PARTS THEREOF CORRECTED TO 68° F. **REF:** _____

Y:\PLATS\2021\0400-0599\210484_V-210484\210484-A FND.dwg-Layout1-2/7/2022 8:33 AM