
KOLB LAND CONSULTING, INC.

LAND SURVEYING · SUBDIVIDING · LAND PLANNING

LAKE GENEVA, WISCONSIN 53147 WHITEWATER, WISCONSIN 53190

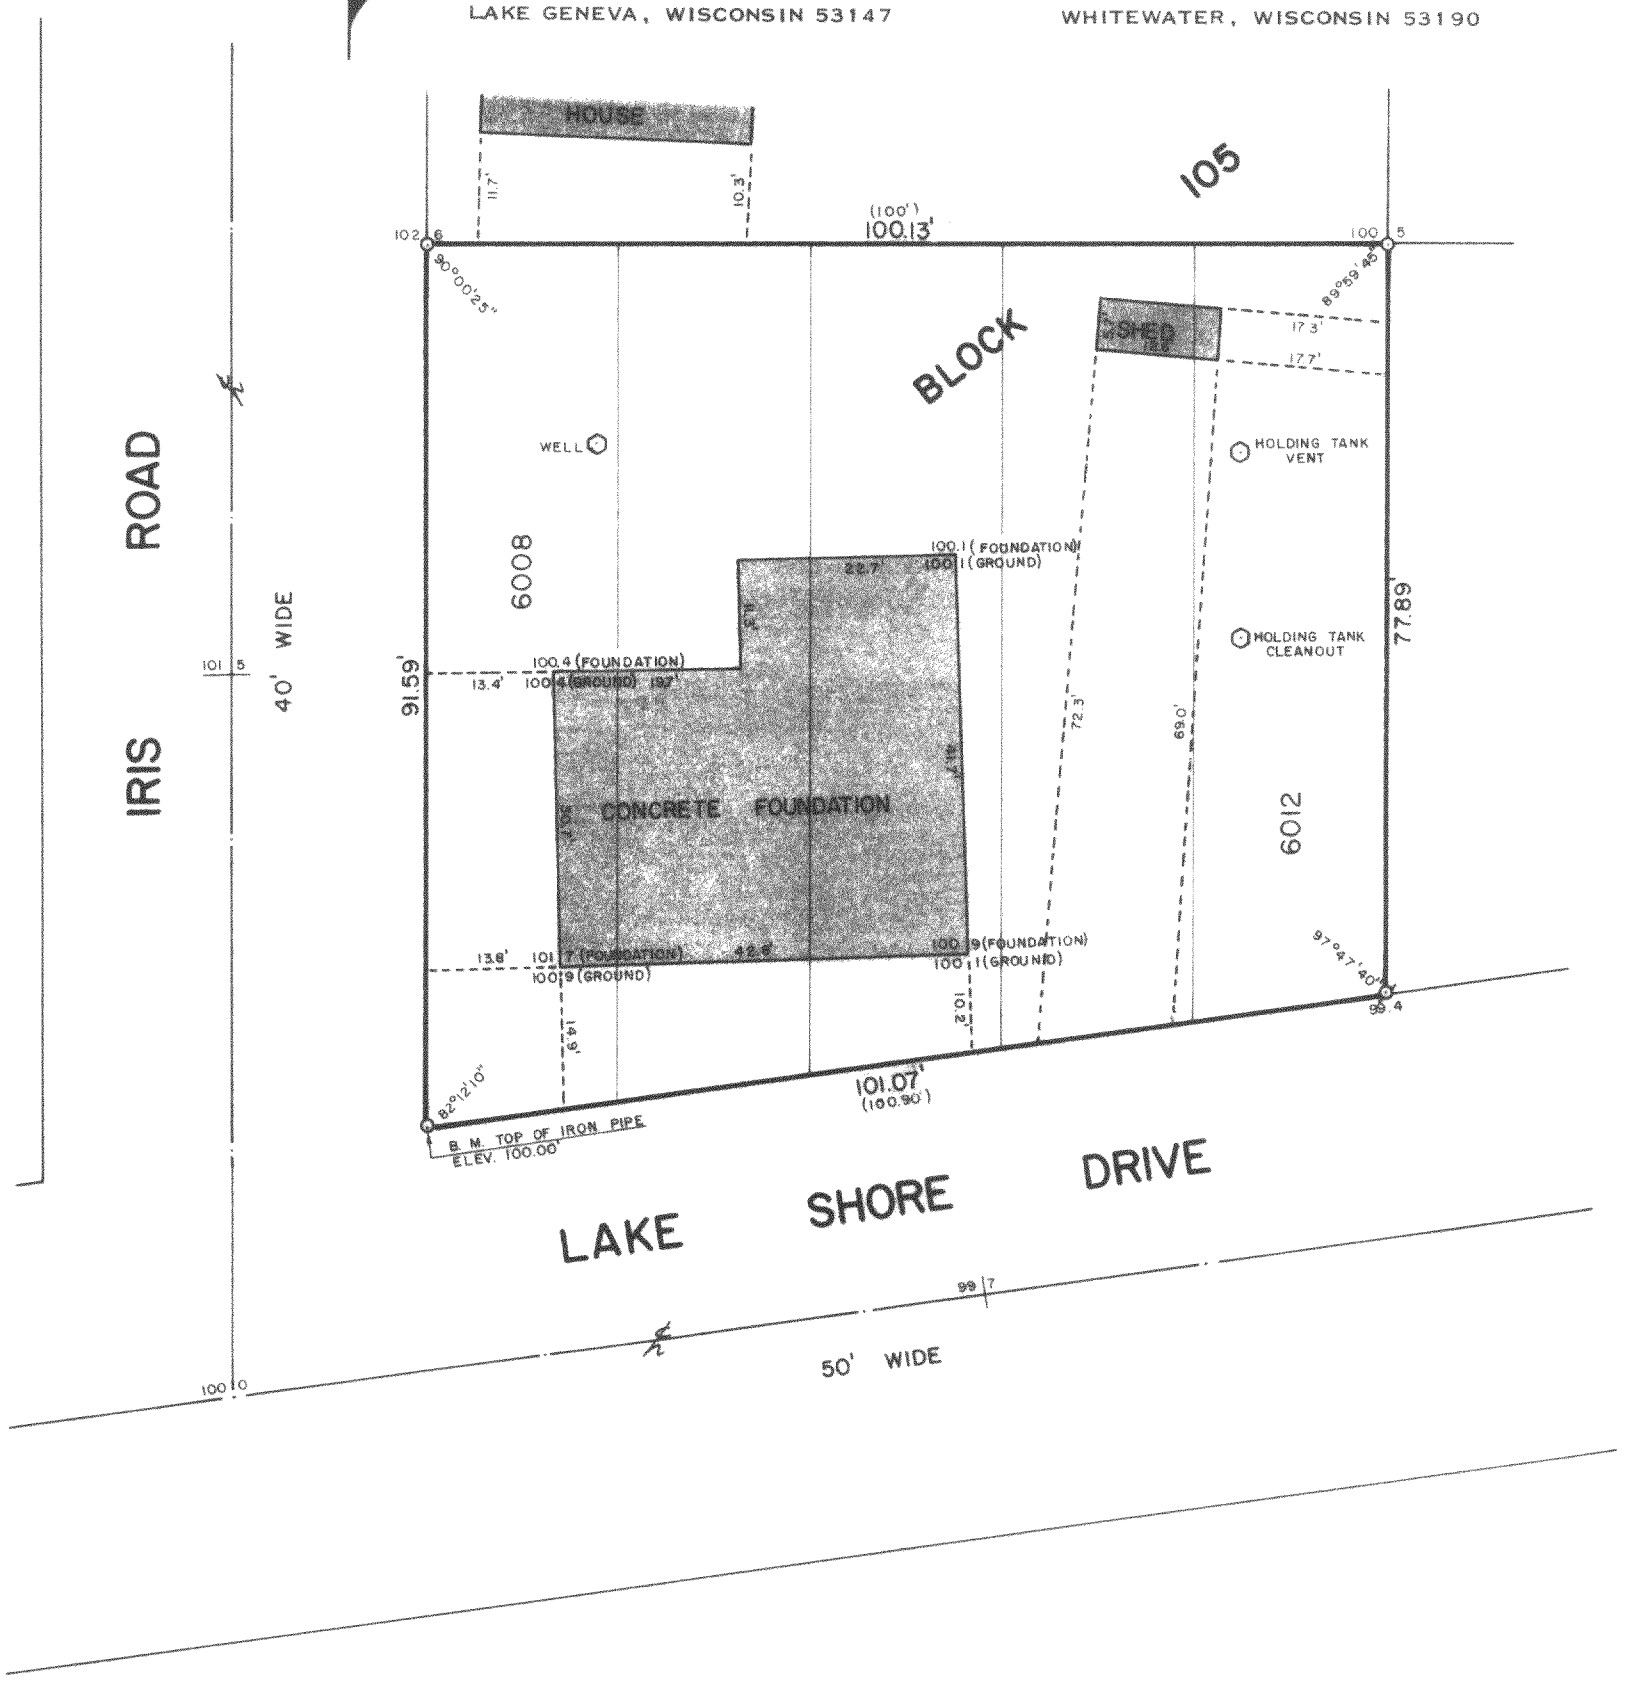

PLAT OF SURVEY OF

LOTS 6008-6012, BLOCK 105, LAKE COMO BEACH,
A SUBDIVISION LOCATED IN T 2 N, R 17 E,
WALWORTH COUNTY, WISCONSIN.

ORDERED BY: DE BELLO CONSTRUCTION
704 CENTER STREET
LAKE GENEVA, WISCONSIN 53147

NOTE: THE MEASUREMENTS SHOWN ON THE CONCRETE FOUNDATION ARE INSIDE DIMENSIONS.

SCALE: 1"=20'

ø - IRON PIPE FOUND
o - IRON PIPE PLACED
( ) - RECORDED AS

I, HAROLD H. KOLB, DO HEREBY CERTIFY THAT I HAVE SURVEYED THE PROPERTY HEREON DESCRIBED ACCORDING TO THE OFFICIAL RECORDS, AND THAT THE PLAT HEREON IS A CORRECT REPRESENTATION OF THE LOT LINES TO THE BEST OF MY KNOWLEDGE AND BELIEF.

Harold H. Kolb

HAROLD H. KOLB
WISCONSIN REGISTERED LAND SURVEYOR, S-187
DATE Jan 21, 1981

JLC B-123

217-578-K