


DUNHAM SURVEYING, S.C.
SURVEYING & SUBDIVIDING
DELAVER, WISCONSIN 53115

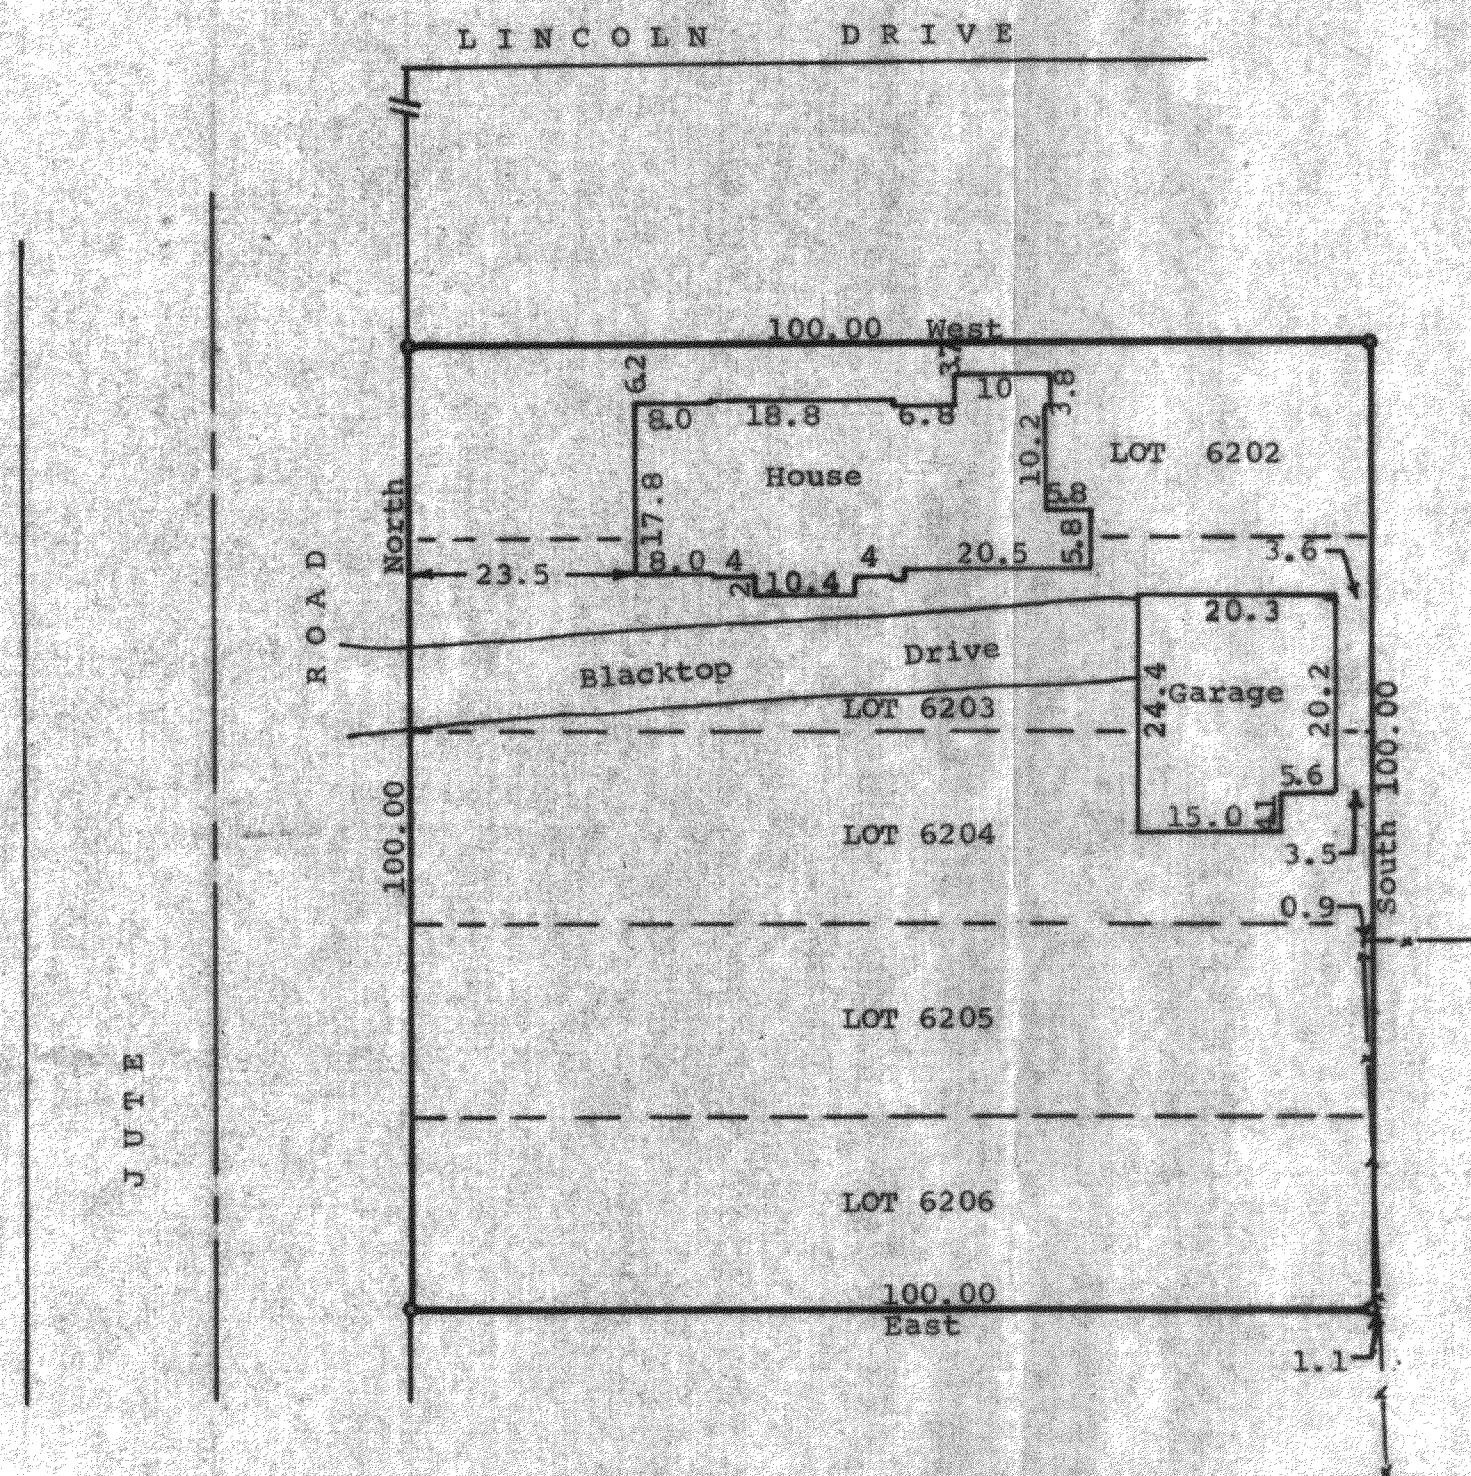

Scale - 1" = 20'
• = Iron Pipe Found
--- = Fence Line

Survey ordered by:
Geneva Lake Area Realtors
838 Main Street
Lake Geneva, WI 53147

Bearings referenced to the east line of
Jute Street of the Assumed Bearing of North

STATE OF WISCONSIN)
COUNTY OF WALWORTH) SS

I, George T. Dunham, Surveyor, certify that I have surveyed the
property described as follows:

Lots 6202, 6203, 6204, 6205, and 6206 in Block 108 of Lake Como
Beach, a subdivision located in T 2 N, R 17 E, Walworth County, Wisconsin,
and that the above map is a true representation thereof and shows the size and
location of the property, its exterior boundaries, the location of all visible
structures and dimensions of all principal buildings thereon, boundary fences,
apparent easements, roadways and visible encroachments, if any.

This survey is made for the use of the present owners of the property and also
those who purchase, mortgage, or guarantee the title thereto within one (1)
year from date hereof.

April 26, 1982

George T. Dunham
George T. Dunham, Surveyor

