
KOLB LAND CONSULTING, INC.

LAND SURVEYING · SUBDIVIDING · LAND PLANNING

LAKE GENEVA, WISCONSIN 53147 WHITEWATER, WISCONSIN 53190

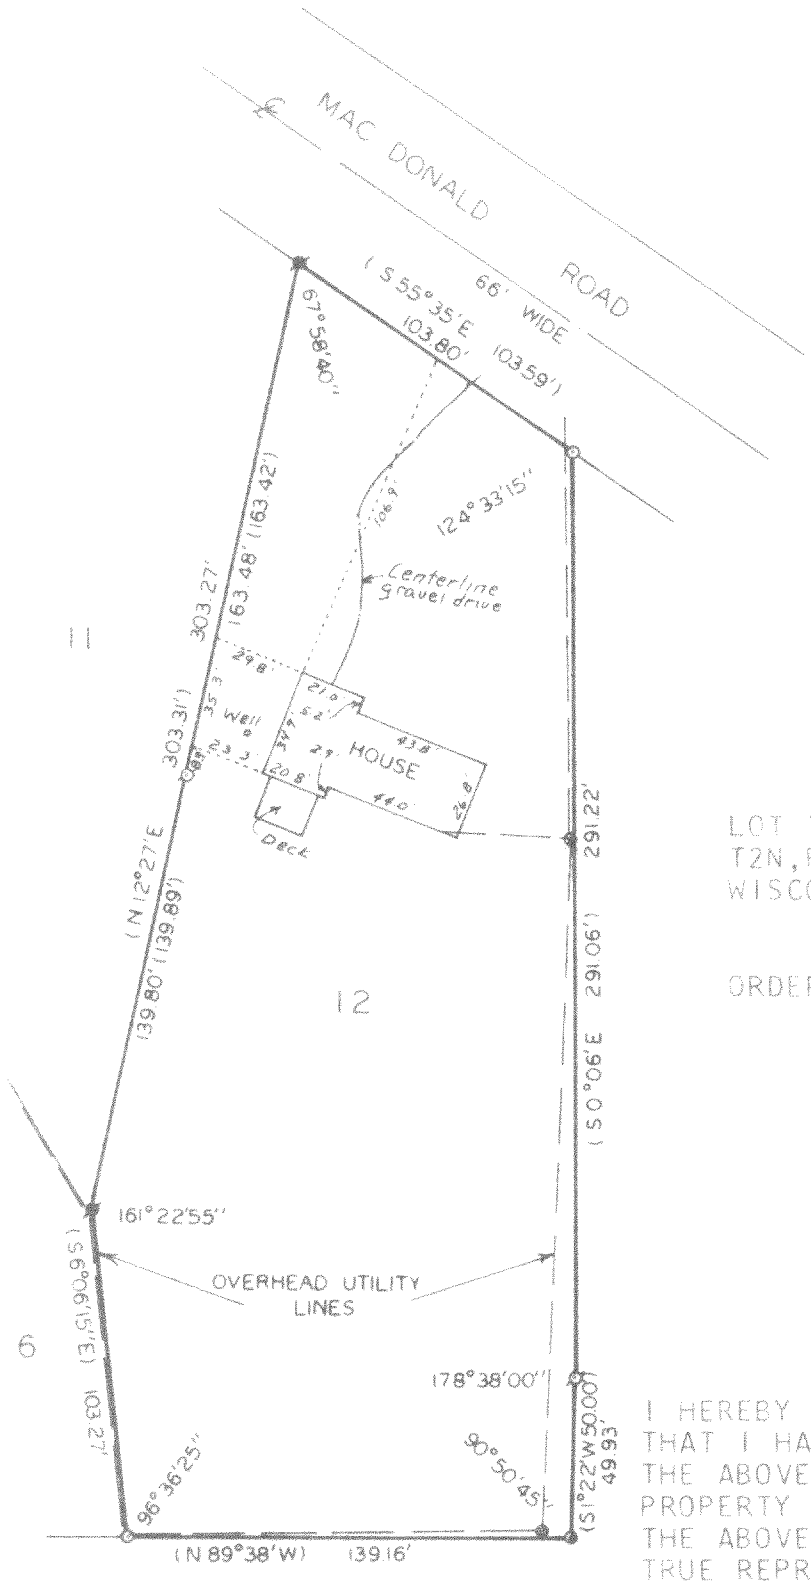

SCALE - 1"=60'

LEGEND

- ○ - 1" I.D. PIPE FOUND
- ○ - 1" I.D. PIPE SET
- ● - 1" I.D. IRON ROD FOUND
- ⊙ - 1" I.D. BAR FOUND
- ( ) - RECORDED AS
- ⊗ - UTILITY POLE

PLAT OF SURVEY OF

LOT 12, INDIAN ECHO ESTATES, T2N, R17E, WALWORTH COUNTY, WISCONSIN.

ORDERED BY: STURG HAGGART AGENCY
736 MAIN STREET
LAKE GENEVA, WISCONSIN
53147

I HEREBY CERTIFY THAT I HAVE SURVEYED THE ABOVE DESCRIBED PROPERTY AND THAT THE ABOVE MAP IS A TRUE REPRESENTATION THEREOF AND SHOWS THE SIZE AND LOCATION OF THE PROPERTY, ITS EXTERIOR BOUNDARIES, THE LOCATION OF ALL VISIBLE STRUCTURES AND OF ALL PRINCIPAL BUILDINGS ERECTED, BOUNDARY FENCES, APPARENT EASEMENTS, ROADWAYS AND VISIBLE ENCROACHMENTS, IF ANY.
THIS SURVEY IS MADE FOR THE USE OF THE PRESENT OWNERS OF THE PROPERTY, AND ALSO THOSE WHO PURCHASE, MORTGAGE, OR GUARANTEE THE TITLE THERETO WITHIN ONE (1) YEAR FROM DATE HEREOF.

Harold H. Kolb

HAROLD H. KOLB
WISCONSIN REGISTERED LAND SURVEYOR, S-187

DATE Jan. 20, 1982

217-581-K