
KOLB LAND CONSULTING, INC.

LAND SURVEYING · SUBDIVIDING · LAND PLANNING

LAKE GENEVA, WISCONSIN 53147 WHITEWATER, WISCONSIN 53190

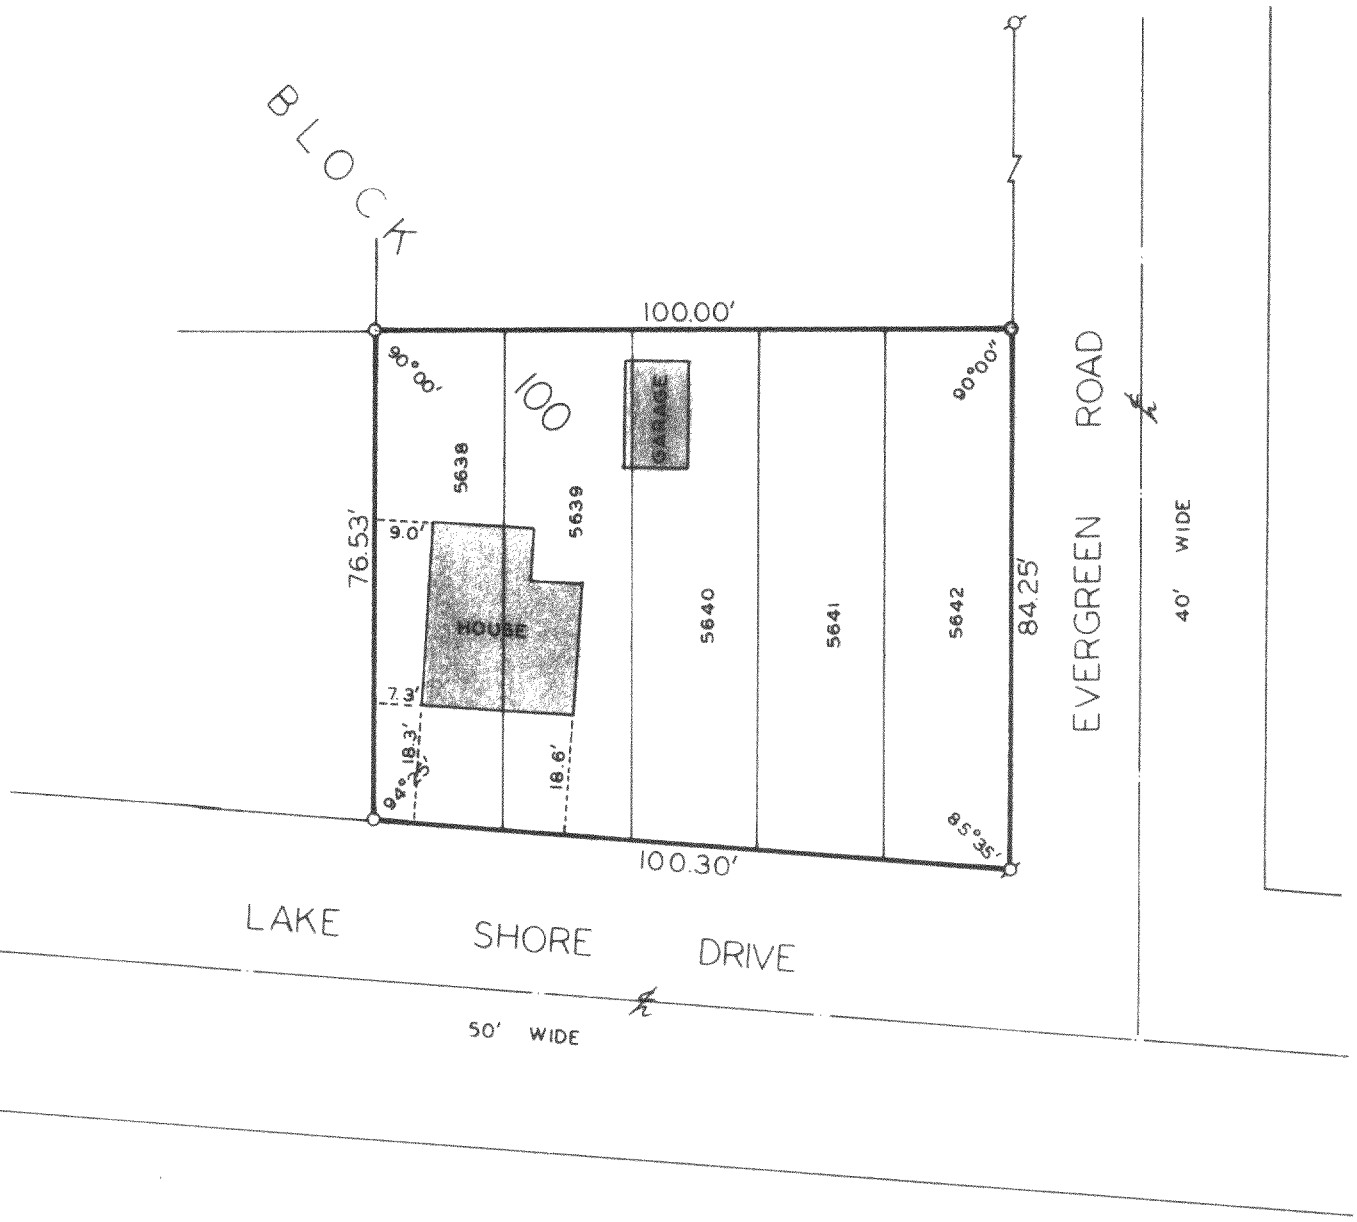

WISCONSIN
HAROLD H. KOLB
S-187
LAKE GENEVA
WIS.
LAND SURVEYOR

PLAT OF SURVEY OF

LOTS 5638-5642, BLOCK 100, LAKE COMO BEACH SUBDIVISION, TOWN 2 NORTH, RANGE 17 EAST, WALWORTH COUNTY, WISCONSIN.

ORDERED BY: STURG TAGGART AGENCY
736 MAIN STREET
LAKE GENEVA, WI 53147

LEGEND

SCALE: 1" = 30'

ø - IRON PIPE FOUND

o - IRON PIPE PLACED

I, HAROLD H. KOLB, DO HEREBY CERTIFY THAT I HAVE SURVEYED THE PROPERTY HEREON DESCRIBED ACCORDING TO THE OFFICIAL RECORDS, AND THAT THE PLAT HEREON IS A CORRECT REPRESENTATION OF THE LOT LINES TO THE BEST OF MY KNOWLEDGE AND BELIEF.

Harold H. Kolb

HAROLD H. KOLB
WISCONSIN REGISTERED LAND SURVEYOR, S-187
DATE Sept. 10, 1980

JLC B-1147

217-582-K ✓