
RECEIVED
JUL 30 1985

WALWORTH COUNTY
SURVEYING & MAPPING
LAKE GENEVA, WISCONSIN

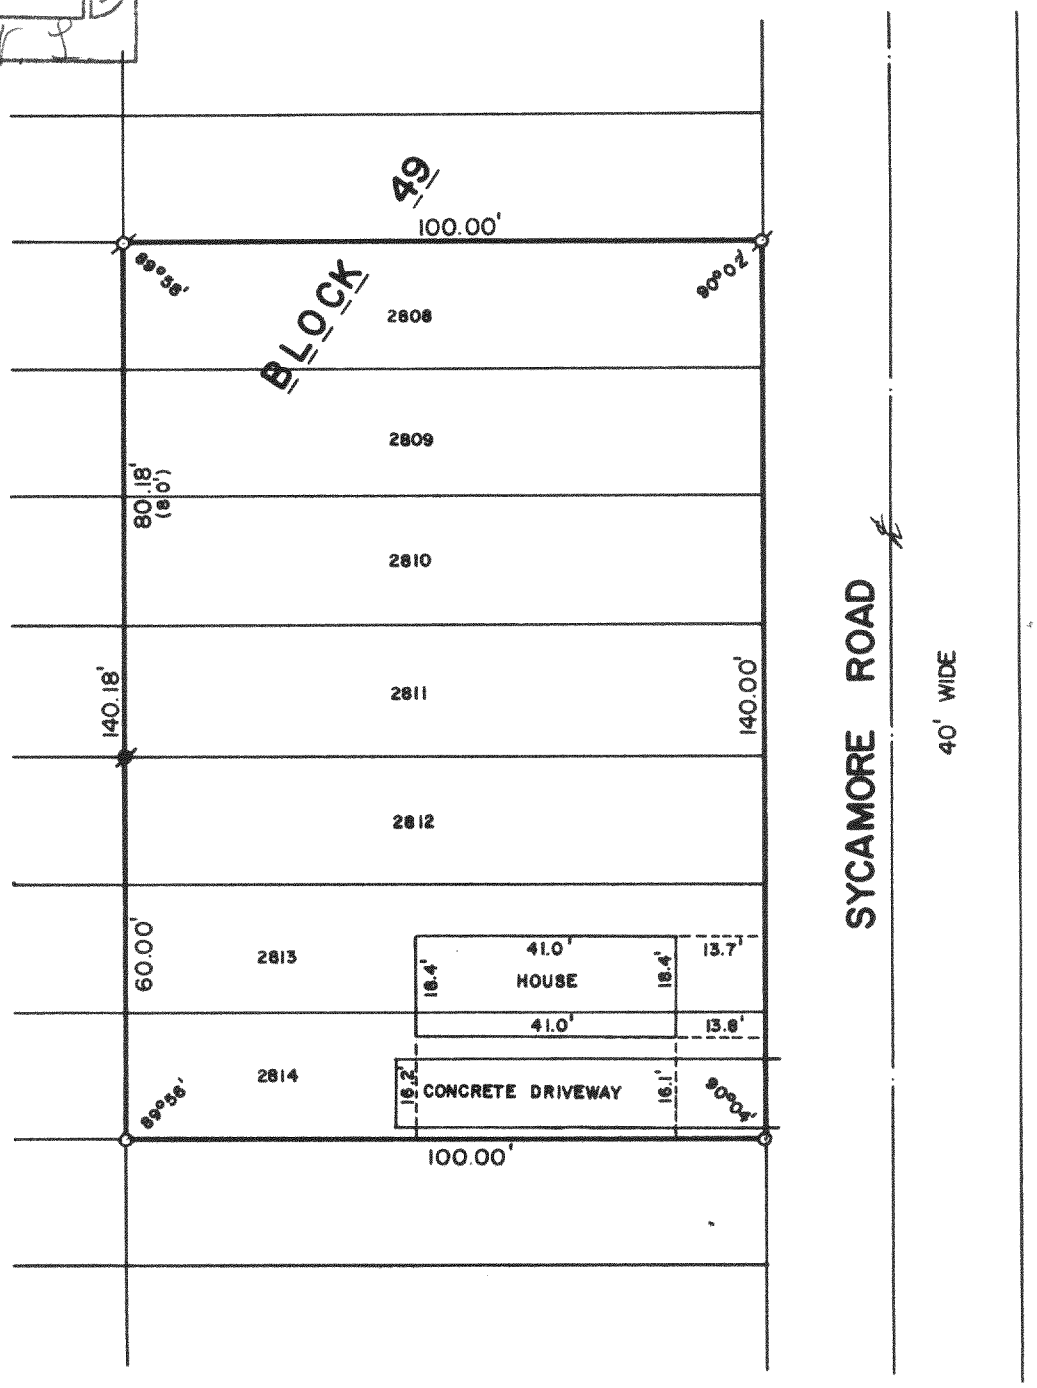

PLAT OF SURVEY OF

LOTS 2808-2814, BLOCK 49 OF LAKE COMO BEACH SUBDIVISION, T 2 N, R 17 E, WALWORTH COUNTY, WISCONSIN.

ORDERED BY: 1ST BANK SOUTHEAST
303 CENTER STREET
LAKE GENEVA, WISCONSIN 53147

ROBERT M. BAERENWALD
Lake Geneva, WI.
S-1508

SCALE: 1"=30'

ø-IRON PIPE FOUND
o-IRON PIPE PLACED
◙-CONCRETE MONUMENT FOUND
()-RECORDED AS

I, ROBERT M. BAERENWALD, DO HEREBY CERTIFY THAT I HAVE SURVEYED THE PROPERTY HEREON DESCRIBED ACCORDING TO THE OFFICIAL RECORDS AND THAT THE PLAT HEREON IS A CORRECT REPRESENTATION OF THE PROPERTY LINES TO THE BEST OF MY KNOWLEDGE AND BELIEF.

Robert M. Baerenwald
ROBERT M. BAERENWALD
WISCONSIN REGISTERED LAND SURVEYOR, S-1508

Dec. 30, 1984
DATE JOB NO. 0178

JCCB-492

217-589-B3