
KOLB LAND CONSULTING, INC.

LAND SURVEYING · SUBDIVIDING · LAND PLANNING

LAKE GENEVA, WISCONSIN 53147 WHITEWATER, WISCONSIN 53190

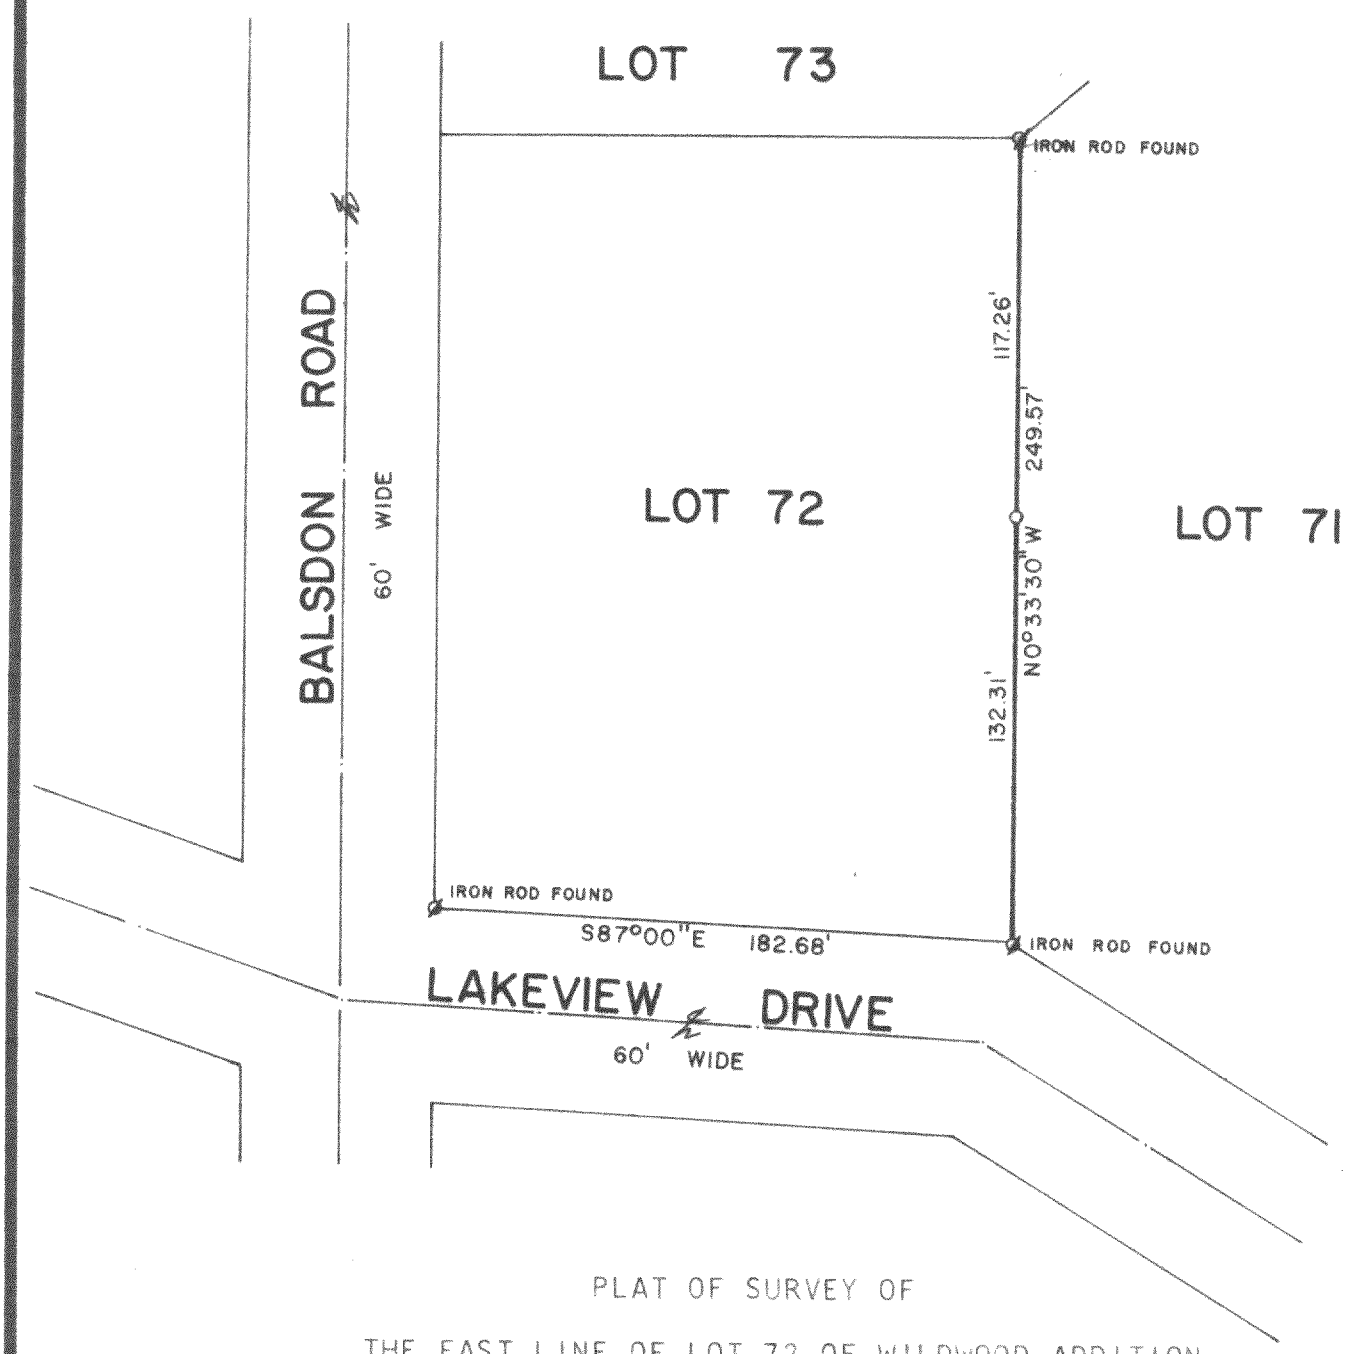

PLAT OF SURVEY OF

THE EAST LINE OF LOT 72 OF WILDWOOD ADDITION NO. ONE, LOCATED IN SECTION 34, T 2 N, R 17 E WALWORTH COUNTY, WISCONSIN.

ORDERED BY: RICHARD BRUGGER
721 GENEVA STREET
LAKE GENEVA, WISCONSIN 53147

WISCONSIN HAROLD H. KOLB S-187 LAKE GENEVA WIS. LAND SURVEYOR

I, HAROLD H. KOLB, DO HEREBY CERTIFY THAT I HAVE SURVEYED THE PROPERTY HEREON DESCRIBED ACCORDING TO THE OFFICIAL RECORDS, AND THAT THE PLAT HEREON IS A CORRECT REPRESENTATION OF THE LOT LINES TO THE BEST OF MY KNOWLEDGE AND BELIEF.

SCALE: 1"=60'

o - IRON PIPE PLACED

Harold H. Kolb

HAROLD H. KOLB
WISCONSIN, REGISTERED LAND SURVEYOR, S- 187
DATE July 23, 1982

JWSA-21

217-594-K