
KOLB LAND CONSULTING, INC.

LAND SURVEYING · SUBDIVIDING · LAND PLANNING

LAKE GENEVA, WISCONSIN 53147 — WHITEWATER, WISCONSIN 53190

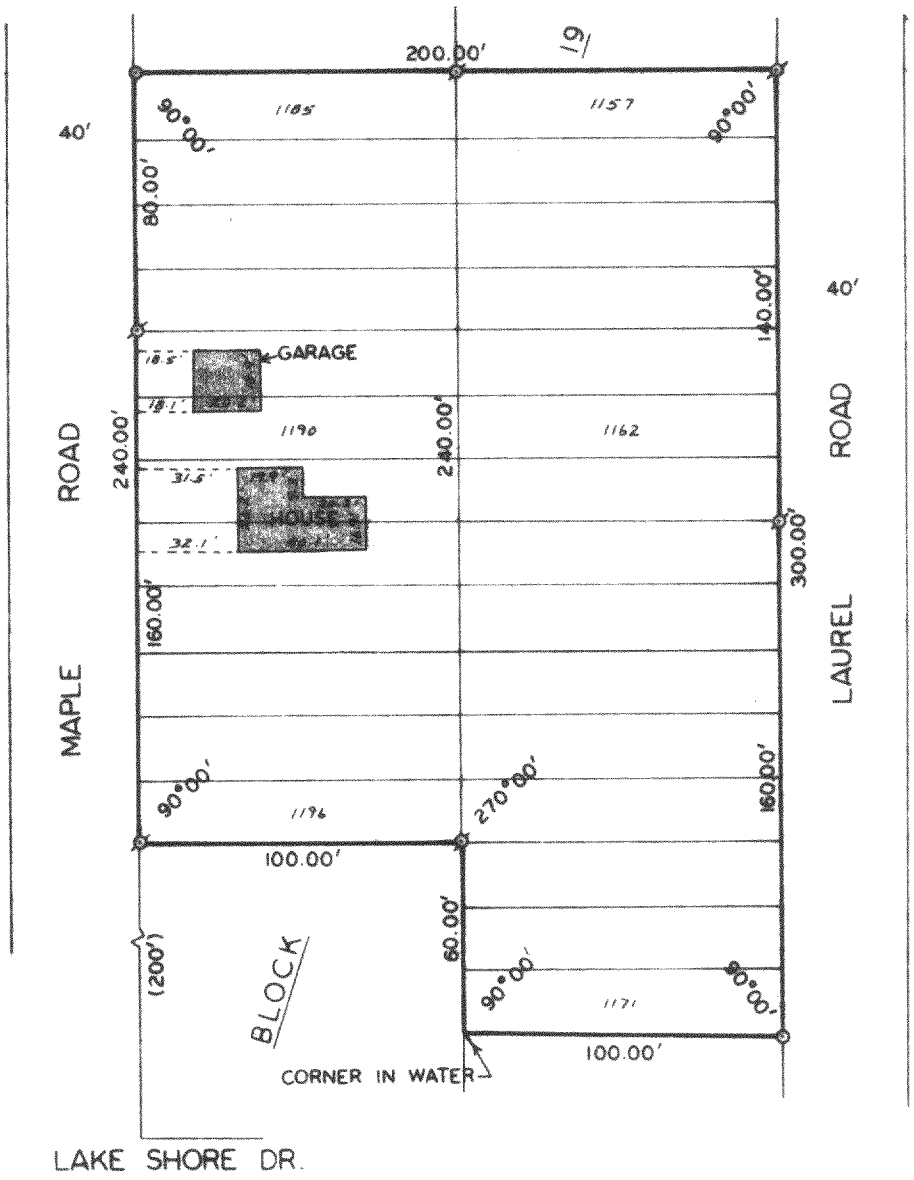

PLAT OF SURVEY OF

LOTS 1157-1171 AND 1185-1196, BLOCK 19,
LAKE COMO BEACH SUBDIVISION, T2N,R17E,
WALWORTH COUNTY, WISCONSIN.

ORDERED BY: THE TAGGART AGENCY
LAKE GENEVA, WI 53147

WISCONSIN HAROLD H. KOLB S-187 LAKE GENEVA, WIS. LAND SURVEYOR

SCALE - 1"=60'

LEGEND
⌀ - IRON PIPE FOUND
o - IRON PIPE SET
( ) - RECORDED AS

I, HAROLD H. KOLB, DO HEREBY CERTIFY THAT I HAVE SURVEYED THE PROPERTY HEREON DESCRIBED ACCORDING TO THE OFFICIAL RECORDS, AND THAT THE PLAT HEREON IS A CORRECT REPRESENTATION OF THE LOT LINES TO THE BEST OF MY KNOWLEDGE AND BELIEF.

Harold H. Kolb

HAROLD H KOLB
WISCONSIN REGISTERED LAND SURVEYOR, S- 187
DATE JUNE 20, 1983

JLCB-147, 153A

218-601-K

~~JLCB-00147, 00148, 00149~~
~~JLCB-00153A, 00154, 00155~~