
WALWORTH COUNTY
SURVEYING & MAPPING
LAKE GENEVA, WISCONSIN

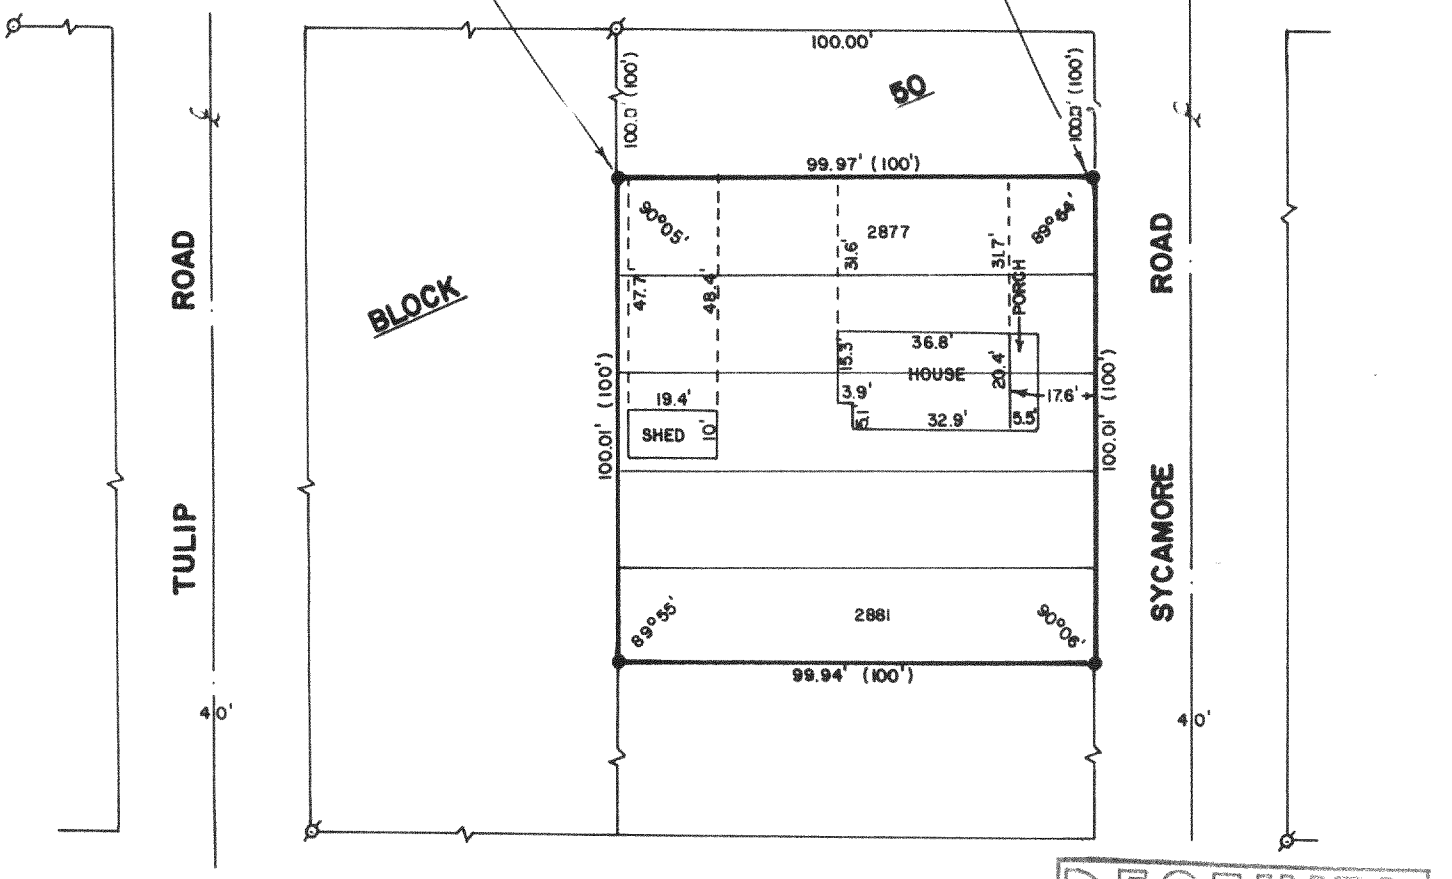

RECEIVED
AUG 5 1985

PLAT OF SURVEY OF

LOTS 2877-2881, BLOCK 50, LAKE COMO BEACH SUBDIVISION, TOWN 2 NORTH, RANGE 17 EAST, WALWORTH COUNTY, WISCONSIN.

ORDERED BY: DAVE WATERS
ROUTE 5, BOX 116
LAKE GENEVA, WI 53147

WISCONSIN
DAVID F. ABELL
S-1596
Delavan, Wis.
LAND SURVEYOR

I, DAVID F. ABELL, DO HEREBY CERTIFY THAT I HAVE SURVEYED THE PROPERTY HEREON DESCRIBED ACCORDING TO THE OFFICIAL RECORDS, AND THAT THE PLAT HEREON IS A CORRECT REPRESENTATION OF THE PROPERTY LINES TO THE BEST OF MY KNOWLEDGE AND BELIEF.

David F. Abell
DAVID F. ABELL
WISCONSIN REGISTERED LAND SURVEYOR, S-1596

June 3, 1985
DATE JOB NUMBER 0286

SCALE 1"=40'

LEGEND
ø - IRON PIPE FOUND
● - IRON ROD SET
( )- RECORDED AS

JLCB-506

217-638-BV