RECEIVED
JAN 3 1986
W. S.

FARRIS HANSEN & ASSOCIATES, INC.
ELKHORN, WISCONSIN 414-723-2098

PLAT OF SURVEY OF LOTS 7892,7893,7894,7895, & 7896 OF BLOCK 134 OF LAKE COMO BEACH SUBDIVISION, TOWN OF GENEVA, WALWORTH COUNTY, WISCONSIN

FOR DON GRUNDEN

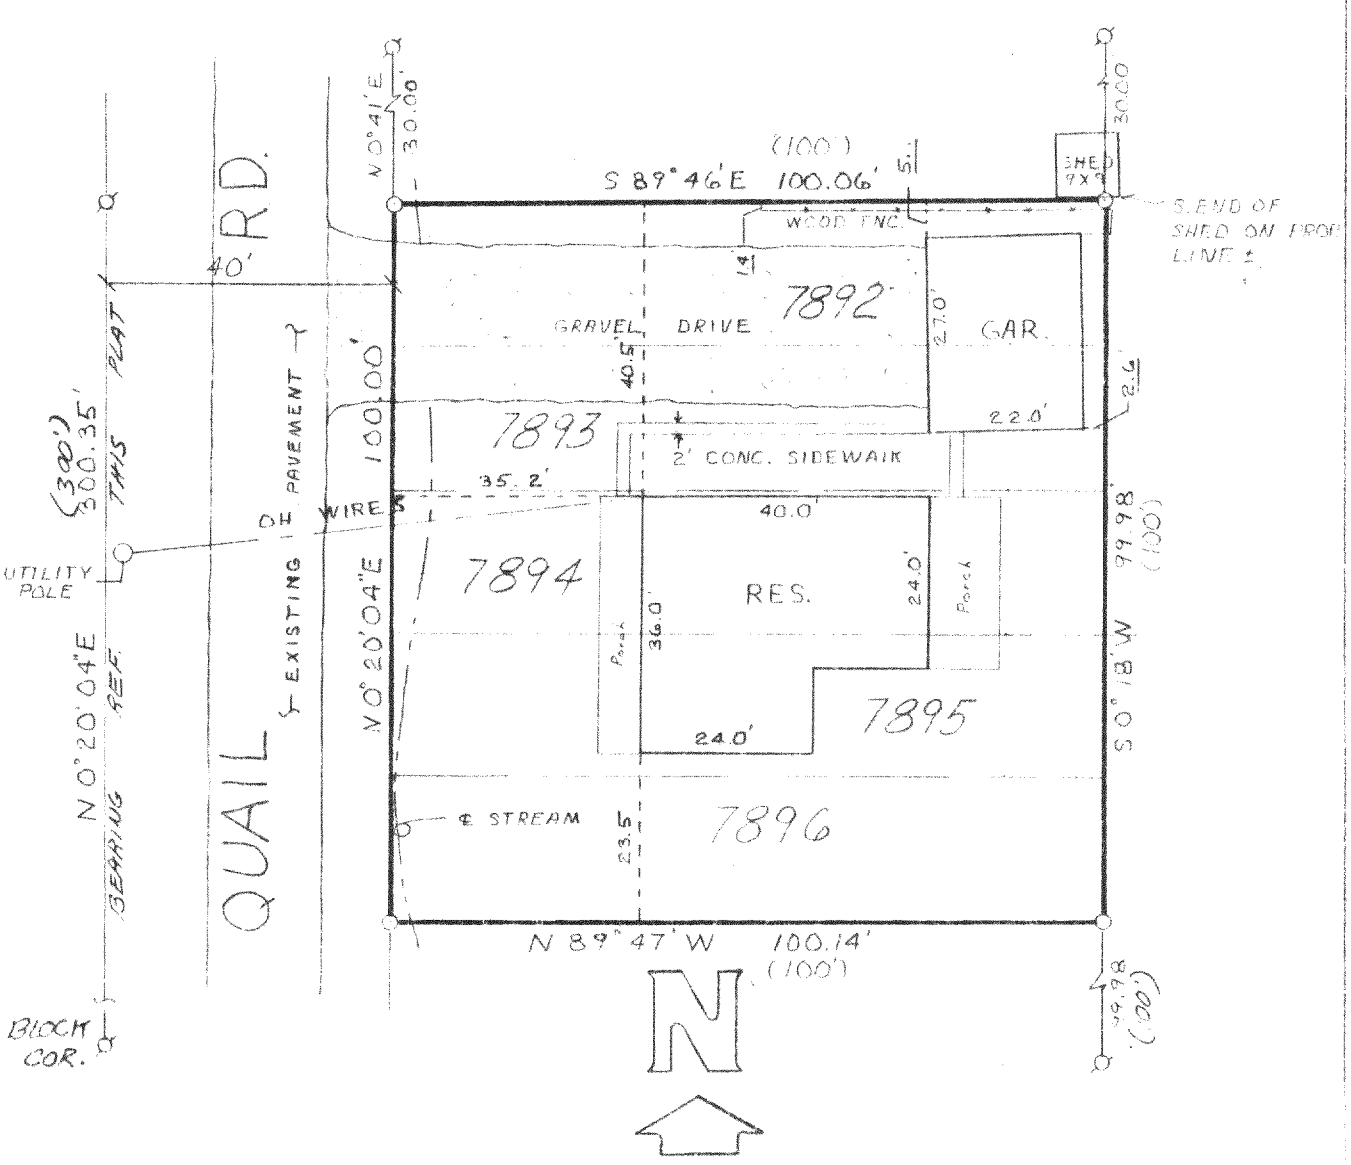

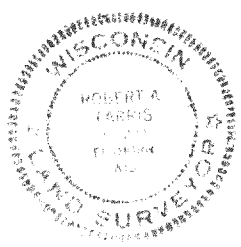

LEGEND

O = IRON PIPE SURVEY STAKE SET
Ø = IRON PIPE SURVEY STAKE FOUND
——— = OVERHEAD UTILITY WIRES (APPARENT EASEMENT)
(XXXXX) = RECORD DIMENSION FROM ORIGINAL PLAT OF LAKE COMO BEACH

I hereby certify that the above described property has been surveyed under my direction and that the above map is a true representation thereof and shows the size and location of the property, its exterior boundaries, the location of all visible structures and dimensions of all principal buildings thereon, boundary fences, apparent easements, roadways and visible encroachments, if any.
This survey is made for the use of the present owners of the property, and also those who purchase, mortgage, or guarantee the title thereto within one (1) year from the date hereof.

Robert A. Farris

Robert A. Farris RLS
Dated this 8th day of November, 1985

JLCB-01681

PROJ. # 2493

217-624-F