Plat of Survey of lots 7058, 7059. 7060, 7061, & 7062 of Lake Como Beach 1st Map, Sec. 28, T2N, R17E, Geneva Twp., Lake Geneva, Wisconsin.


WISCONSIN
DANIEL D. COOPER
S-1464
WIS.
LAND SURVEYOR

Survey ordered by- Mary D'Andrea

D. D. COOPER & CO., INC.
Daniel D. Cooper
Rt. 4 Box 508B
Elkhorn, WI 53121

RECEIVED

LINCOLN DR.

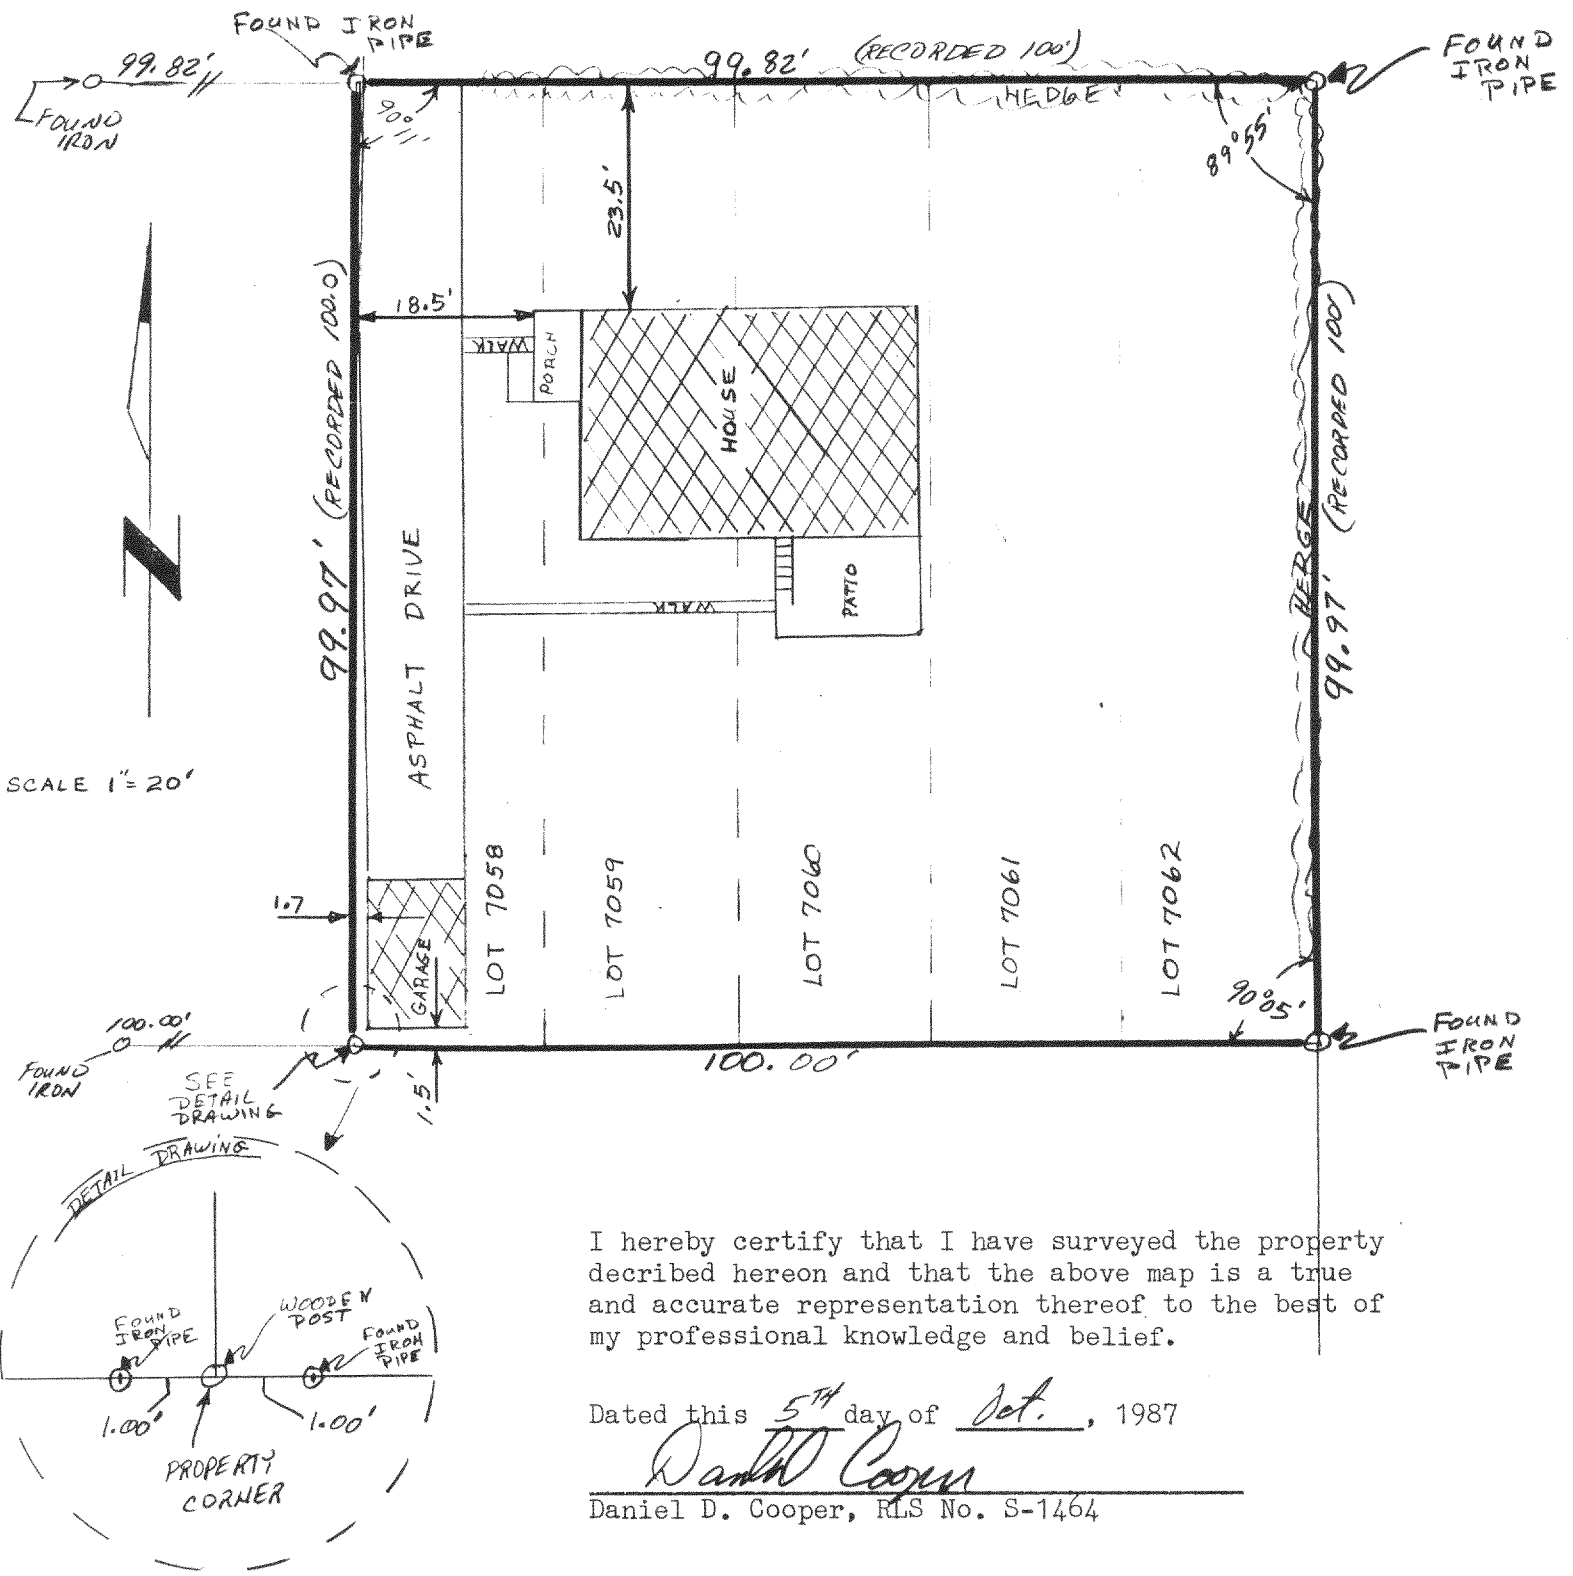

I hereby certify that I have surveyed the property decribed hereon and that the above map is a true and accurate representation thereof to the best of my professional knowledge and belief.

Dated this 5TH day of Oct., 1987

Daniel D. Cooper

Daniel D. Cooper, RLS No. S-1464

Drawing No. 1358-11-25

JLCB 1493

217-727