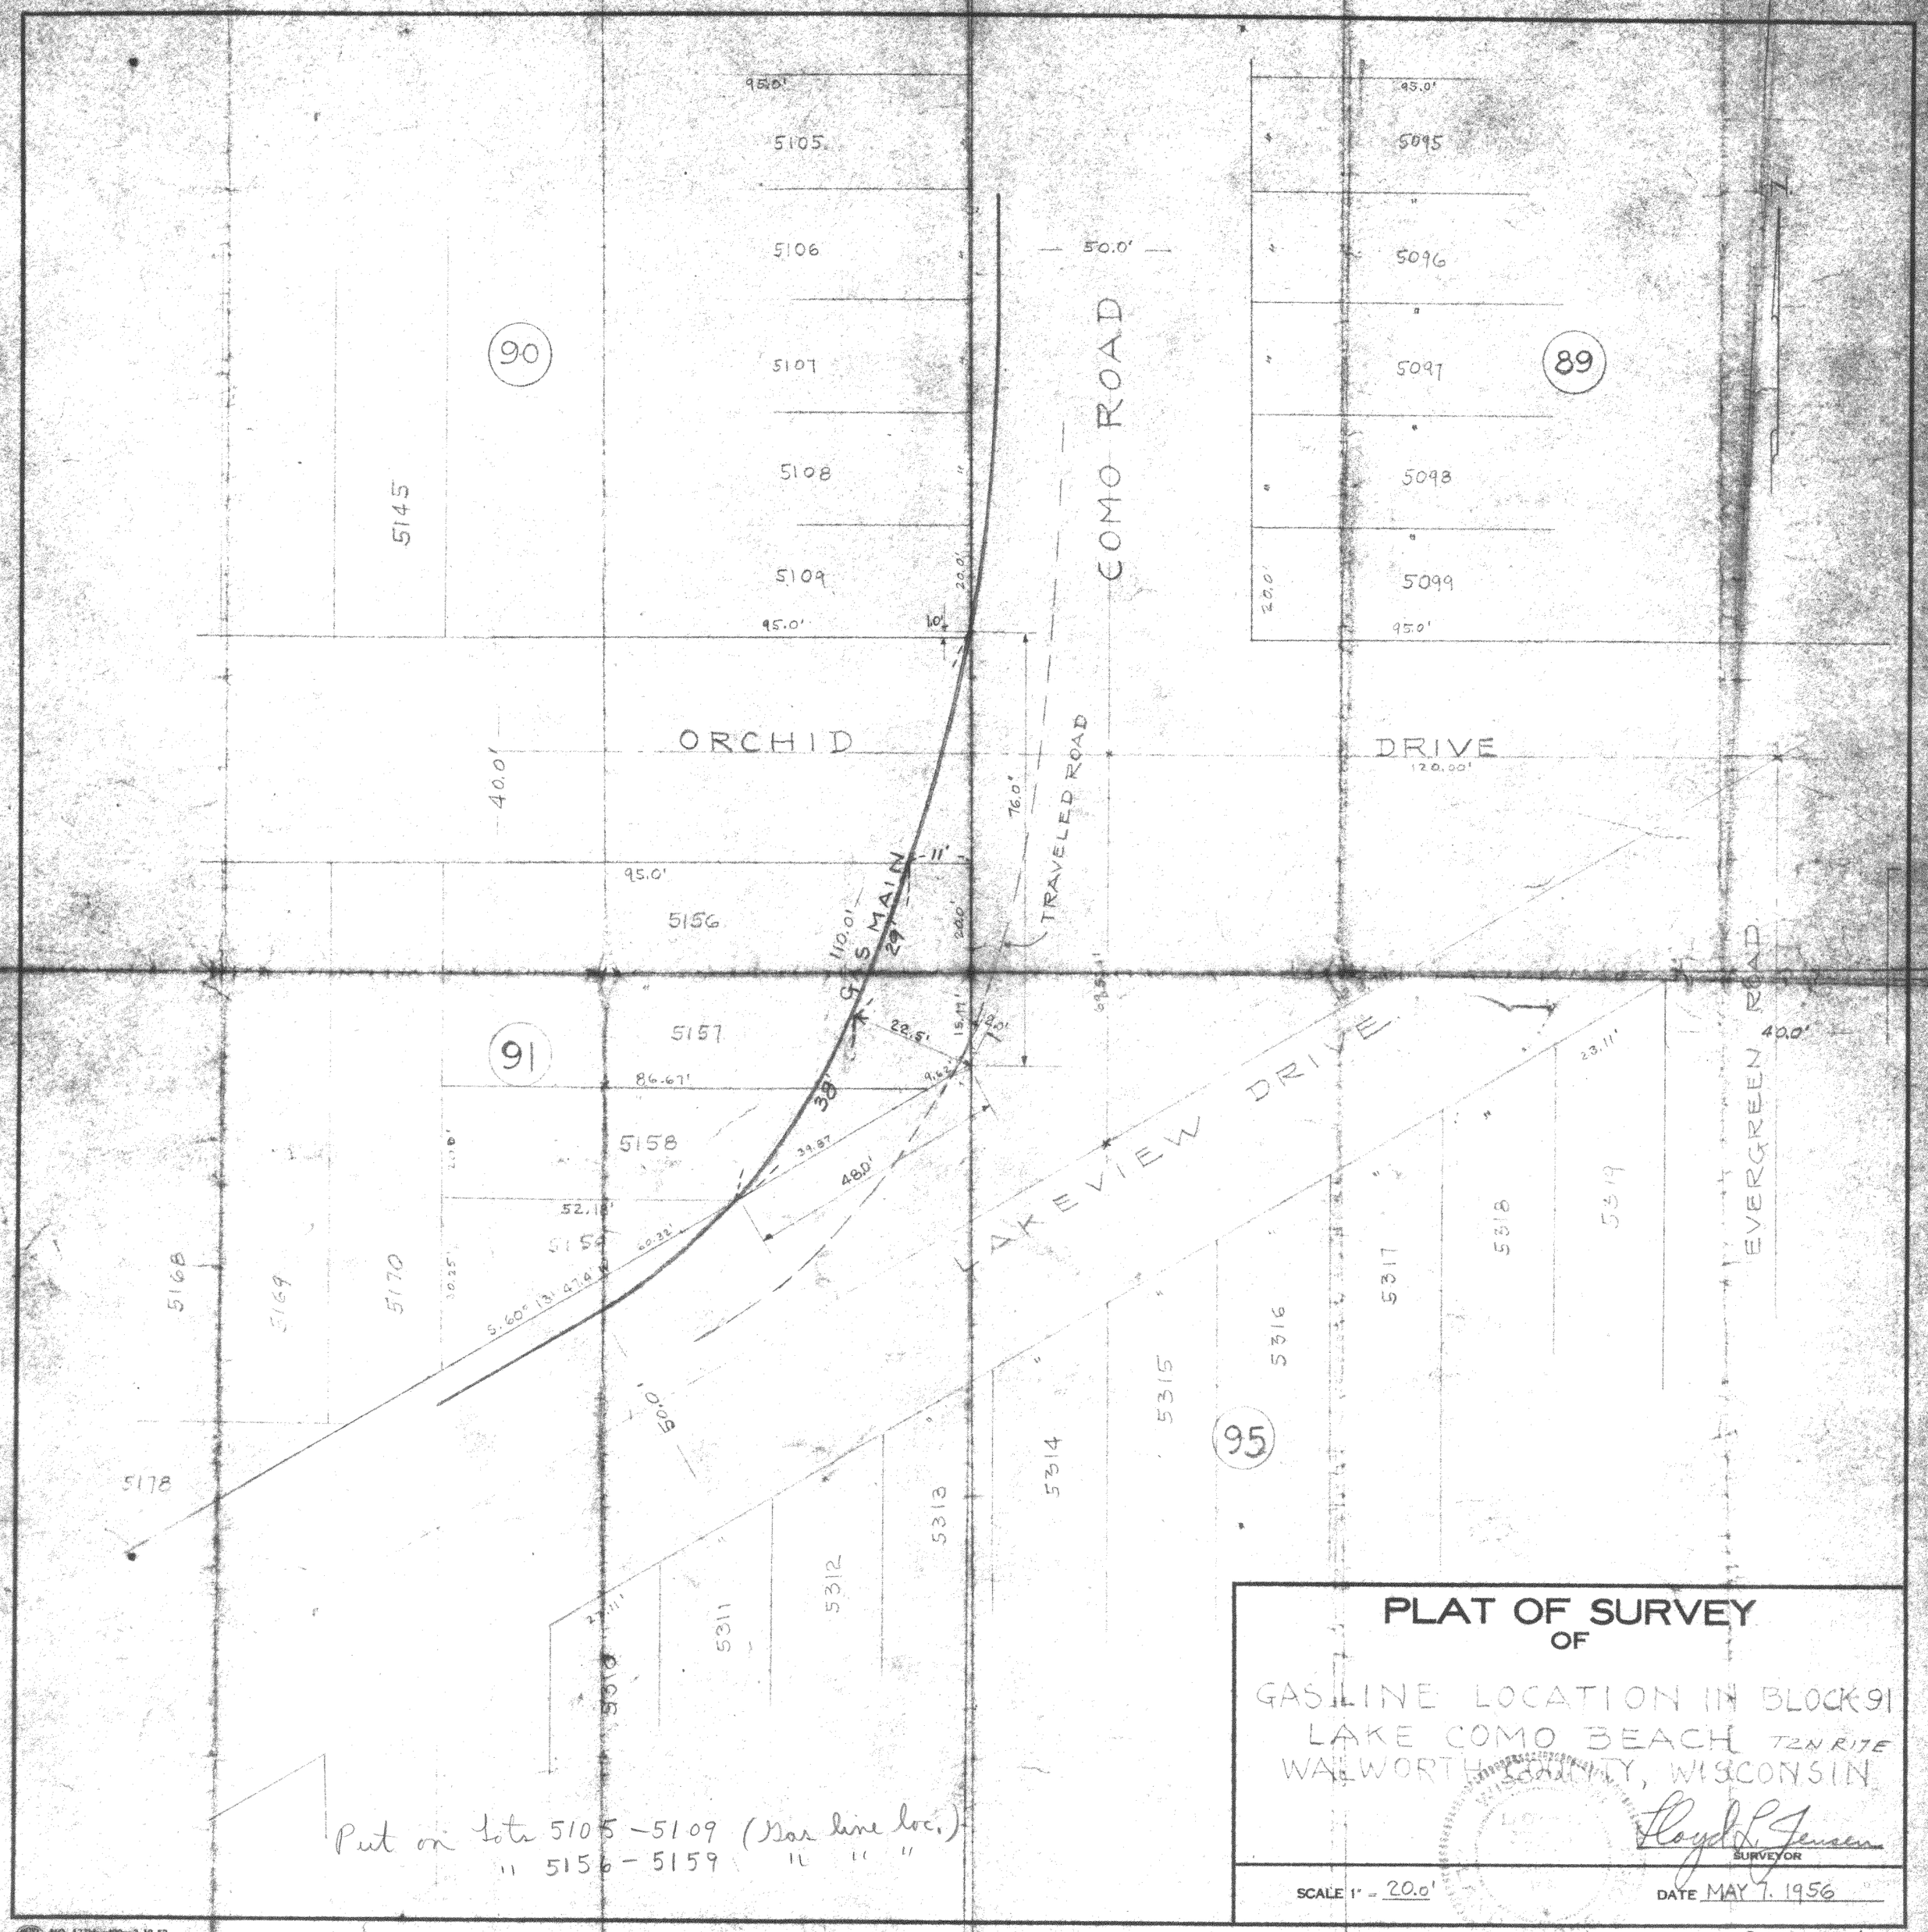

Put on lots 5105 – 5109 (Gas line loc.)
" 5156 – 5159 " " "

PLAT OF SURVEY
OF

GAS LINE LOCATION IN BLOCK 91
LAKE COMO BEACH T2N R17E
WALWORTH COUNTY, WISCONSIN

Floyd L. Jensen
SURVEYOR

SCALE 1" = 20.0'

DATE MAY 7, 1956

NO. 17744—400—3-10-53

217-73.1