61-28

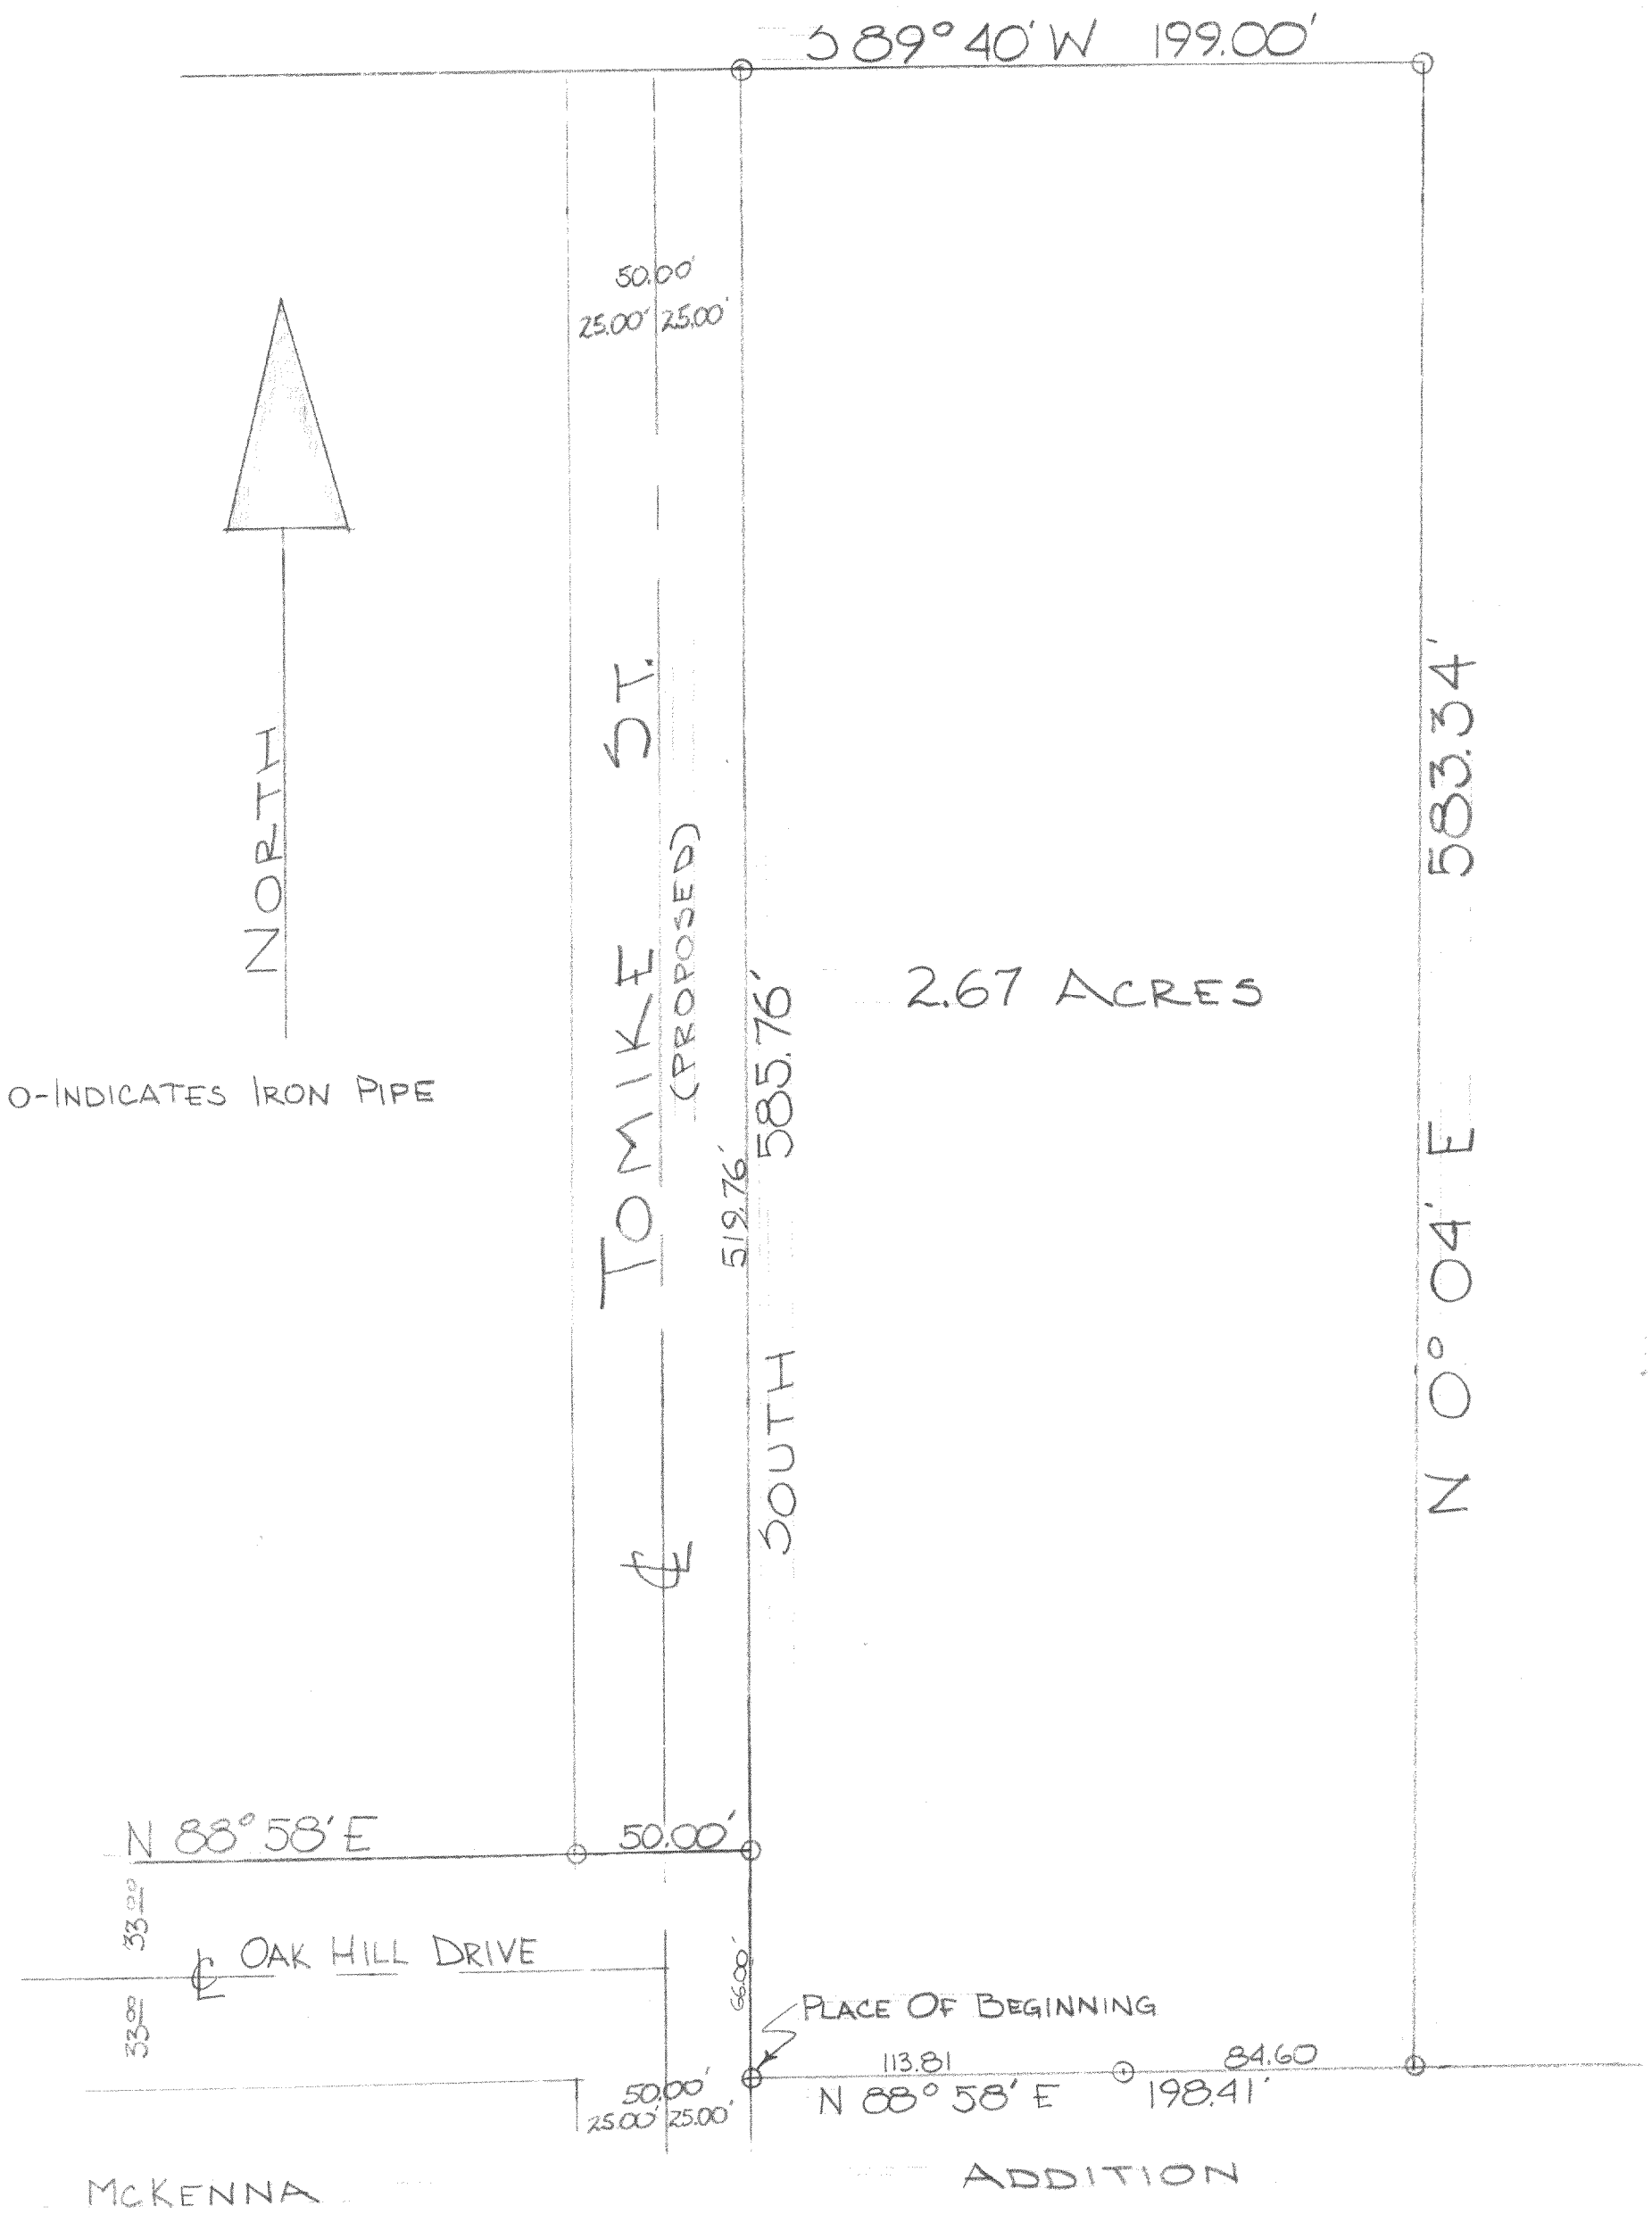


DESCRIPTION: Commencing at the W¼corner of section 25, T.2 N., R.17 E. Walworth County, Wisconsin, thence N 88° 58' E. 1266.97 feet to a point, thence N 0° 18' E. 418.85 feet to an iron stake, thence N 88° 58' E 267.85 feet to an iron stake, thence South 66.00 feet to an iron stake, the place of beginning of the lands hereinafter described; thence N 88° 58' E 198.41 feet to an iron stake, thence N 0° 04' E 583.34 feet to an iron stake, thence S 89° 40' W. 199.00 feet to an iron stake, thence South 585.76 feet to the place of beginning. ( 2.67 Acres).

CERTIFICATE: I, James F. Biagi, surveyor, do hereby certify that I have surveyed the lands hereon described on the 2nd day of December 1961.

James F. Biagi

James F. Biagi RLS 272
Elkhorn, Wisconsin

WISCONSIN
JAMES F. BIAGI
MILWAUKEE, WIS.
LAND SURVEYOR
SEAL

G-25-6K
G " 6M

217-76B