
WALWORTH COUNTY
SURVEYING & MAPPING
LAKE GENEVA, WISCONSIN

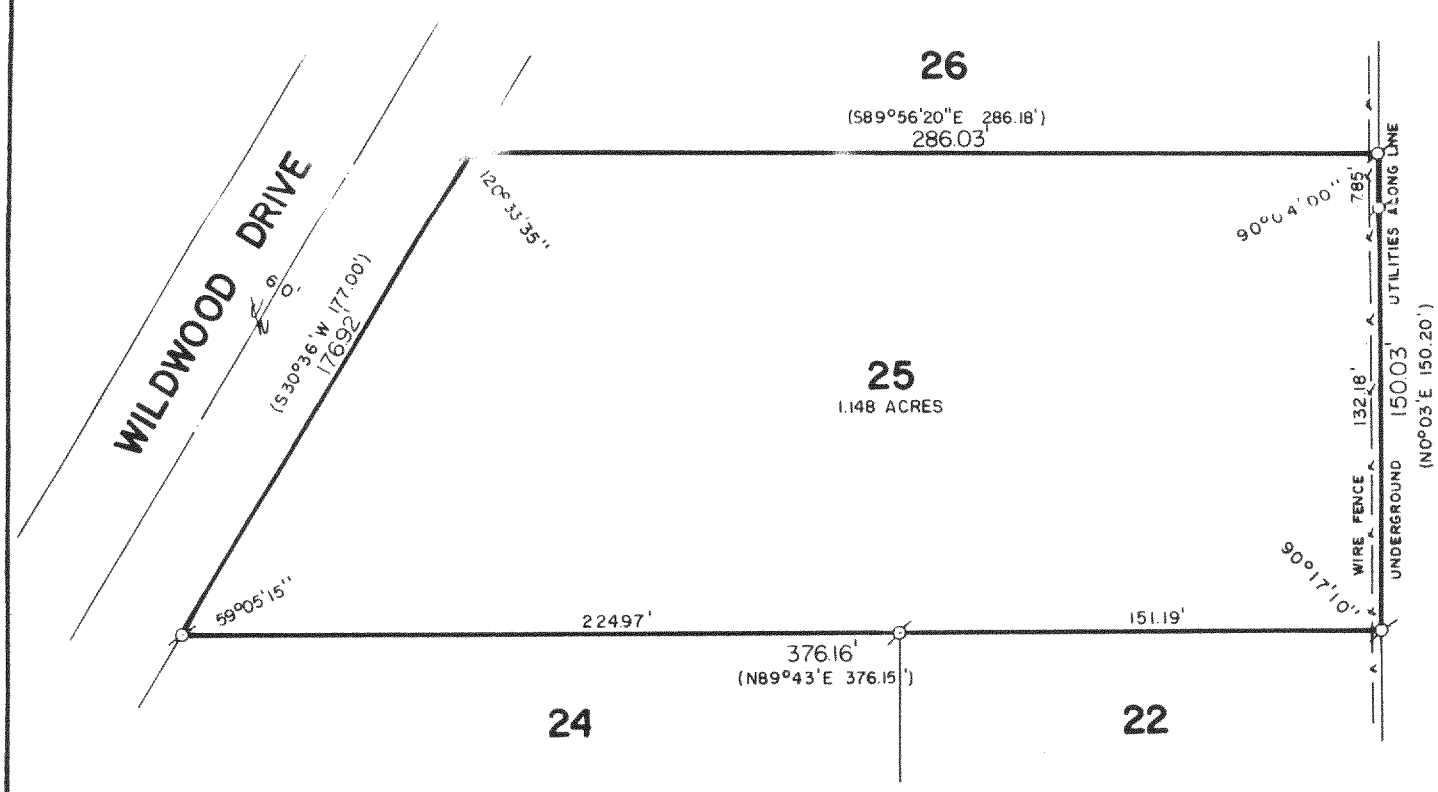

PLAT OF SURVEY OF

LOT 25 OF WILDWOOD SUBDIVISION, LOCATED IN SECTION 34, T 2 N, R 17 E, WALWORTH COUNTY, WISCONSIN.

RECEIVED
JAN 2 1991
dg

ORDERED BY: JOE KENSIK
C/O KENNETH CONNELL
415 BROAD STREET
LAKE GENEVA, WISCONSIN
53147

SCALE: 1"=60'

ø-IRON PIPE FOUND
()-RECORDED AS

I HEREBY CERTIFY THAT I HAVE SURVEYED THE ABOVE DESCRIBED PROPERTY AND THAT THE ABOVE MAP IS A TRUE REPRESENTATION THEREOF AND SHOWS THE SIZE AND LOCATION OF THE PROPERTY, ITS EXTERIOR BOUNDARIES, THE LOCATION OF ALL VISIBLE STRUCTURES AND DIMENSIONS OF ALL PRINCIPAL BUILDINGS THEREON, BOUNDARY FENCES, APPARENT EASEMENTS AND ROADWAYS AND VISIBLE ENCROACHMENTS, IF ANY.

THIS SURVEY IS MADE FOR THE EXCLUSIVE USE OF THE PRESENT OWNERS OF THE PROPERTY, AND ALSO THOSE WHO PURCHASE, MORTGAGE, OR GUARANTEE THE TITLE THERETO WITHIN ONE (1) YEAR FROM DATE HEREOF.

Robert M. Baerenwald
ROBERT M. BAERENWALD
WISCONSIN REGISTERED LAND SURVEYOR, S-1508

DATE July 17, 1989 JOB NO. 2074

NOTE: THIS IS NOT A CERTIFIED COPY UNLESS SEALED.

Survey# 217-891

TAX KEY# JWS 00024