



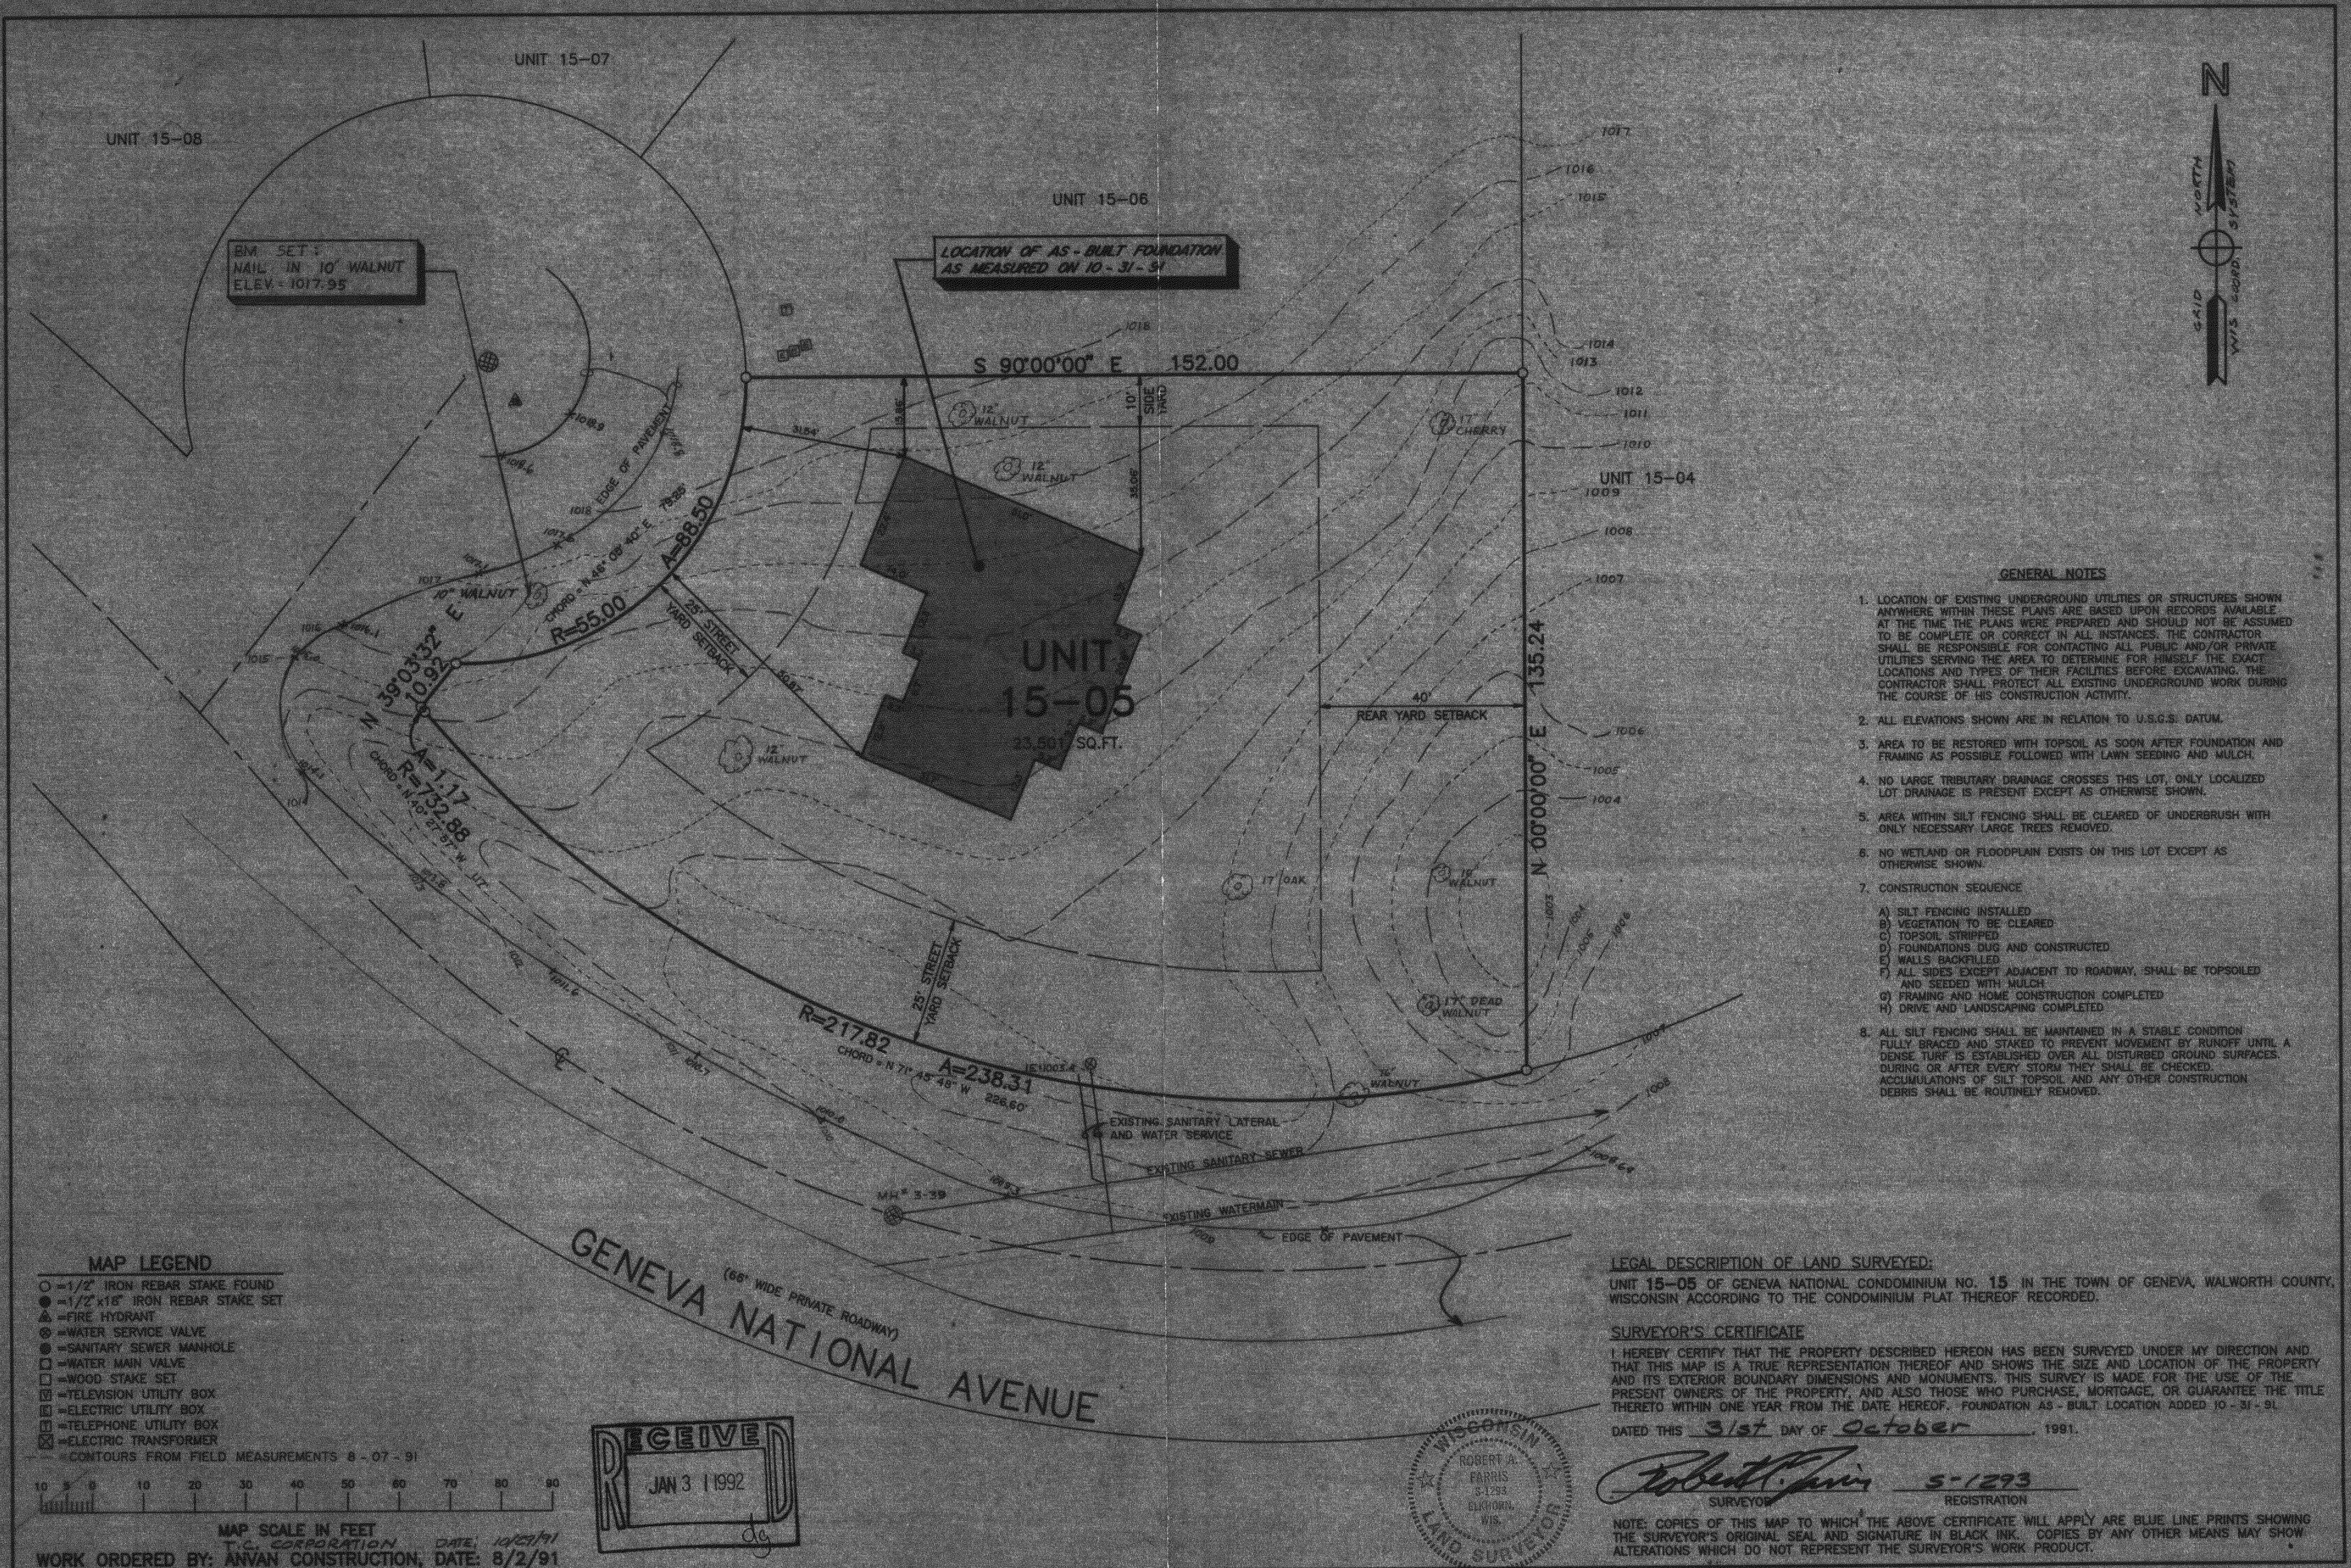

FARRIS, HANSEN & ASSOCIATES, INC.
Engineering, Architecture, Surveying
7 Ridgway Court P.O. Box 437
ELKHORN, WISCONSIN 53121
Office: (414) 723-2098
Fax: (414) 723-5886

FOUNDATION SURVEY

GENEVA NATIONAL
UNIT 15-05
1434 Geneva National Avenue
Town of Geneva, Walworth Co., Wisconsin

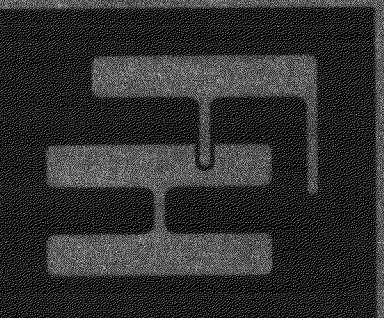

PROJECT NO. 3269.1505
DATE 08-09-91
SHEET NO. 1 of 1

REVISIONS