PLAT OF SURVEY
–OF–

LOT 25 OF TUSCANY OF LAKE GENEVA, PHASE 2, LOCATED IN THE SOUTHEAST 1/4 OF THE SOUTHWEST 1/4 AND THE NORTHEAST 1/4 OF THE SOUTHWEST 1/4 OF SECTION 34, TOWNSHIP 2 NORTH, RANGE 18 EAST AND THE NORTHEAST 1/4 OF THE NORTHWEST 1/4 OF SECTION 3, TOWNSHIP 1 NORTH, RANGE 18 EAST, WALWORTH COUNTY, WISCONSIN.

SURVEY FOR: THOMAS NESSLING
SURVEY ADDRESS: 3390 VIA CASSIO

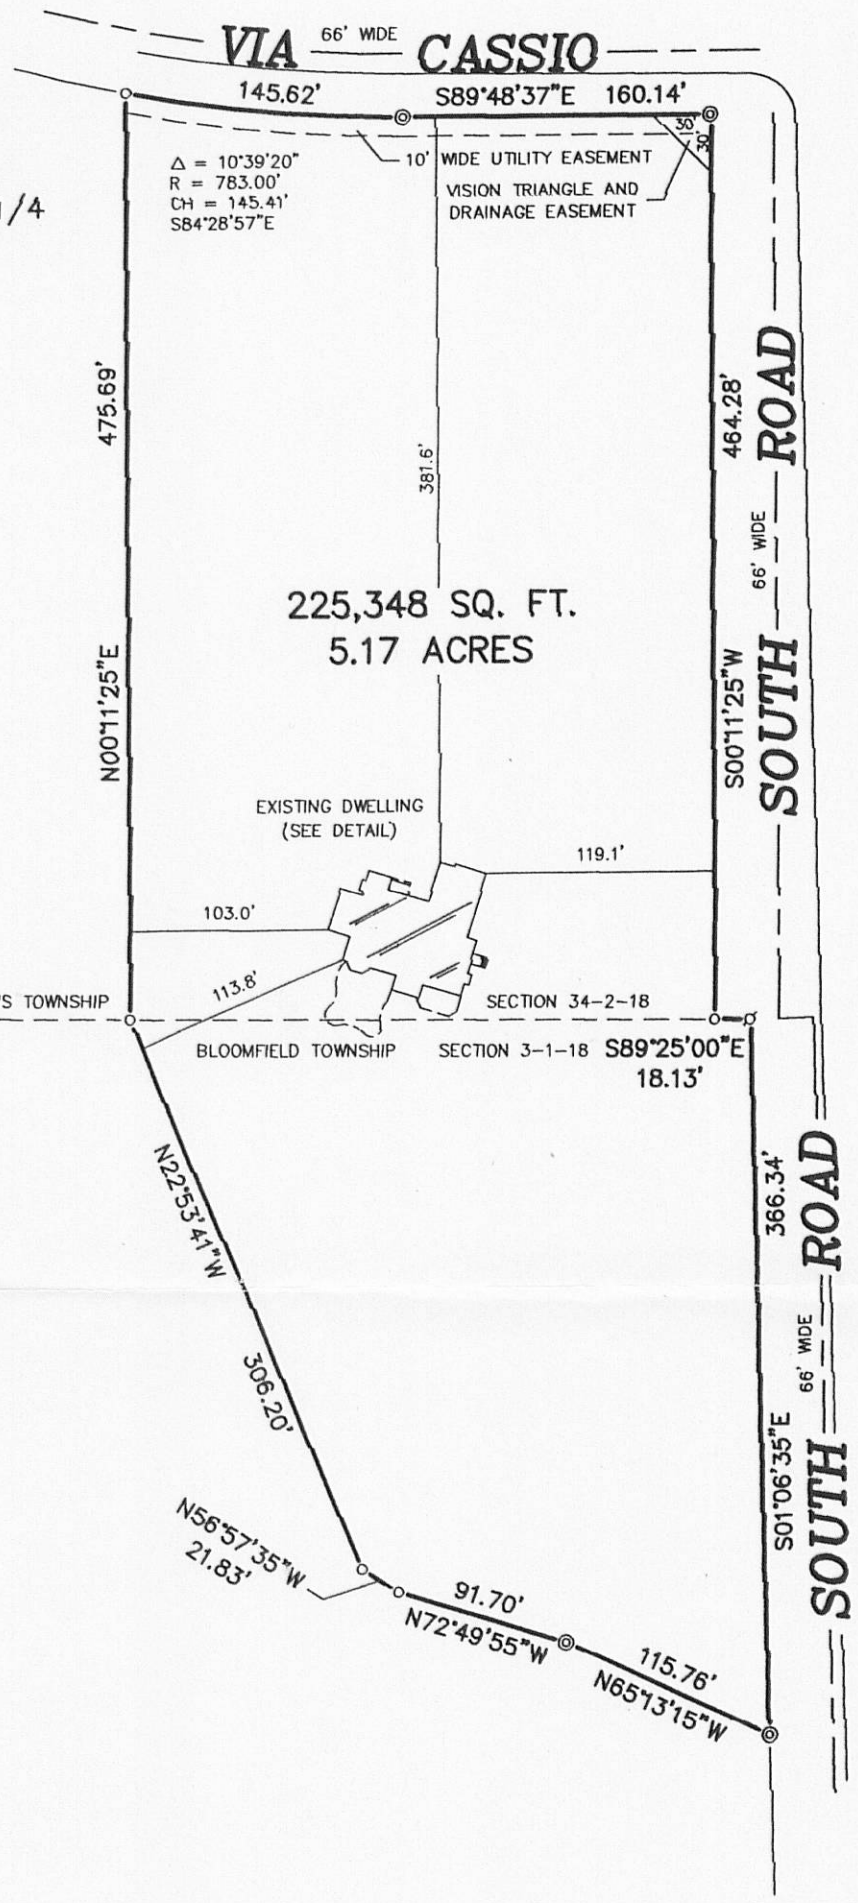

DETAIL

SCALE: 1" = 30'

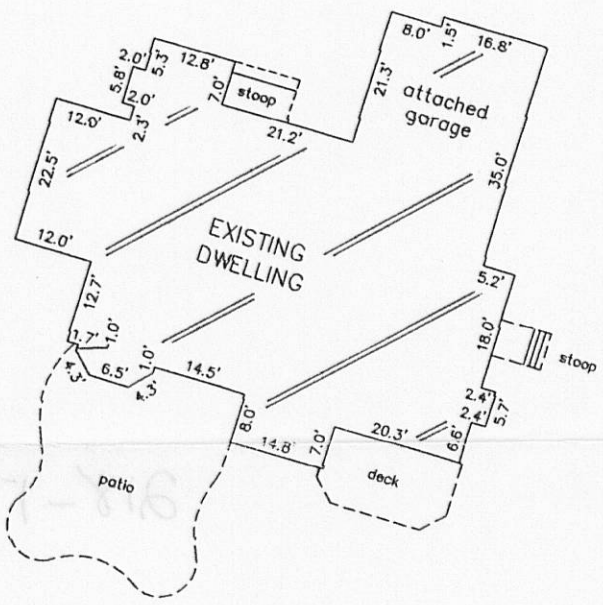

LEGEND

◎ FOUND 2" DIA. IRON PIPE

o FOUND 1" DIA. IRON PIPE

ø FOUND 3/4" DIA. IRON ROD

SCALE: 1" = 100'

"I hereby certify that I have surveyed the above described property and that the above map is a correct representation thereof and shows the size and location of the property, its exterior boundaries, the location of all visible structures and dimensions of all principal buildings thereon, boundary fences, apparent easements, roadways and encroachments, if any."

"This survey is made for the use of the present owners of the property, and those who purchase, mortgage, or guarantee the title thereto within one year from date hereof."

RECEIVED
AUG 26 2010

WISCONSIN
ROBERT J. WETZEL
S-1778
BURLINGTON, WI
LAND SURVEYOR

THIS IS NOT AN ORIGINAL PRINT UNLESS THIS SEAL IS RED.

B.W. SURVEYING, INC.
LAND SURVEYS
MAPPING AND PLANNING
412 N. PINE STREET
BURLINGTON, WI 53105
(262)–767–0225

Robert J. Wetzel
ROBERT J. WETZEL S-1778

JULY 21, 2010 — DATE

8212 — JOB NUMBER

MTU2-1 NTU2-1

218-1753