


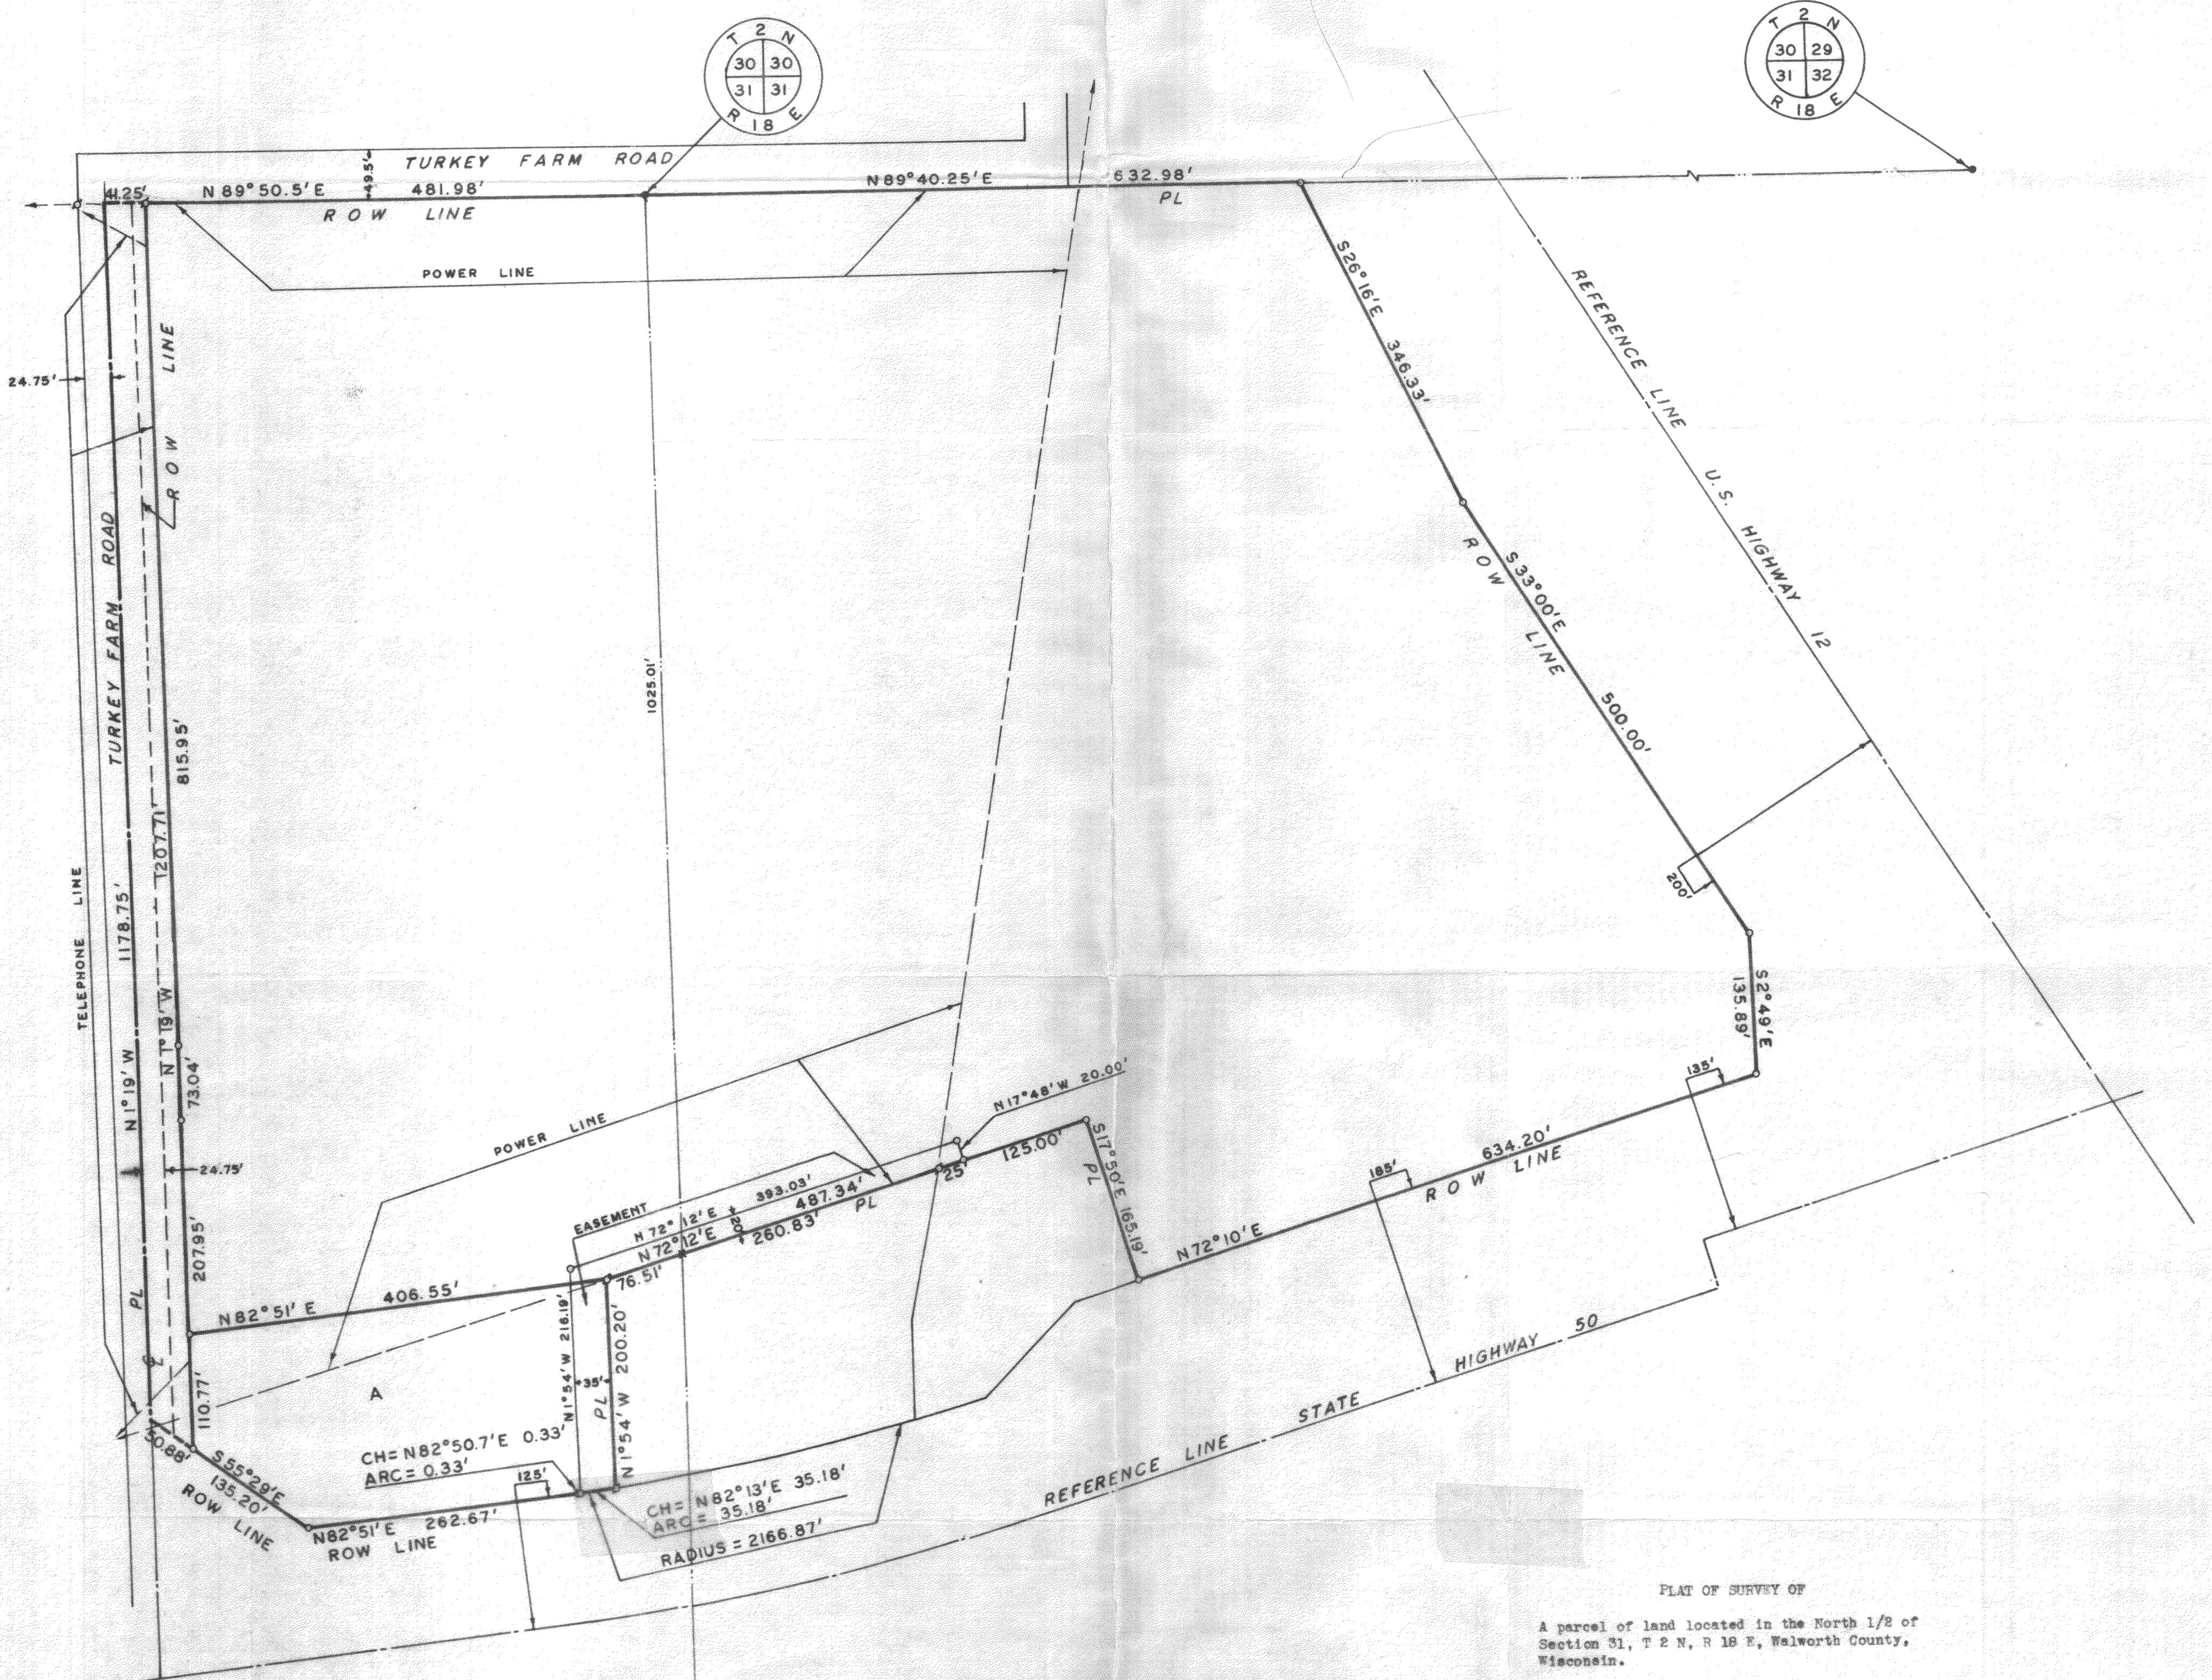


N
SCALE 1"=100'

- LEGEND
- - Concrete Monument Found
 - o - Iron pipe found
 - x - Spike placed
 - ROW - Right of Way
 - PL - Property line

NOTE: Land subject to zoning restrictions and set-back lines of the: State Highway Commission Walworth County If annexed- City of Lake Geneva. Copies of zoning regulations will be furnished upon request.

49-31-1
31-2A-2
4-2A-1

(See next page for further revisions)
218-112
218-59

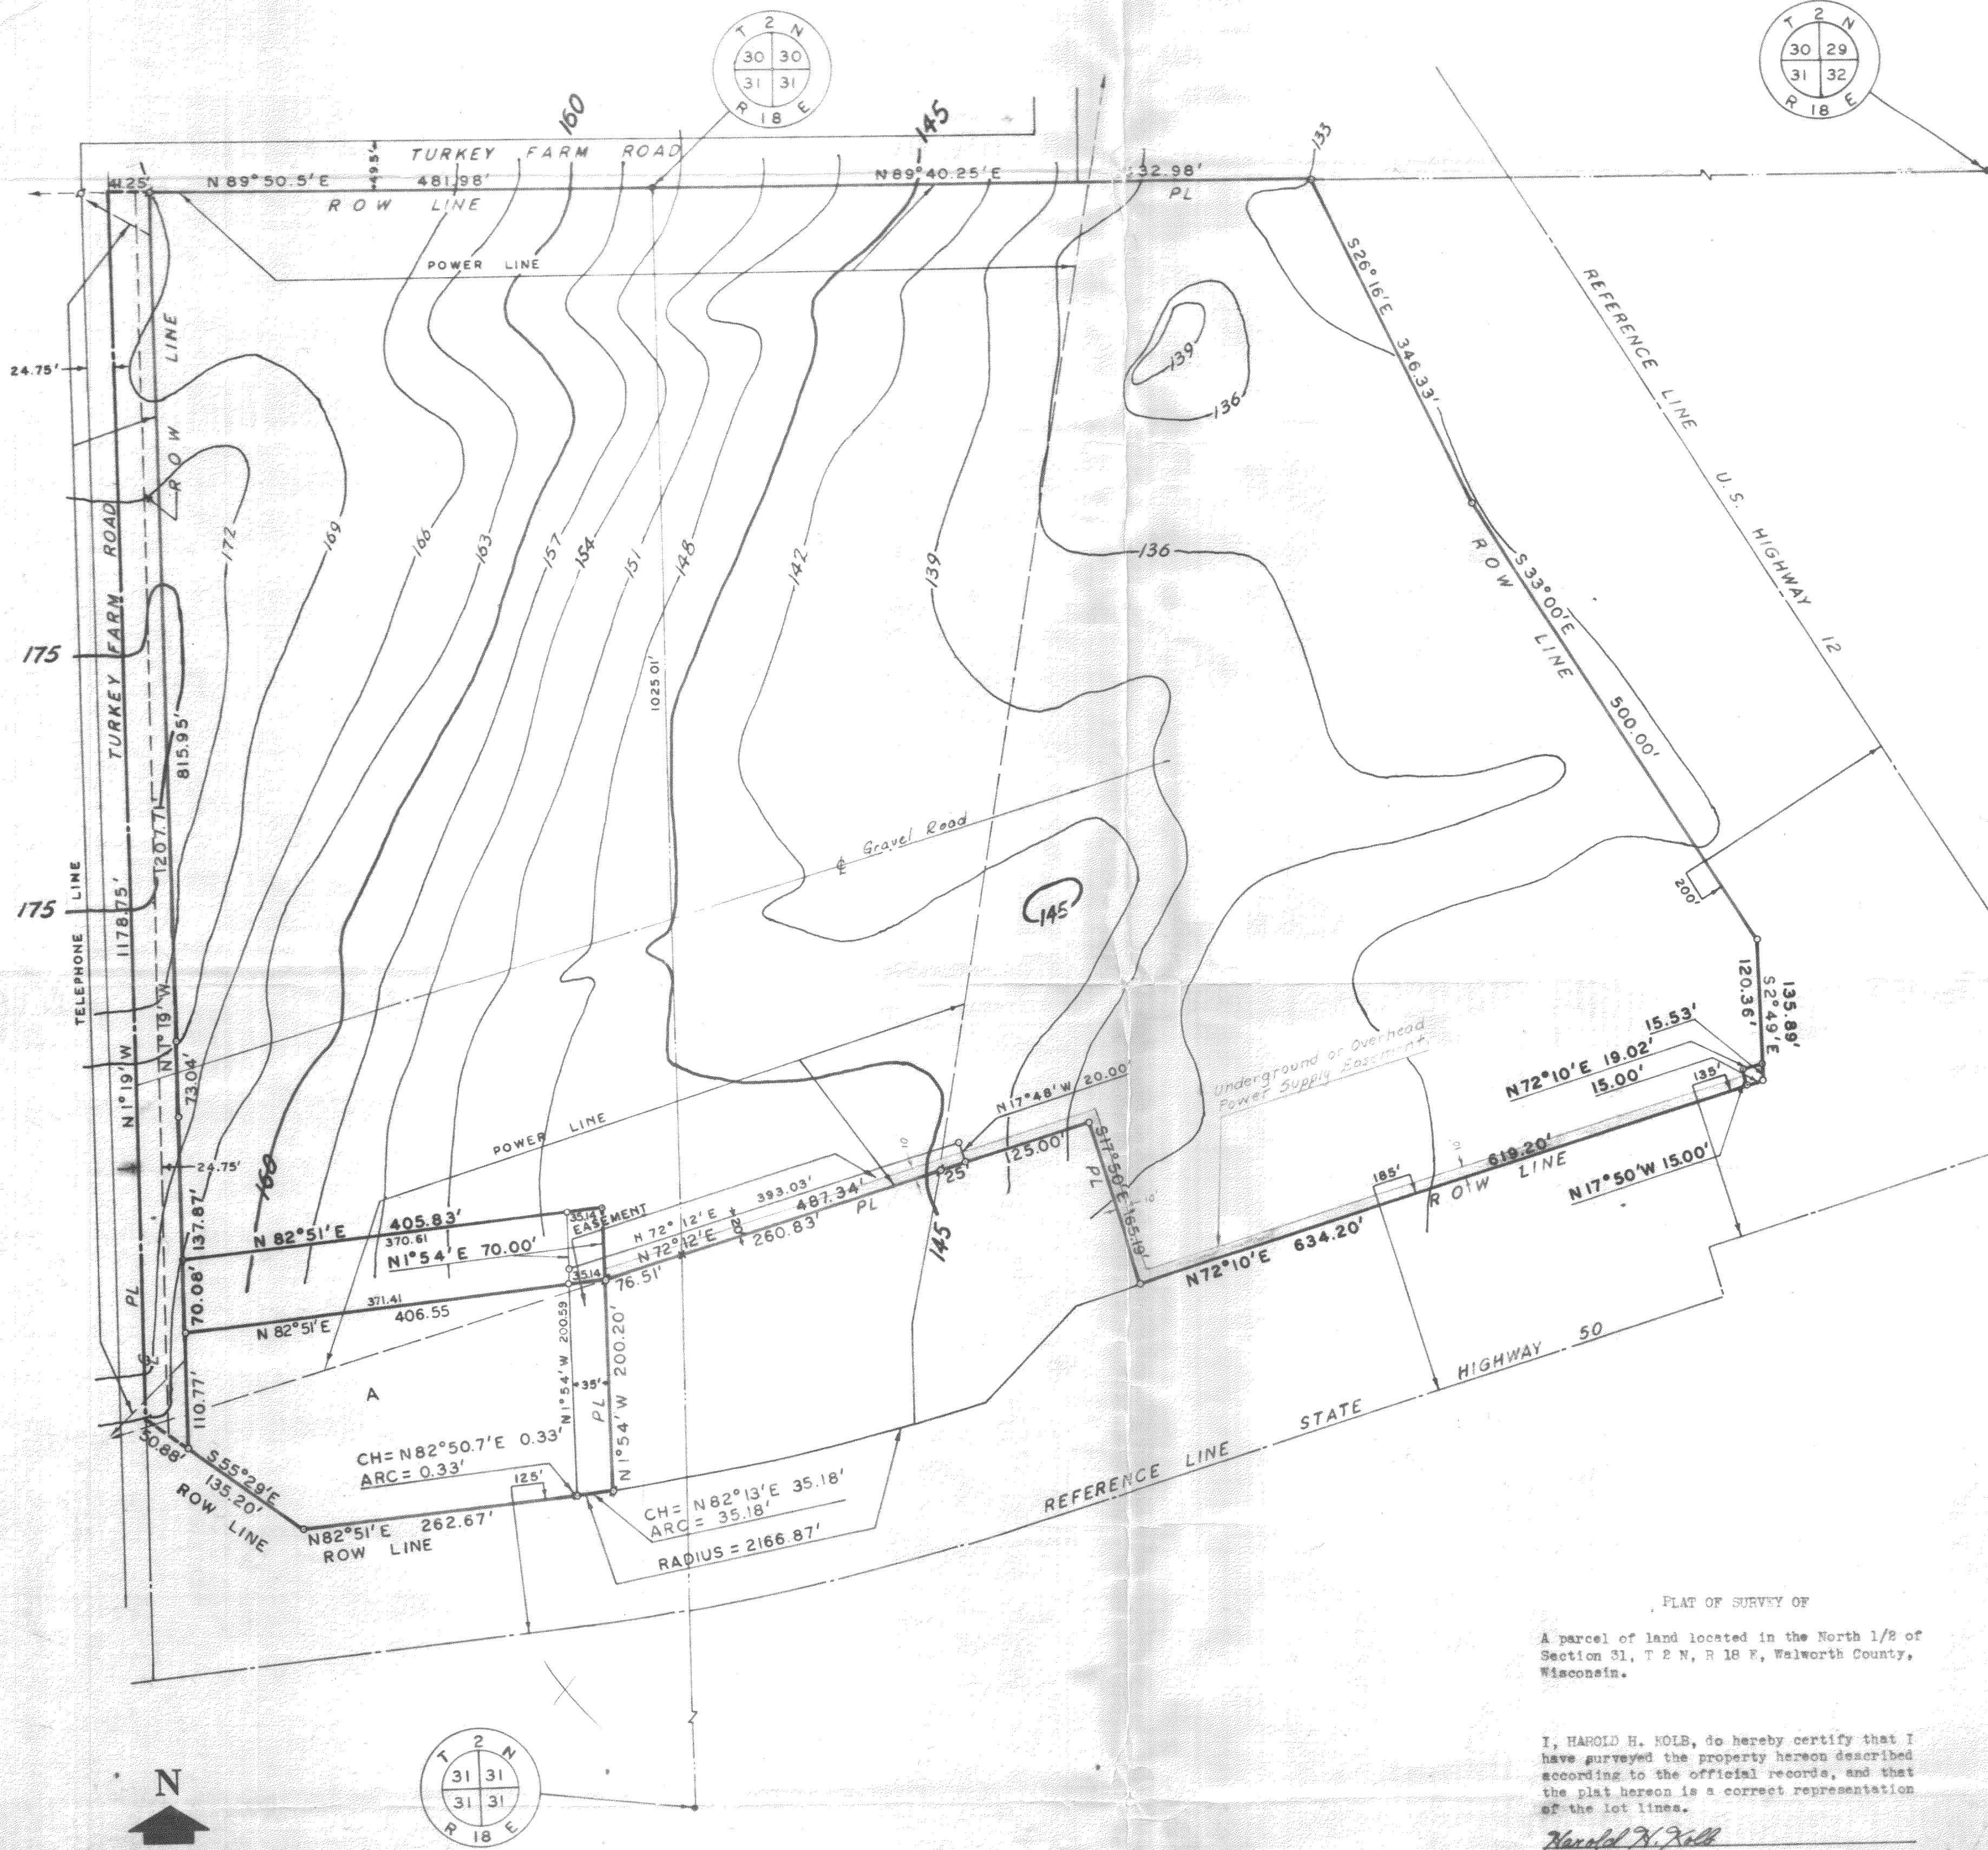

- LEGEND
- - Concrete Monument Found
 - - Iron pipe found
 - - Iron pipe placed
 - x - Spike placed
 - - Right of Way
 - PL - Property line
 - - Iron rod placed

NOTE: Land subject to zoning restrictions and
set-back lines of the:
State Highway Commission
Walworth County
If annexed - City of Lake Geneva.
Copies of zoning regulations will be
furnished upon request.

CONTOUR INTERVAL - 3'