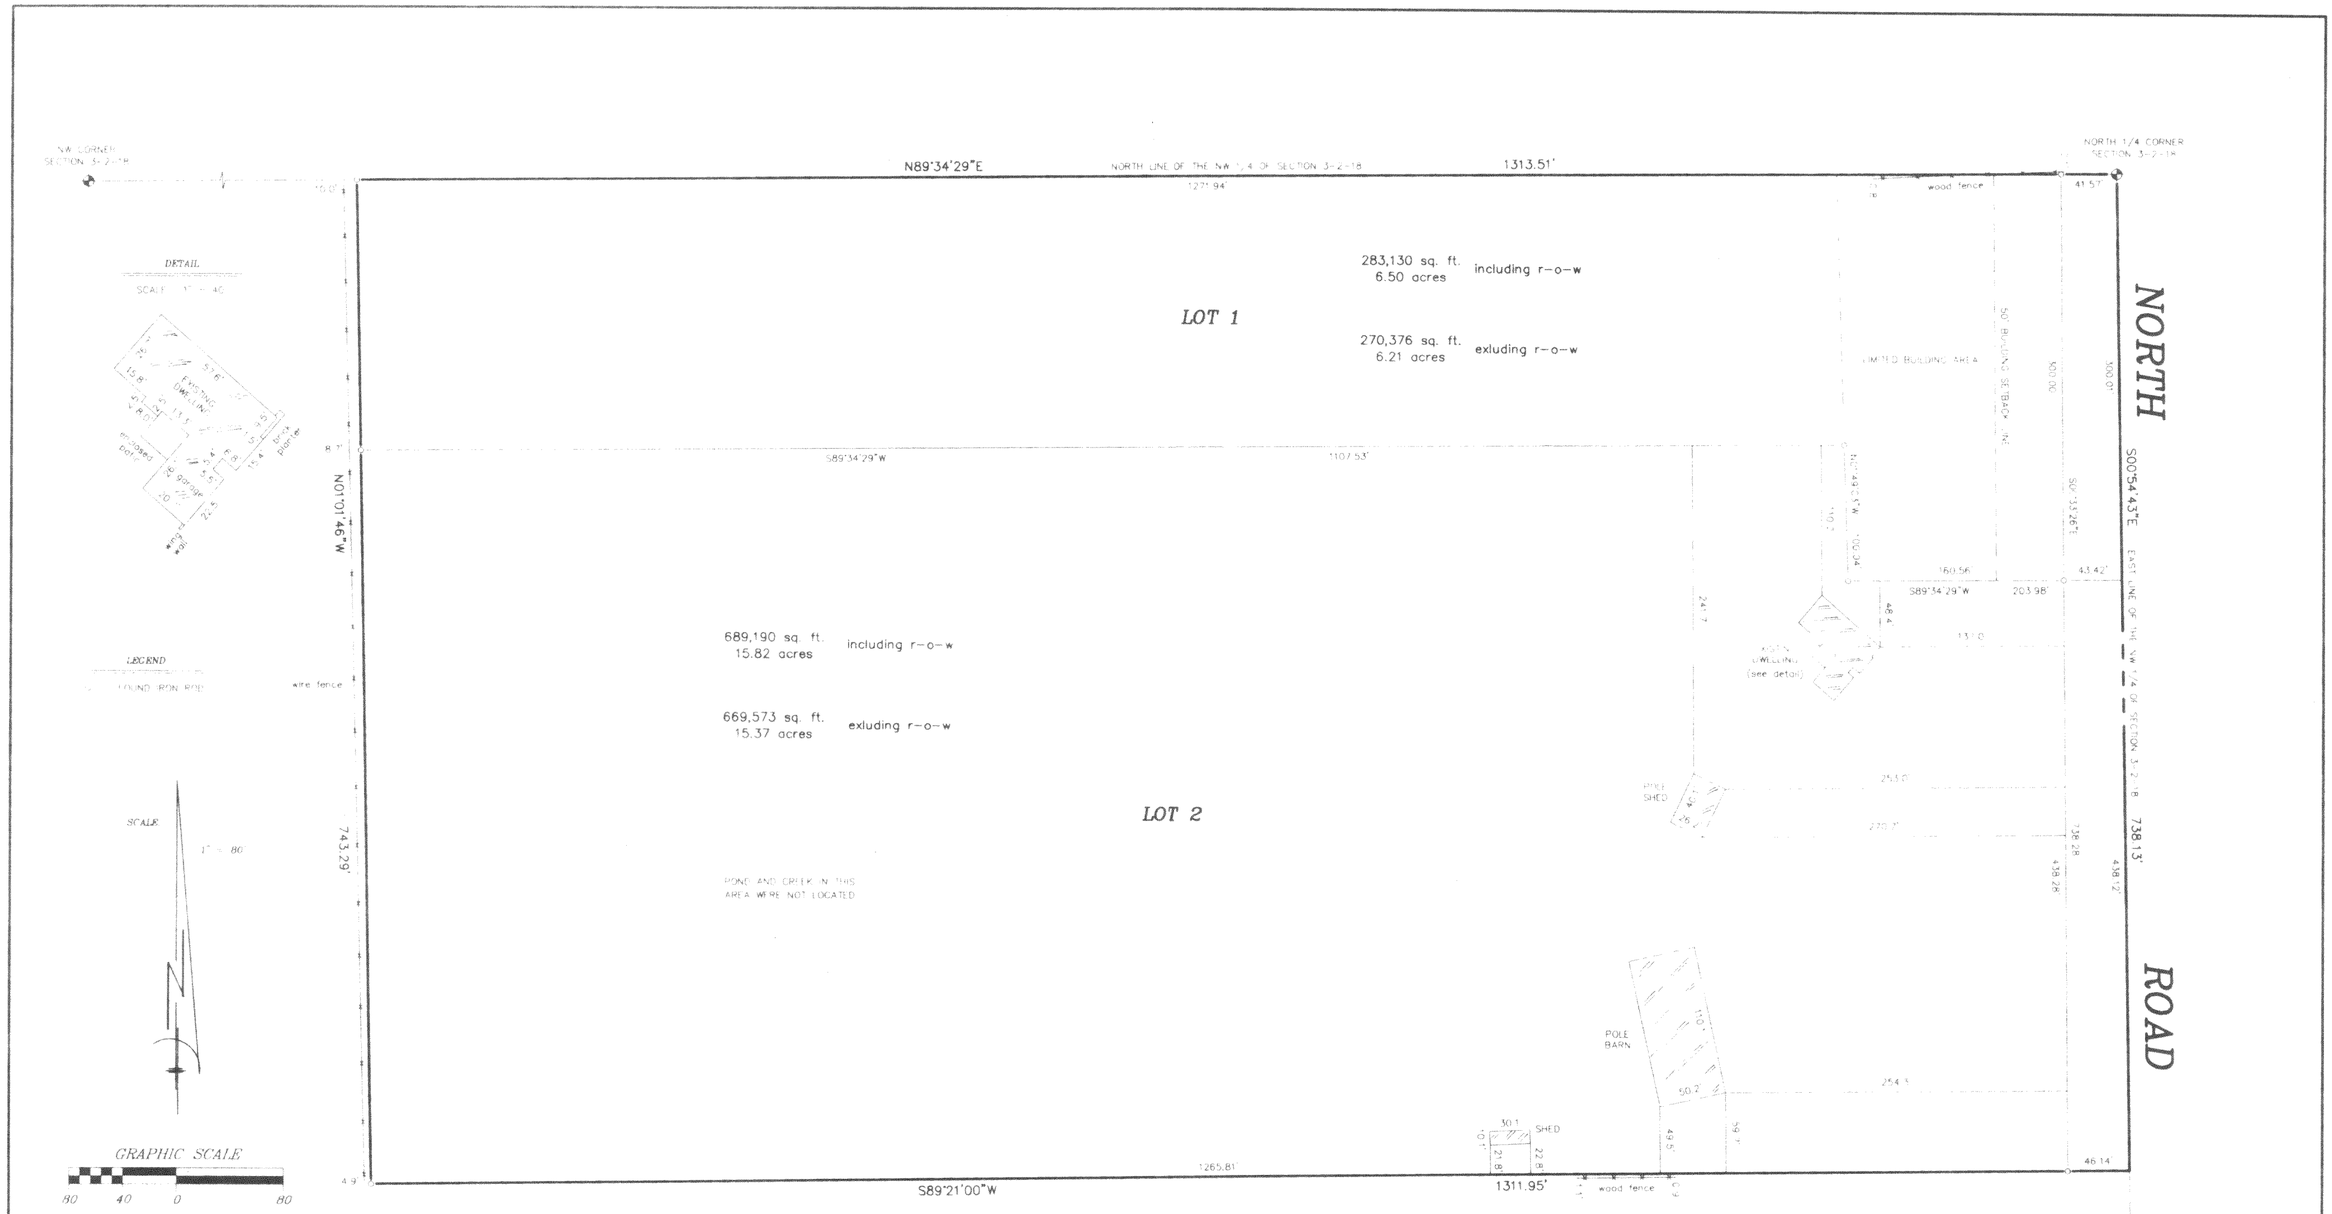

"I hereby certify that I have surveyed the above described property and that the above map is a correct representation thereof and shows the size and location of the property, its exterior boundaries, the location of all visible structures and dimensions of all principal buildings thereon, boundary fences, apparent easements, roadways and encroachments, if any."

"This survey is made for the use of the present owners of the property, and those who purchase, mortgage, or guarantee the title thereto within one year from date hereof."

PLAT OF SURVEY
-OF-

LOTS 1 AND 2 OF CERTIFIED SURVEY MAP NO. 2894, RECORDED IN VOLUME 15 OF CERTIFIED SURVEY MAPS, PAGE 113 AND BEING PART OF THE NORTHEAST 1/4 OF THE NORTHWEST 1/4 OF SECTION 3, TOWNSHIP 2 NORTH, RANGE 18 EAST. SAID LAND BEING IN THE TOWN OF LYONS, COUNTY OF WALWORTH AND STATE OF WISCONSIN.

SURVEY FOR: TERRY KLUG
SURVEY LOCATION: 1046 NORTH ROAD

RECEIVED
DEC 16 1999

WISCONSIN
ROBERT J. WETZEL
S-1778
BURLINGTON WIS.
LAND SURVEYOR

ROBERT J. WETZEL S-1778

B.W. SURVEYING

412 N. PINE STREET
BURLINGTON, WI 53105
(414)-767-0225

DRAWN BY:	TLS	DATE:	JULY 27, 1999
CHECKED BY:	BJW	DRAWING NO.:	4098d1
JOB NO.:	4098	SHEET 1 OF 1	

NA-2894-1
NA-2894-2

218-1125