PLAT OF SURVEY

PATHFINDER SURVEYING
FORMERLY KOLB LAND CONSULTING
929 WILLIAMS STREET LAKE GENEVA, WI. 53147
(262) 248-3697


ORDERED BY: R J AMANN BUILDERS

DATE: 1-7-2000

DESCRIPTION: LOT 2 OF CERTIFIED SURVEY MAP NO. 1188 A C.S.M. BEING LOT 5 OF LYON'S INDUSTRIAL PARK AND LOCATED IN THE SE 1/4 OF SECTION 19, T2N, R18, WALWORTH COUNTY, WISCONSIN.

RECEIVED
FEB 7 2000

0 30
SCALE 1"=30'
BEARINGS REFERENCED TO C.S.M NO 1188

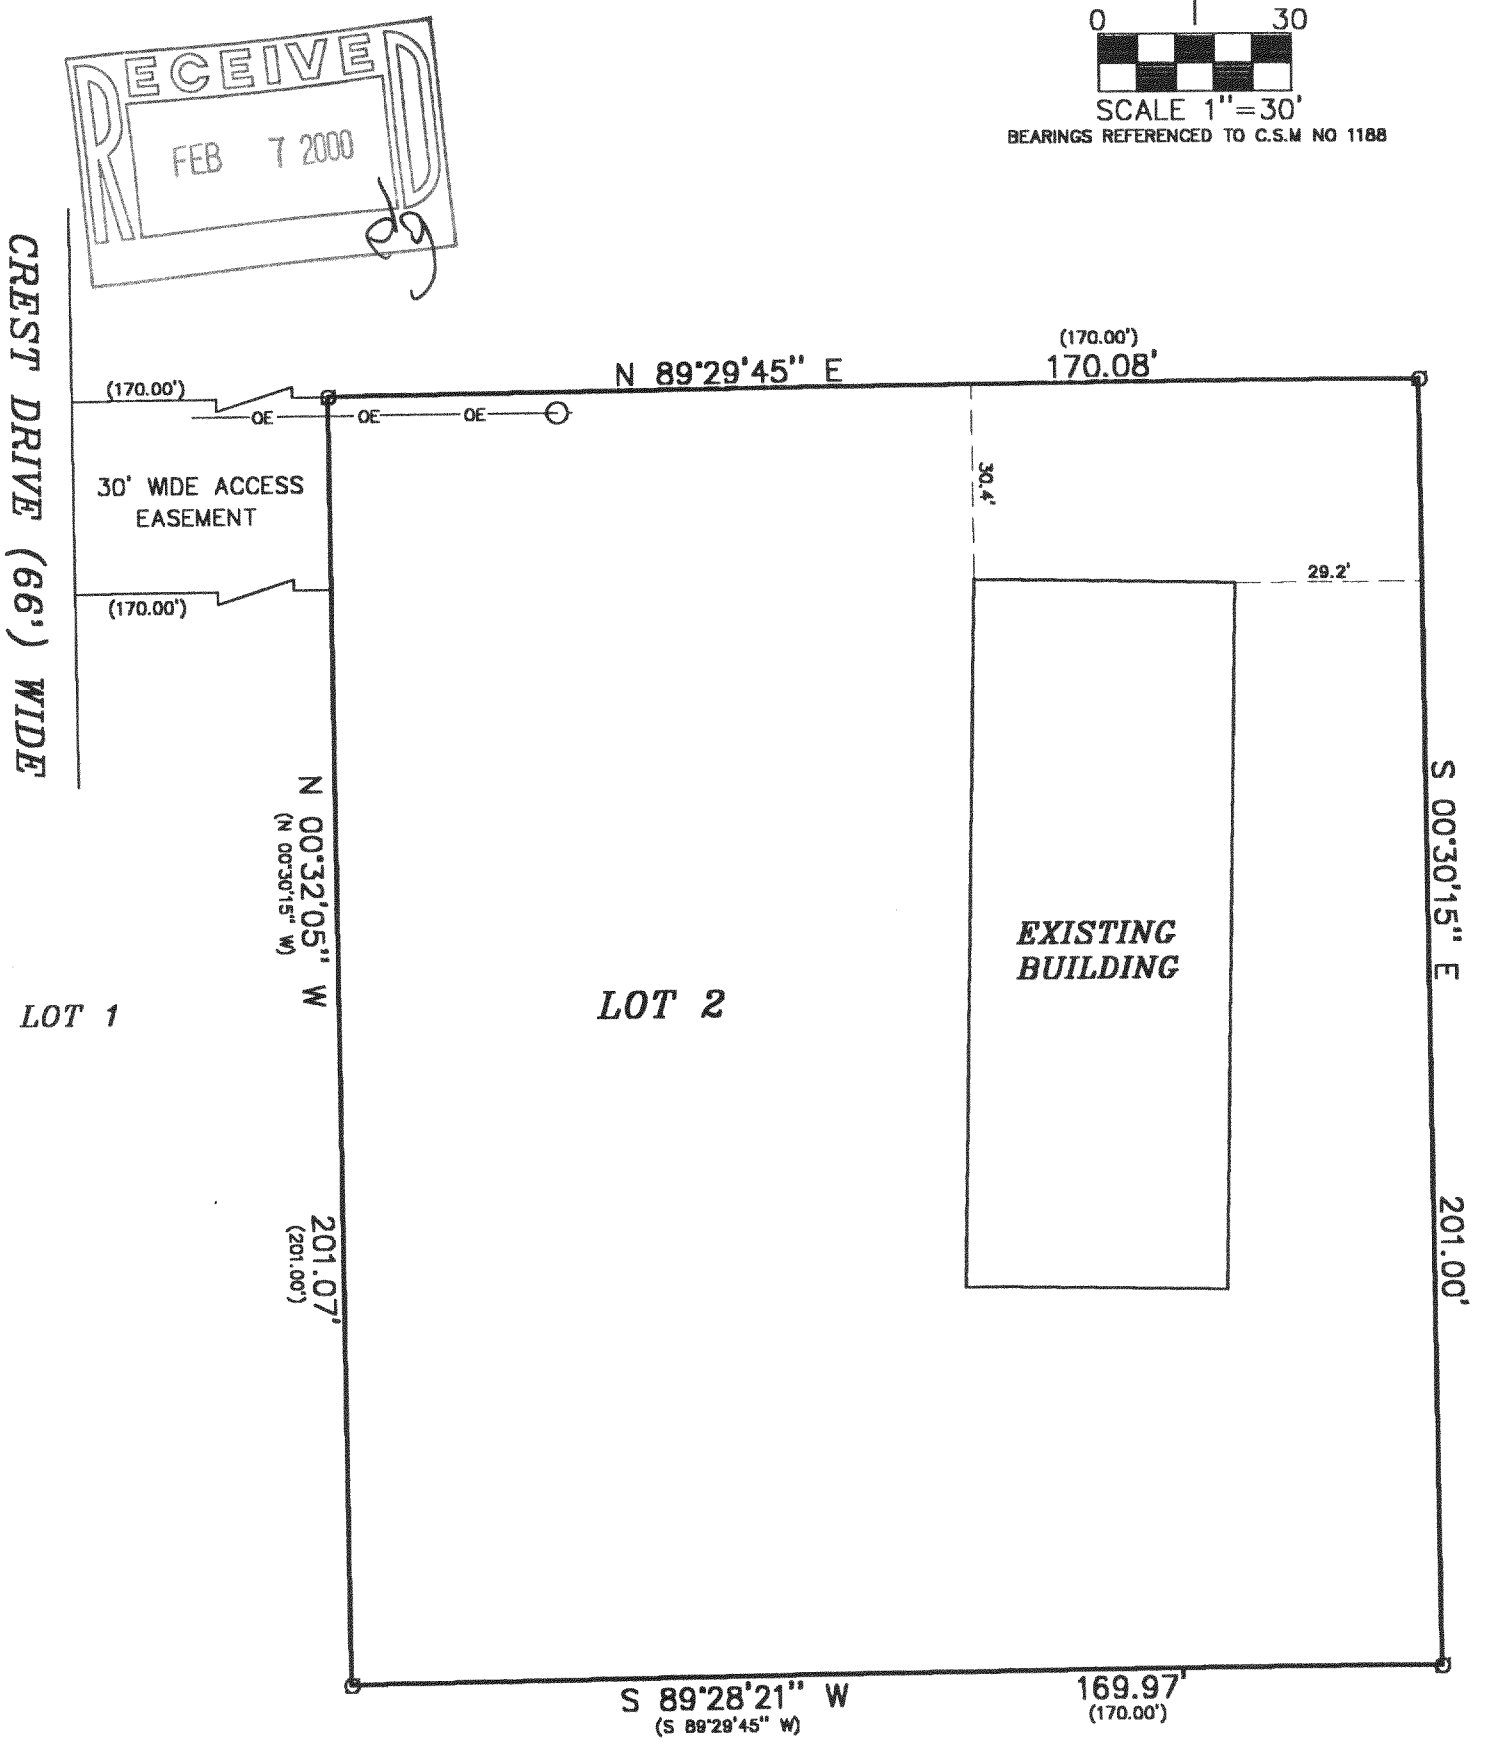

THE ABOVE MAP IS A TRUE REPRESENTATION THEREOF AND SHOWS THE SIZE AND LOCATION OF ALL THE PROPERTY, EXTERIOR BOUNDARIES, THE LOCATION OF ALL VISIBLE BOUNDARY FENCES , APPARENT EASEMENTS , ROADWAYS AND VISIBLE ENCROACHMENTS , IF ANY

THIS SURVEY IS MADE FOR THE USE OF THE PRESENT OWNERS OF THE PROPERTY , AND ALSO THOSE WHO PURCHASE , MORTGAGE OR GURANTEE TITLE THERETO WITHIN ONE (1) YEAR FROM DATE HERETO.

John P Krott

JOHN P. KROTT , R.L.S. 2258

LEGEND

⊙	FOUND IRON PIPE
⊙	POWER POLE
(XXXXX)	RECORDED AS
—OE—	OVERHEAD UTILITIES

WISCONSIN
JOHN P. KROTT
S-2258
MUKWONAGO, WIS.
LAND SURVEYOR

NOTE: THIS IS NOT A CERTIFIED COPY UNLESS SEAL IS IN RED.

JOB NUMBER # 99299 NA 1188 00002

NA-1188-2 218-1139