
DEGEN, FOAT SURVEYING ASSOCIATES
100 SOUTH SECOND STREET
WATERFORD, WISCONSIN
(414)534-5404 (FAX)534-2022

993251
993251S1.DWG

PLAT OF SURVEY

LOT 1 OF WALWORTH COUNTY CERTIFIED SURVEY MAP NO. 1687, RECORDED IN VOLUME 8 OF CERTIFIED SURVEY MAPS ON PAGES 61, 62 AND 63, AND BEING PART OF THE NORTHEAST 1/4 OF THE SOUTHWEST 1/4 OF SECTION 12, TOWN 2 NORTH, RANGE 18 EAST OF THE FOURTH PRINCIPAL MERIDIAN, TOWNSHIP OF LYONS, WALWORTH COUNTY, WISCONSIN.

SURVEY PREPARED FOR: MARK & ESTELLA MARKISEN
115 SAN SALVADOR STREET
NAPLES, FL 34113

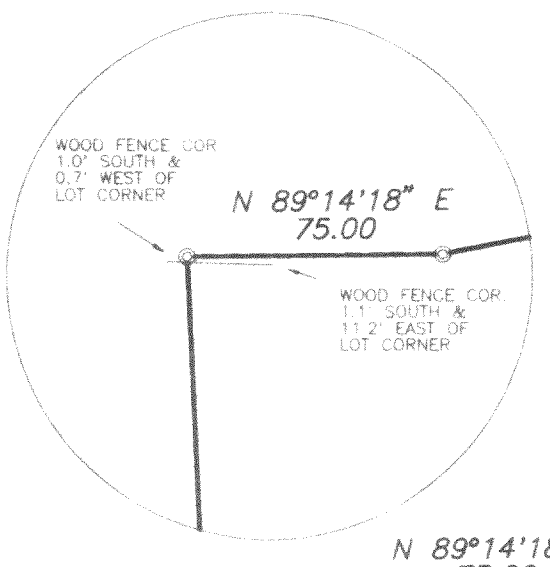


RECEIVED
FEB 8 2000

SCALE: 1" = 100'

BEARING BASE: AS RECORDED AS.

LEGEND

◎ - FOUND IRON PIPE
○ - SET IRON PIPE
-x- - FENCE
( ) - RECORDED AS

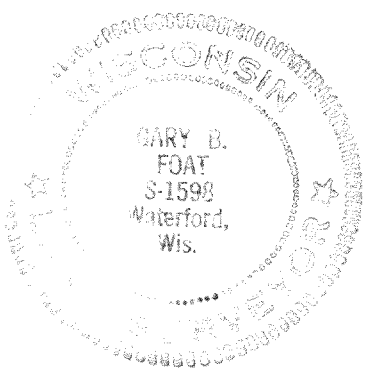

I HEREBY CERTIFY THAT I HAVE SURVEYED THE ABOVE DESCRIBED PROPERTY AND THE ABOVE MAP IS A TRUE REPRESENTATION THEREOF AND SHOWS THE SIZE AND LOCATION OF THE PROPERTY, THE LOCATION OF ALL VISIBLE STRUCTURES AND DIMENSIONS OF ALL PRINCIPAL BUILDINGS THEREON, BOUNDARY FENCES, APPARENT EASEMENTS, ROADWAY AND VISIBLE ENCROACHMENTS, IF ANY

THIS SURVEY IS MADE FOR THE PRESENT OWNERS OF THE PROPERTY, AND ALSO THOSE WHO PURCHASE, OR GUARANTEE THE TITLE THERETO WITHIN (1) YEAR FROM THE DATE HEREOF.

DATED AT WATERFORD, WI THIS 30th DAY OF AUGUST 19 99

RECERTIFIED

NA-1687-1

218-1146