993360
993360S1.DWG

DEGEN, FOAT SURVEYING ASSOCIATES


100 SOUTH SECOND STREET
WATERFORD, WISCONSIN
(262)534-5404 (FAX)534-2022

PLAT OF SURVEY

LOTS 15 AND 16, ORIGINAL PLAT OF LYONS ON EAST SIDE OF WHITE RIVER, ACCORDING TO THE RECORDED PLAT THEREOF. SAID LAND BEING IN THE TOWN OF LYONS, COUNTY OF WALWORTH AND STATE OF WISCONSIN.

SURVEY PREPARED FOR: NEAL AND REGINA LARA
1438 GREENFIELD AVE.
BURLINGTON, WI 53105

NOTE: THIS PARCEL IS NOT IN THE 100 YEAR FLOOD PLAIN PER WALWORTH COUNTY FLOOD INSURANCE RATE MAP, PANEL 95 OF 145, COMMUNITY-PANEL NUMBER 550462 0095B DATED AUG. 15, 1983

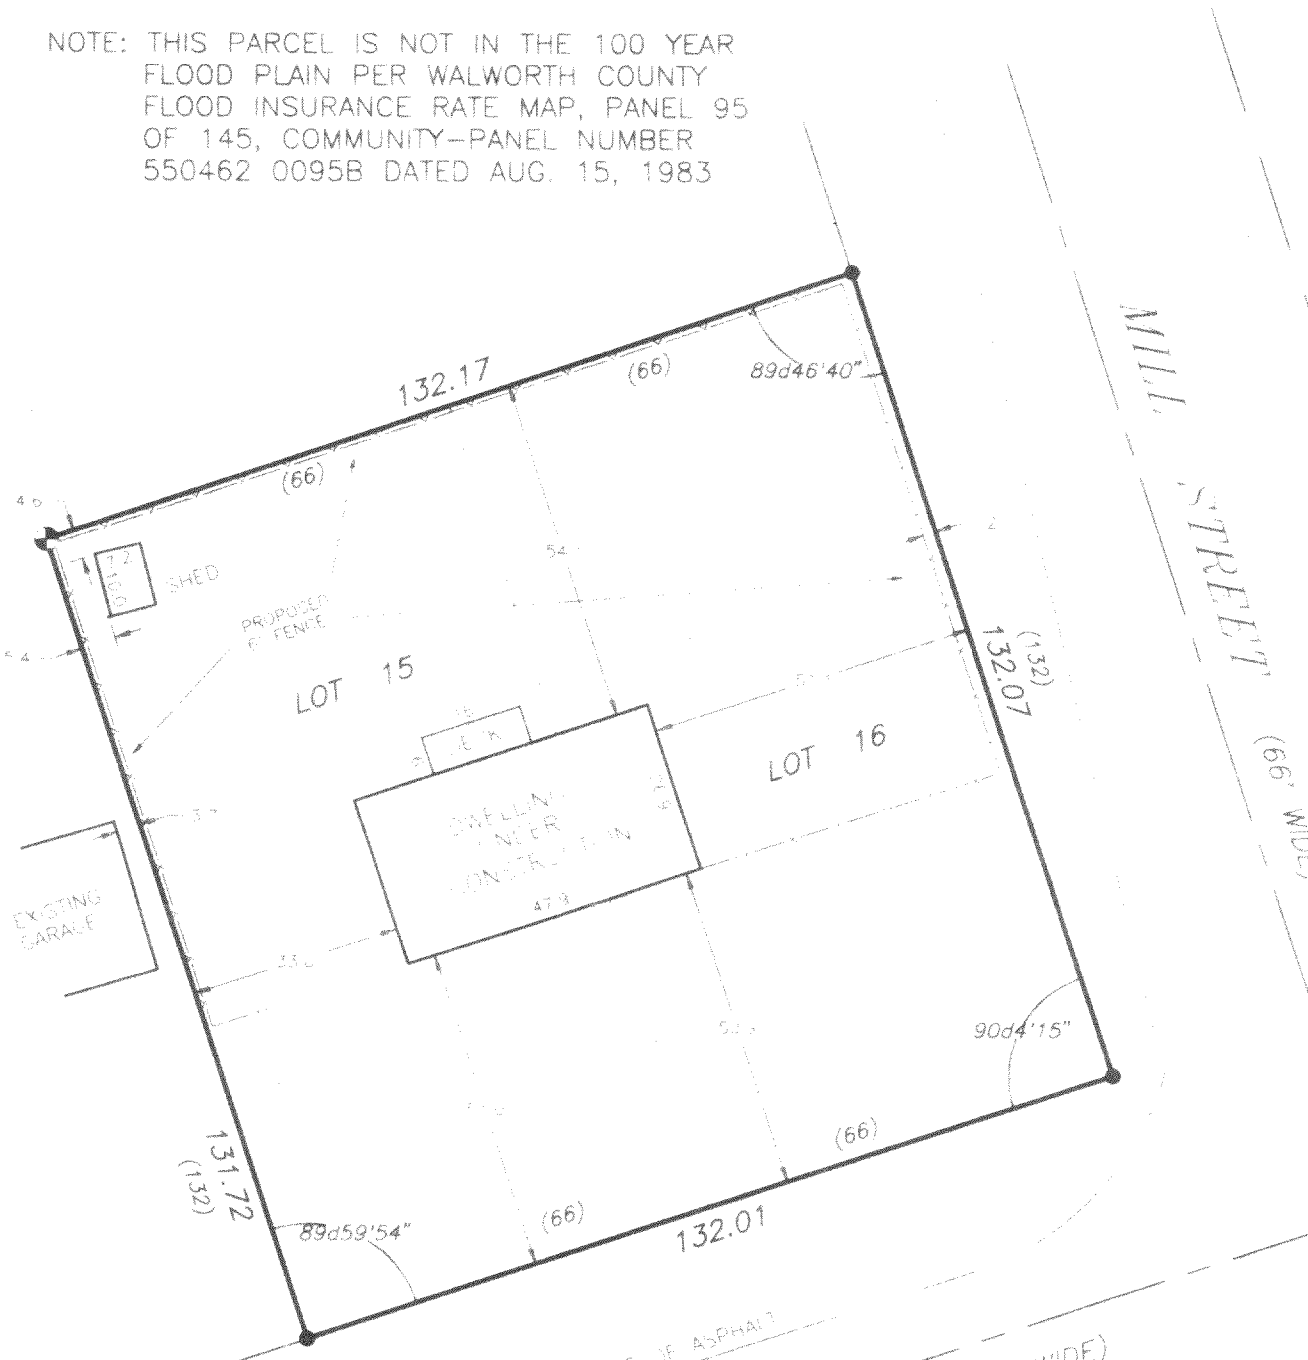

SCALE: 1" = 30'

LEGEND

- ● - FOUND IRON PIPE
- ○ - SET IRON PIPE
- ( ) - RECORDED AS
- ⊙ - BENCH MARK
- ◔ - FOUND CONCRETE MONUMENT

RECEIVED
JAN 2 4 2001

I HEREBY CERTIFY THAT I HAVE SURVEYED THE ABOVE DESCRIBED PROPERTY AND THE ABOVE MAP IS A TRUE REPRESENTATION THEREOF AND SHOWS THE SIZE AND LOCATION OF THE PROPERTY, THE LOCATION OF ALL VISIBLE STRUCTURES AND DIMENSIONS OF ALL PRINCIPAL BUILDINGS THEREON, BOUNDARY FENCES, APPARENT EASEMENTS, ROADWAY AND VISIBLE ENCROACHMENTS, IF ANY.

THIS SURVEY IS MADE FOR THE PRESENT OWNERS OF THE PROPERTY AND ALSO THOSE WHO PURCHASE OR GUARANTEE THE TITLE THERETO WITHIN (1) YEAR FROM THE DATE HEREOF.

DATED AT WATERFORD THIS 3RD DAY OF NOVEMBER, 19 99

RECERTIFIED NOVEMBER 15, 2000

NLO-94

218-1227