
PLAT OF SURVEY

DATE: 9/25/00

ORDERED BY: BOB LIMOSANI
HOMESTEAD REALTY
520 BROAD STREET
LAKE GENEVA, WI 53147

DESCRIPTION: UNIT 80 COUNTRY ESTATES CONDOMINIUM; A CONDOMINIUM LOCATED IN THE NE 1/4 OF SECTION 7 & THE NW 1/4 OF SECTION 8 , TOWN 2 NORTH , RANGE 18 EAST , WALWORTH COUNTY, WISCONSIN

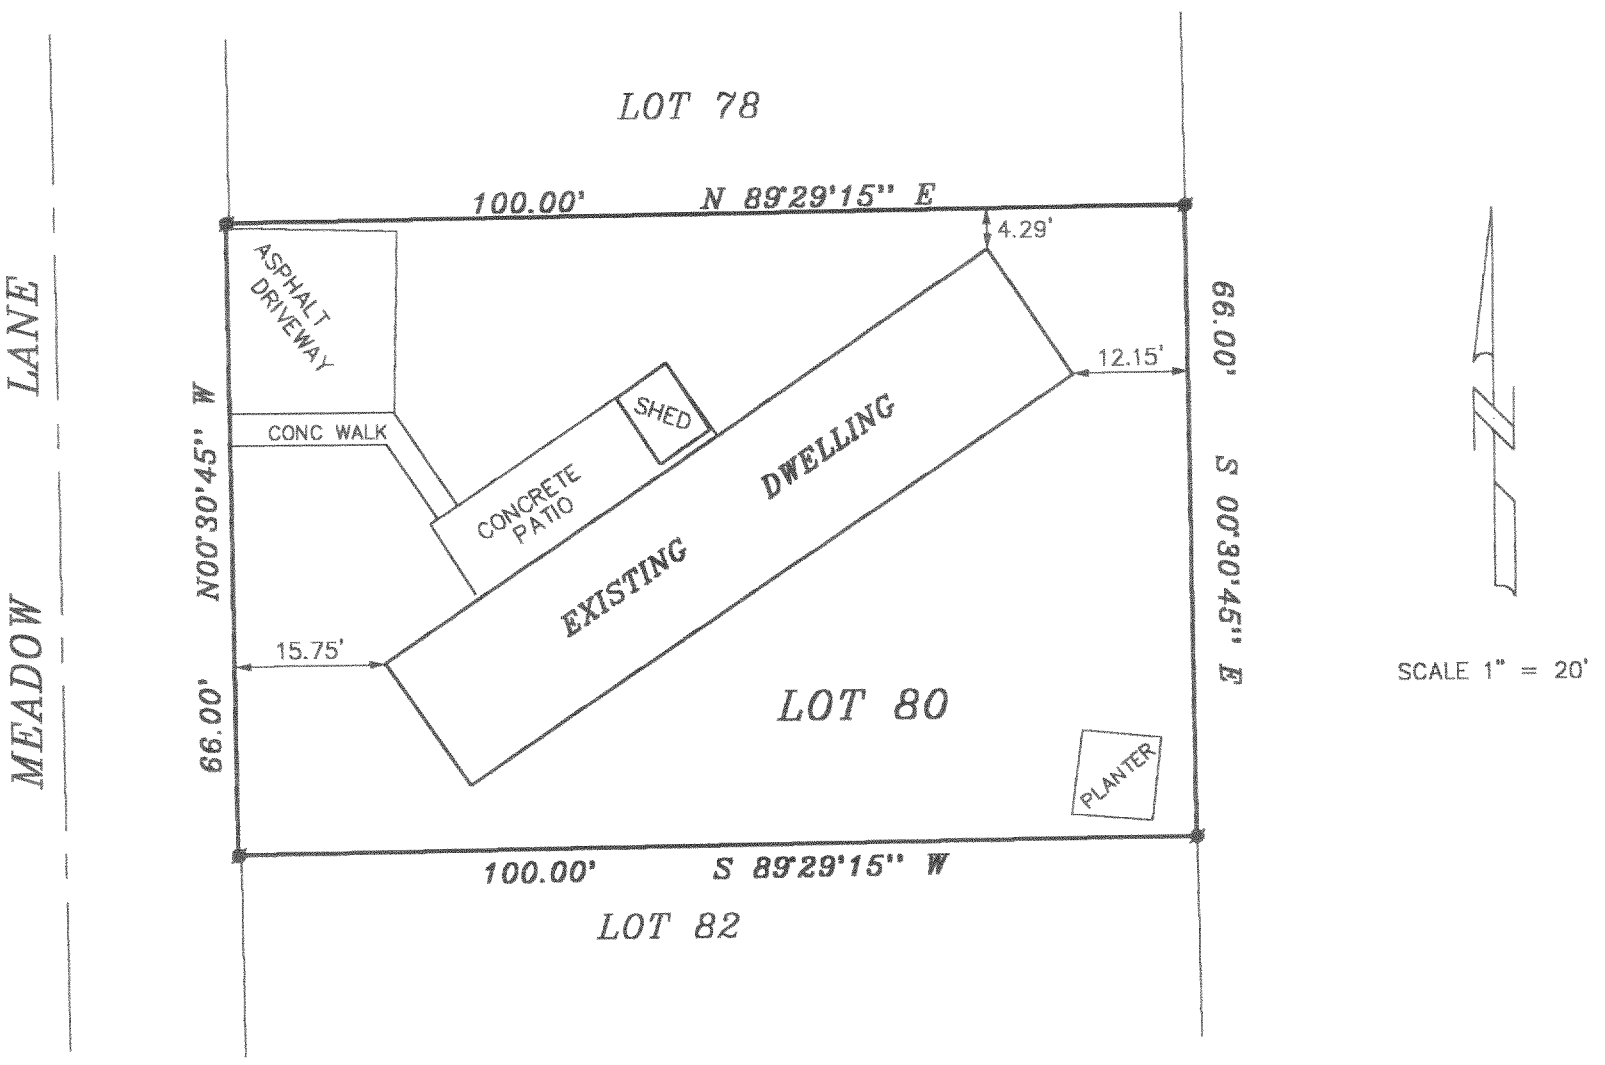

SCALE 1" = 20'

LEGEND

● SET IRON PIPE

THE ABOVE MAP IS A TRUE REPRESENTATION THEREOF AND SHOWS THE SIZE AND LOCATION OF ALL THE PROPERTY, EXTERIOR BOUNDARIES, THE LOCATION OF ALL VISIBLE BOUNDARY FENCES , APPARENT EASEMENTS , ROADWAYS AND VISIBLE ENCROACHMENTS , IF ANY

THIS SURVEY IS MADE FOR THE USE OF THE PRESENT OWNERS OF THE PROPERTY , AND ALSO THOSE WHO PURCHASE , MORTGAGE OR GURANTEE TITLE THERETO WITHIN ONE (1) YEAR FROM DATE HERETO.

John P Krott

JOHN P. KROTT , R.L.S. 2258

WISCONSIN
JOHN P. KROTT
S-2258
MUKWONAGO, WIS.
LAND SURVEYOR

NOTE: THIS IS NOT A CERTIFIED COPY UNLESS SEAL IS IN RED.

JOB NUMBER

RECEIVED
DEC 13 2000

JK SURVEYING
N3705 WILLOW BEND LANE
LAKE GENEVA, WI 53147
(262)-248-3697

NCS-80

218-1231