**ABERNATHY and ASSOCIATES**
Kenneth B. Abernathy Jr.
Wisconsin Registered Land Surveyor S-1594


W4056 BRAY RD.
ELKHORN, WI. 53121
PHONE: (262) 723-4260 (OFFICE)
(262) 723-7209 (FAX)
Email: abernathy@elknet.net

# PLAT OF SURVEY

LOT 2 OF CERTIFIED SURVEY MAP NO. 3351, PART OF THE NORTHWEST 1/4 OF THE NORTHEAST 1/4 AND PART OF THE SOUTHWEST 1/4 OF THE NORTHEAST 1/4 OF SECTION 15, TOWN 2 NORTH, RANGE 18 EAST. LYONS TOWNSHIP, WALWORTH COUNTY, WISCONSIN.

ORDERED BY:
MIDWEST BUILDERS OF BURLINGTON
5152 RUEDEBUSCH RD.
BURLINGTON, WI 53105

OWNERS:
ERNEST & CAROL GRULICH
29520 BUSHNELL RD
BURLINGTON, WI 53105

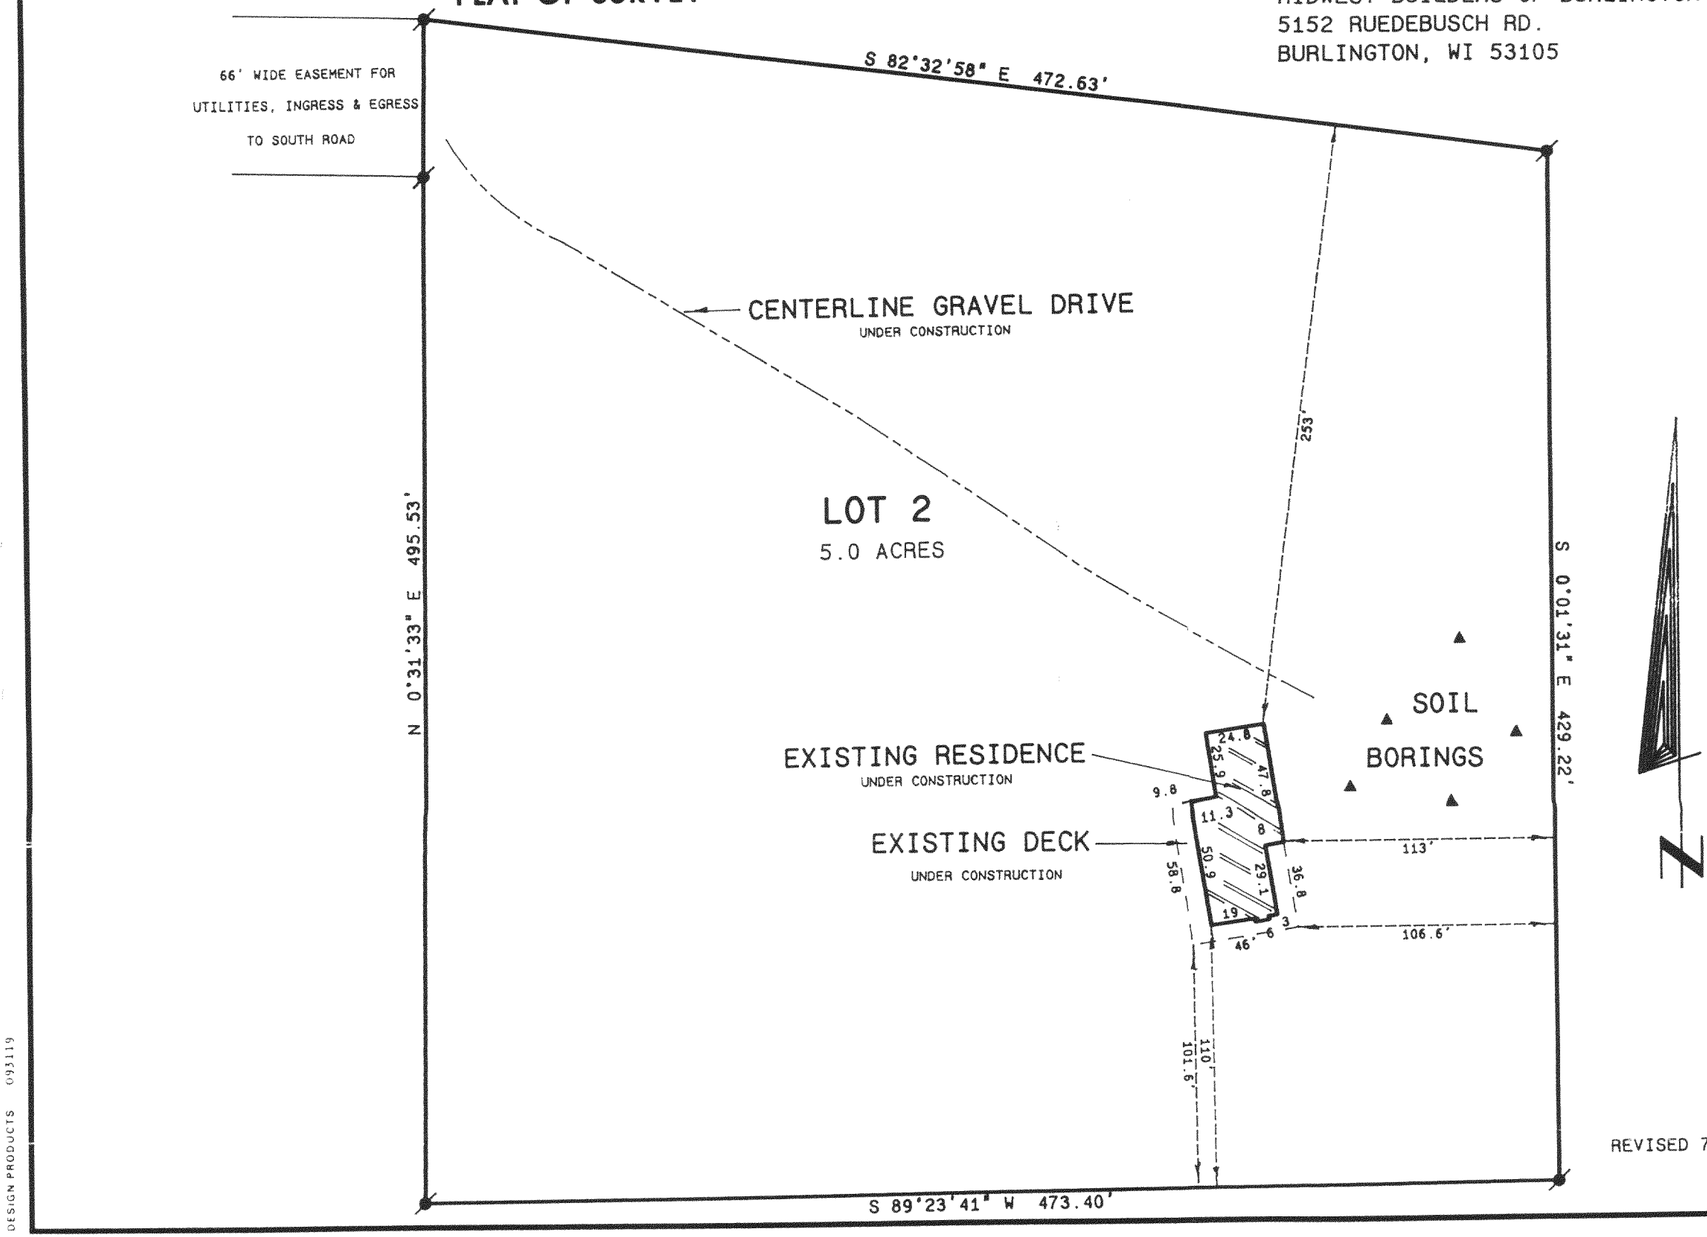


**Legend**

- FOUND IRON PIPE
- FOUND IRON ROD
- FOUND BRASS CAPPED MONUMENT
- FOUND CONCRETE MONUMENT
- \+ CHISEL CUT IN CONCRETE
- SET IRON ROD, 24" LONG, WEIGHING 1.5 LBS./LINEAL FT., 3/4" DIA.
- SET IRON ROD, 30" LONG, WEIGHING 4.5 LBS./LINEAL FT., 1-11/16" DIA.
- (xx) RECORDED AS DIMENSION
- —x—x— EXISTING FENCE

WISCONSIN
KENNETH B. ABERNATHY, JR.
S-1594
ELKHORN
WI
LAND SURVEYOR

RECEIVED
AUG - 2 2002

SCALE: 1"=60 FEET

"I hereby certify that the above described property has been surveyed by me or under my direction and that the above map is a true representation thereof and shows the size and location of the property, its exterior boundaries, the location of all visible structures and dimensions of all principal buildings thereon, boundary fences, apparent easements, roadways and visible encroachments, if any."

"This survey is made for the use of the present owners of the property, and also those who purchase, mortgage, or guarantee the title thereto within one year from date hereof."

Kenneth B. Abernathy Jr.

KENNETH B. ABERNATHY, JR.
WISCONSIN REGISTERED LAND SURVEYOR,
S-1594

REVISED 7-31-02

Date: APRIL 29, 2002 Job No. 02-407

DESIGN PRODUCTS 093119

NA-335/-2

218-1314