
PREPARED FOR :
VERN STEPHAN
818 HIGH STREET
LAKE GENEVA, WI. 53147

PLAT OF SURVEY

- OF -

LOT 1 OF CERTIFIED SURVEY MAP # 1188 A C.S.M. BEING LOT 5 OF LYON'S INDUSTRIAL PARK AND LOCATED IN THE SOUTHEAST 1/4 OF SECTION 19, TOWN 2 NORTH, RANGE 18 EAST, WALWORTH COUNTY, WISCONSIN.

J.K. SURVEYING INC.
N3705 WILLOWBEND LANE
LAKE GENEVA, WI, 53147
262-248-3697

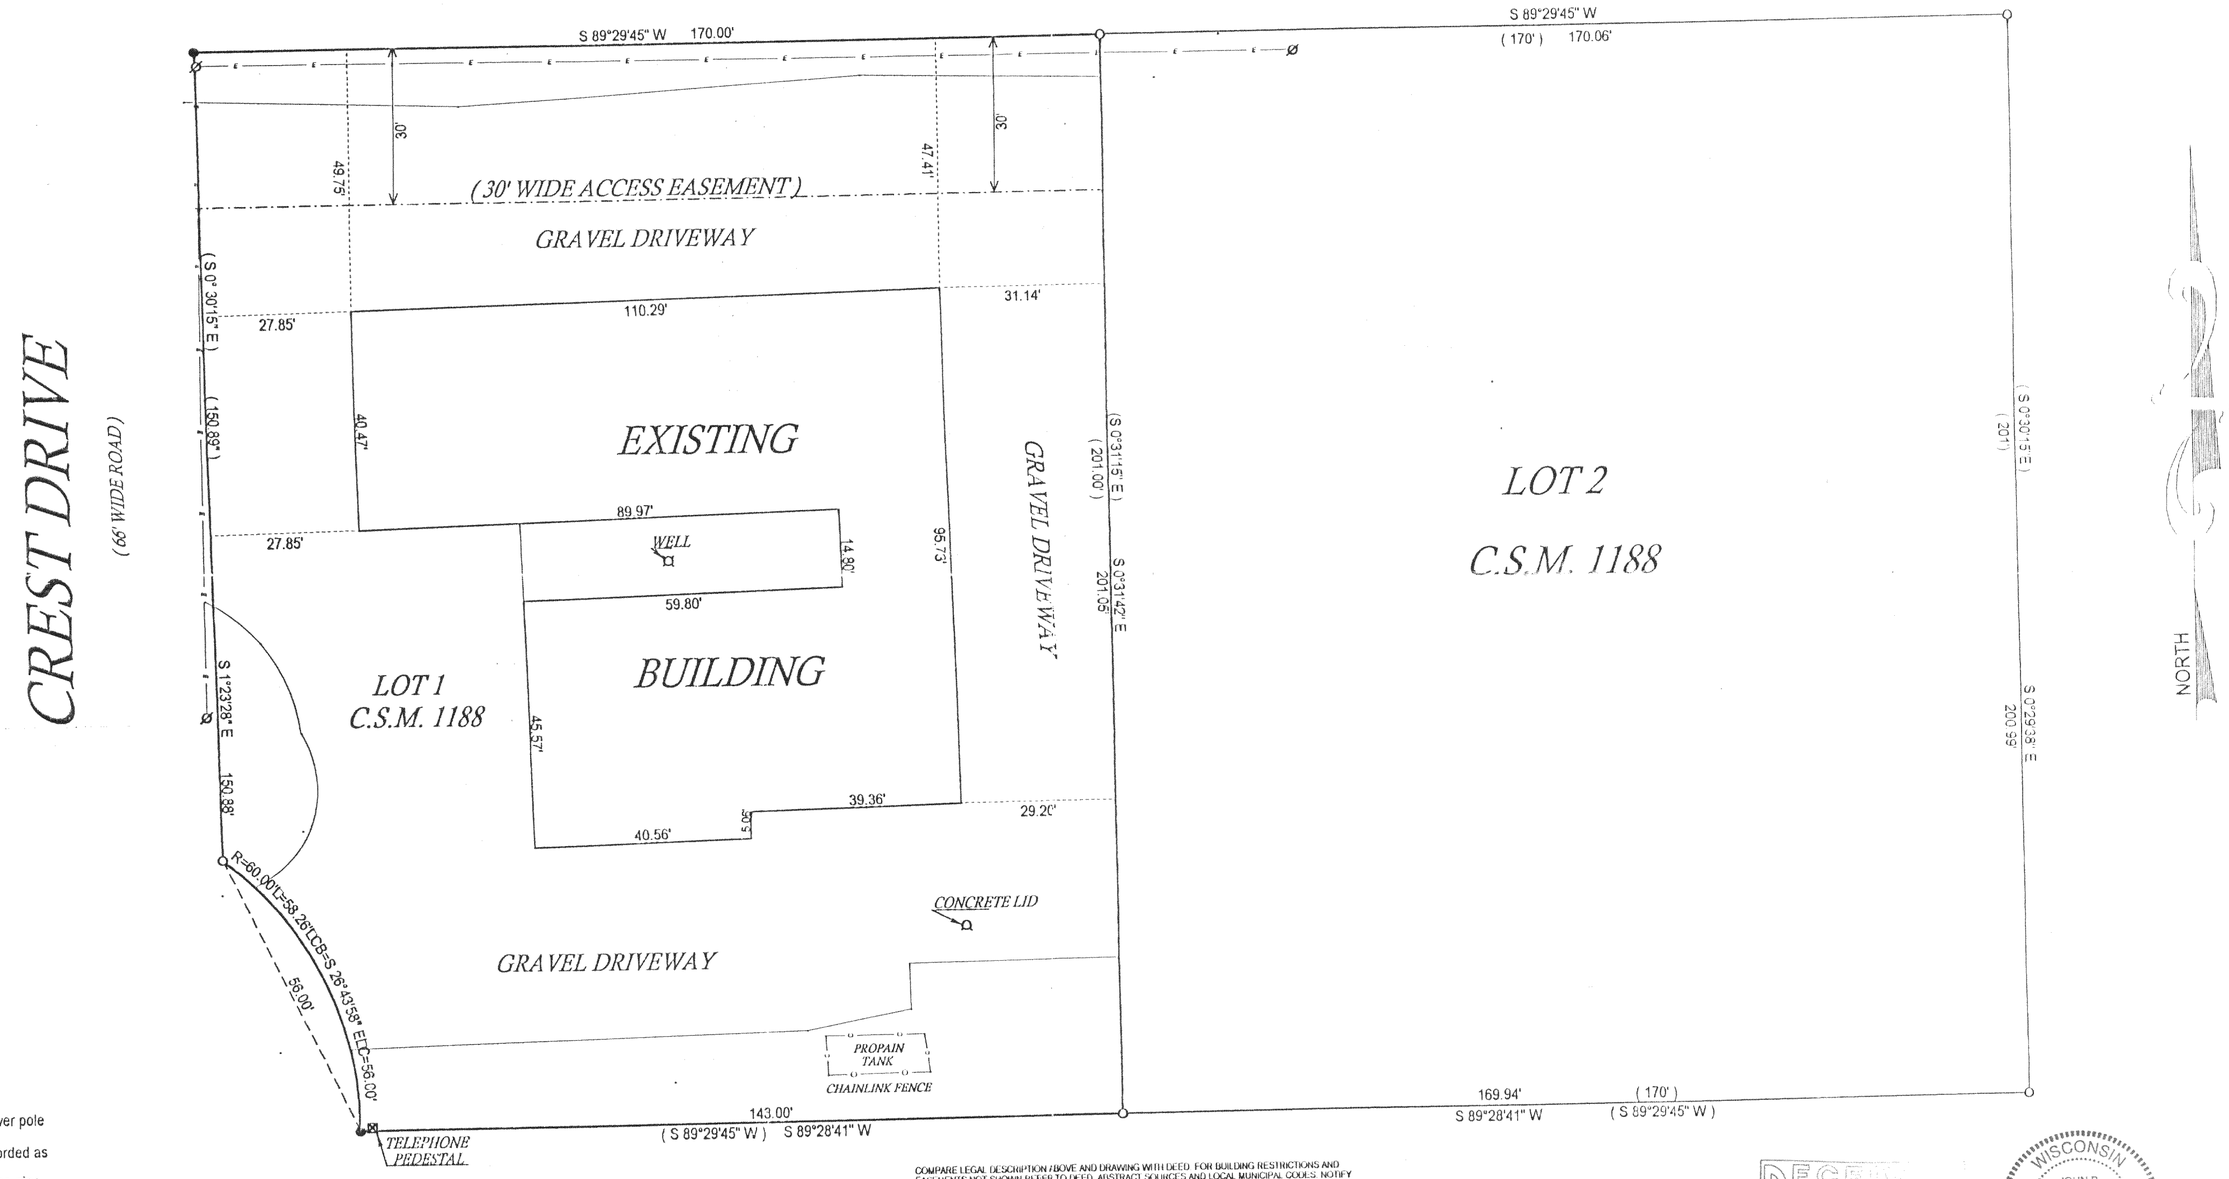

∅ = power pole
( )= recorded as
○ = iron pipe found
● = iron pipe set

SCALE 1" = 20'

JOB # 02-256

TAX # NA118800001

COMPARE LEGAL DESCRIPTION ABOVE AND DRAWING WITH DEED FOR BUILDING RESTRICTIONS AND EASEMENTS NOT SHOWN.REFER TO DEED, ABSTRACT SOURCES AND LOCAL MUNICIPAL CODES. NOTIFY THE SURVEYOR IMMEDIATELY OF ANY DISCREPANCY.

"I hereby certify that I have surveyed the above described property and that the above map is a true representation thereof and shows the size and location of all visible structures, apparent easements and encroachments if any."
This survey is made for the present owners of the property, and those who purchase, mortgage, or guarentee the title thereto, within one year from the date hereof.

DATED THIS 6 TH, DAY OF JUNE 20 02 .

RECEIVED
AUG 16 2002

WISCONSIN
JOHN P. KROTT
S-2258
MUKWONAGO, WIS.
LAND SURVEYOR

JOHN KROTT S - 2258
Wisconsin Registered Land Surveyor
(original if signed in red)

218-1322