# *PLAT OF SURVEY*
## *–OF–*

LOT 14, BLOCK 2, FIRST ADDITION TO KNOLL BROOK, BEING A SUBDIVISION OF PART OF THE NORTHWEST 1/4 OF THE SOUTHWEST 1/4 AND PART OF THE SOUTHWEST 1/4 OF THE SOUTHWEST 1/4 OF SECTION 10, TOWNSHIP 2 NORTH, RANGE 18 EAST, TOWN OF LYONS, WALWORTH COUNTY, WISCONSIN.


SURVEY FOR: GENE AND JOETTE MATHER

SURVEY ADDRESS: 6172 RAVEN COURT

TOP OF FOUNDATION ELEVATION = 101.8'

*CURVE DATA*

CENTRAL ANGLE = 62°12'48"
RADIUS = 60.00'
CHORD = 62.00'
CHORD BEARING = S42°48'16"E

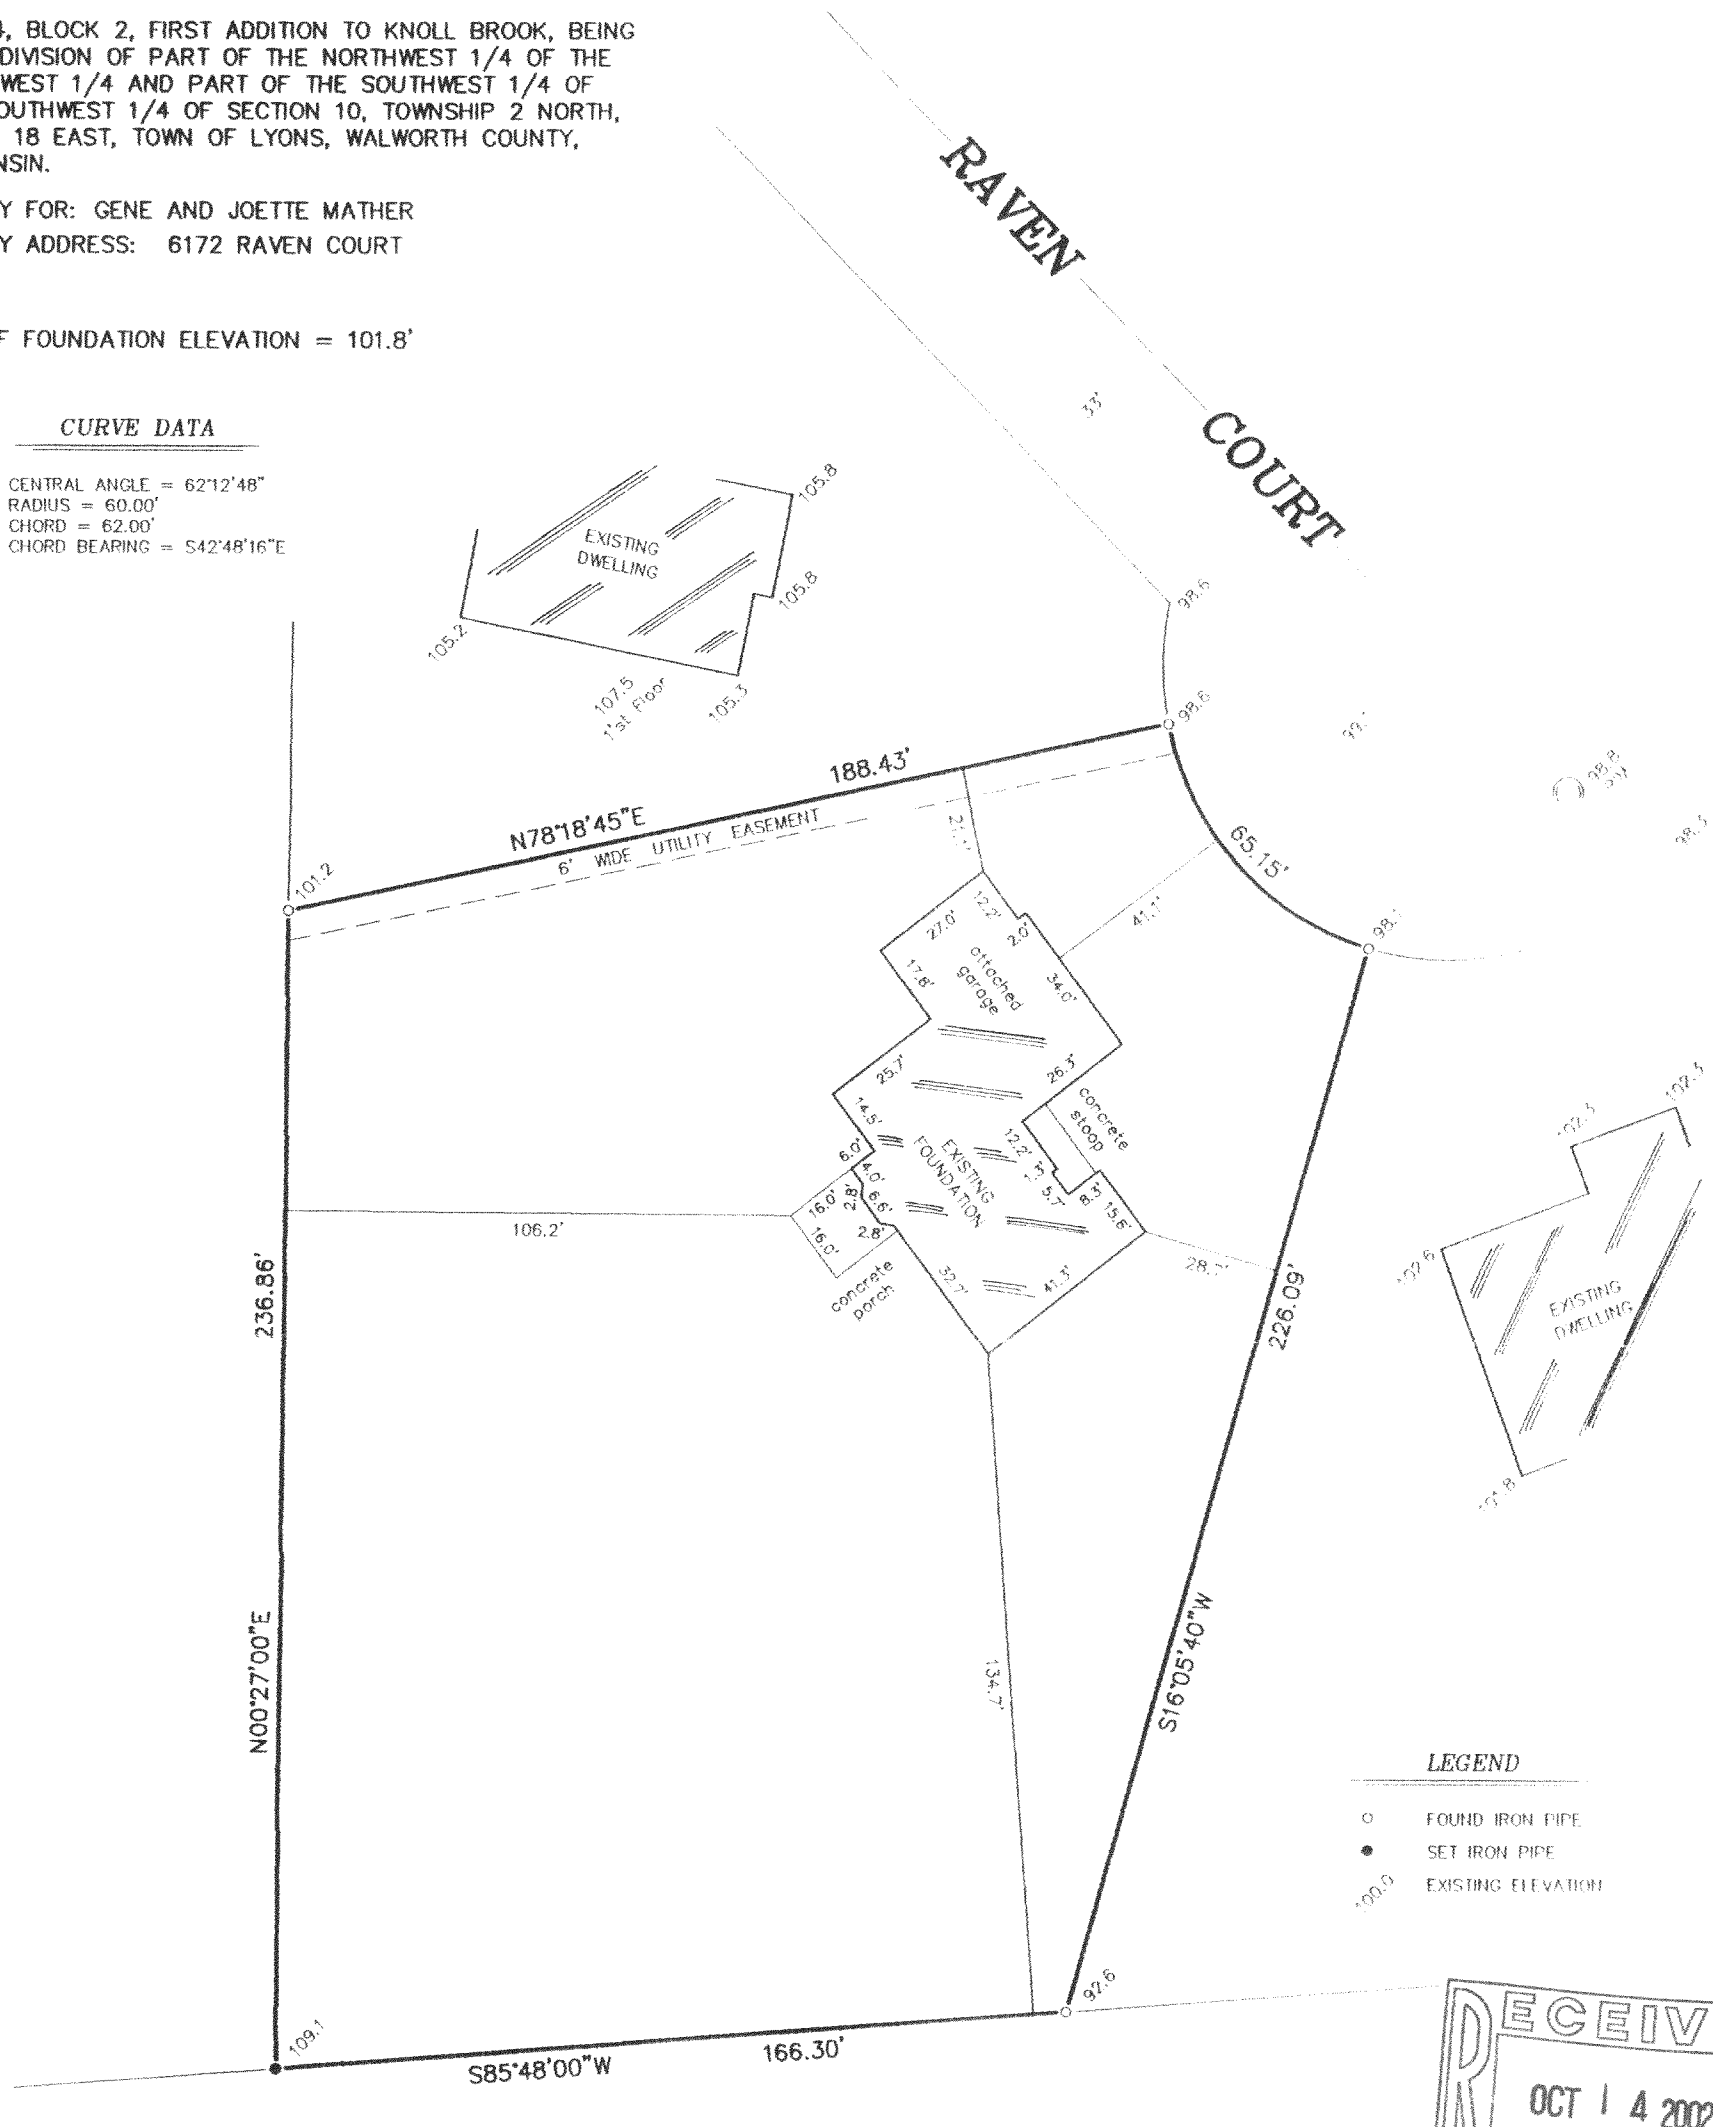


*LEGEND*

- ○ FOUND IRON PIPE
- ● SET IRON PIPE
- 100.0 EXISTING ELEVATION

RECEIVED
OCT 1 4 2002
DH


"I hereby certify that I have surveyed the above described property and that the above map is a correct representation thereof and shows the size and location of the property, its exterior boundaries, the location of all visible structures and dimensions of all principal buildings thereon, boundary fences, apparent easements, roadways and encroachments, if any."

"This survey is made for the use of the present owners of the property, and those who purchase, mortgage, or guarantee the title thereto within one year from date hereof."

*SCALE:* 1" = 40'

WISCONSIN
ROBERT J. WETZEL
S-1778
BURLINGTON WIS.
LAND SURVEYOR

THIS IS NOT AN ORIGINAL PRINT UNLESS THIS SEAL IS RED.

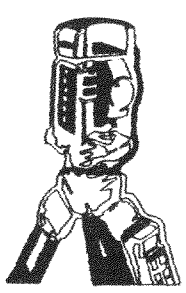

B.W. SURVEYING, INC.
LAND SURVEYS
MAPPING AND PLANNING
412 N. PINE STREET
BURLINGTON, WI 53105
(262)–767–0225

Robert J Wetzel
ROBERT J. WETZEL S-1778

REVISED: 09/20/02
AUGUST 16, 2002 — DATE
5517 — JOB NUMBER

215-1340 NK01-13