PREPARED FOR:
COLDWELL BANKERS PRIMUS
c\o MERRY STIER
226 BROAD STREET
LAKE GENEVA WI
53147

J.K. SURVEYING INC.
N3705 WILLOWBEND LANE
LAKE GENEVA, WI, 53147
262-248-3697

PLAT OF SURVEY


- OF -

LOT 16, PARTRIDGE WOODS, A SUBDIVISION LOCATED IN THE NORTHEAST 1/4, THE SOUTHEAST 1/4, AND THE SOUTHWEST 1/4 OF SECTION 23, TOWN 2 NORTH, RANGE 18 EAST, WALWORTH COUNTY, WISCONSIN.

COMPARE LEGAL DESCRIPTION ABOVE AND DRAWING WITH DEED. FOR BUILDING RESTRICTIONS AND EASEMENTS NOT SHOWN,REFER TO DEED, ABSTRACT SOURCES AND LOCAL MUNICIPAL CODES. NOTIFY THE SURVEYOR IMMEDIATELY OF ANY DISCREPANCY.

"I hereby certify that I have surveyed the above described property and that the above map is a true representation thereof and shows the size and location of all visible structures, apparent easements and encroachments if any."
This survey is made for the present owners of the property, and those who purchase, mortgage, or guarentee the title thereto, within one year from the date hereof.

DATED THIS 28 TH, DAY OF SEPTEMBER 20 02 .

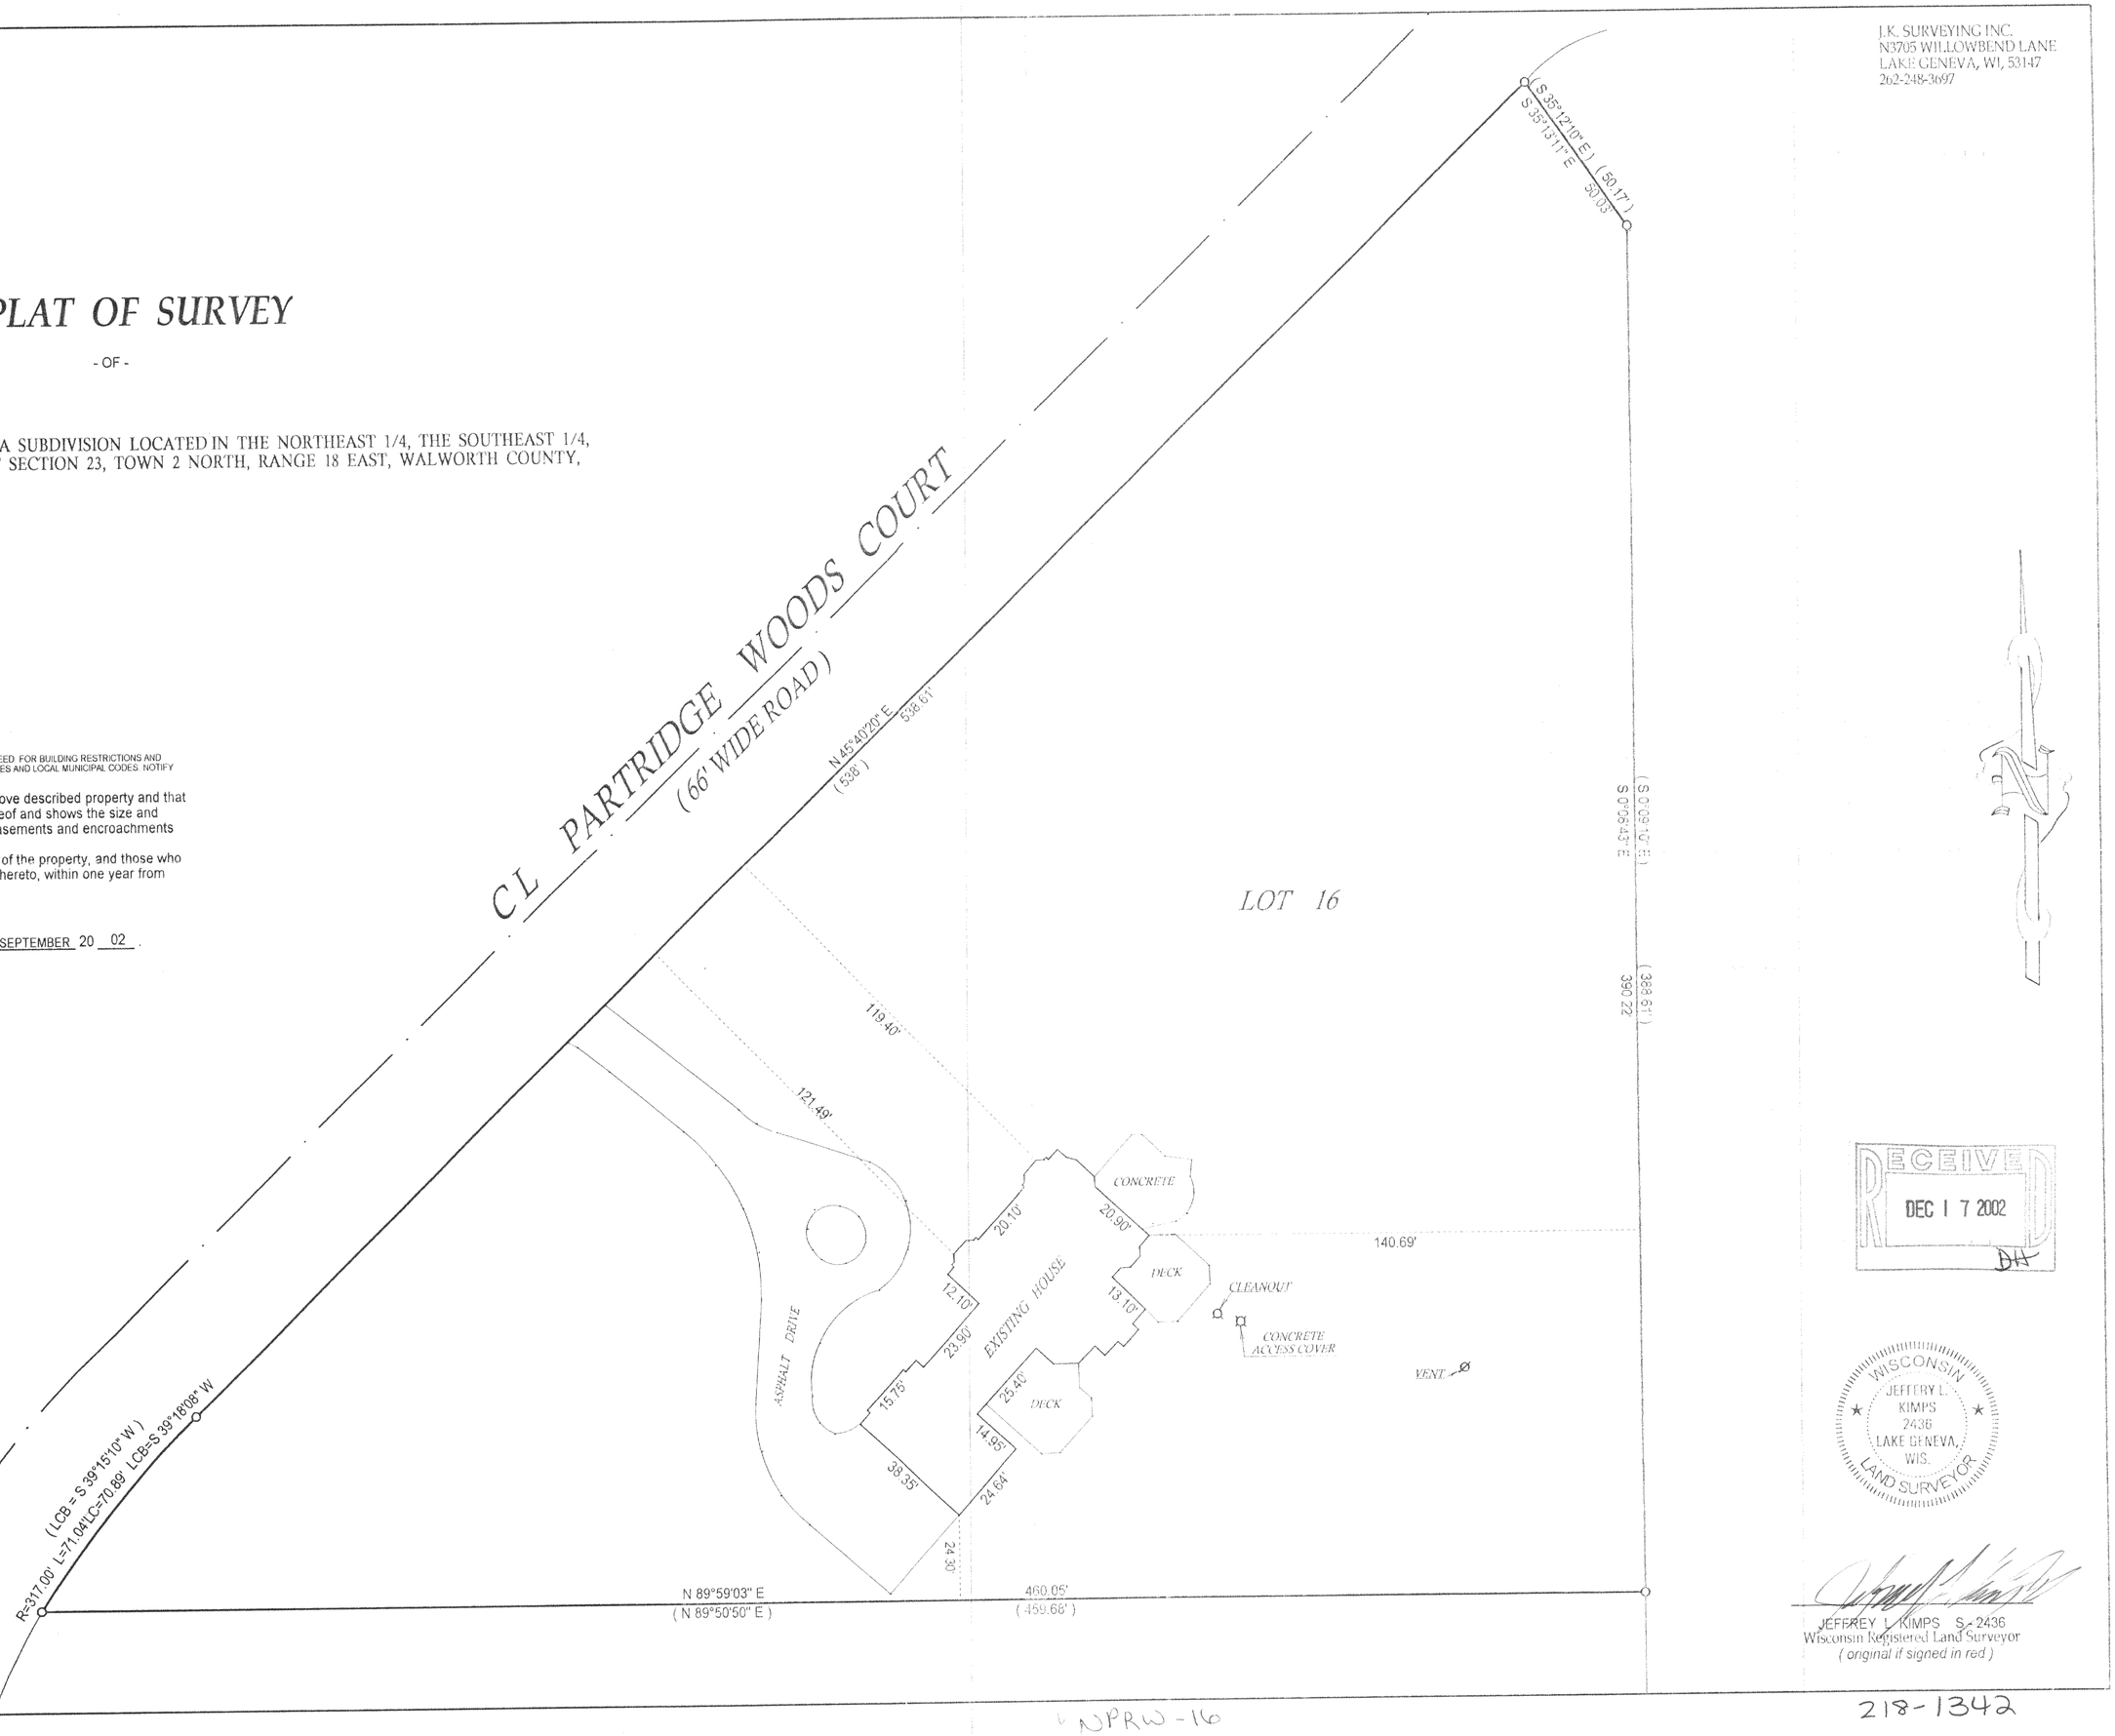

( )= recorded as

○ = iron pipe found

● = iron pipe set

SCALE 1" = 30'

JOB # 02-458

TAX ID # NPRW 00016

RECEIVED
DEC 1 7 2002
DH

WISCONSIN
JEFFERY L. KIMPS
2436
LAKE GENEVA, WIS.
LAND SURVEYOR

JEFFERY L. KIMPS S-2436
Wisconsin Registered Land Surveyor
(original if signed in red)

NPRW-16

218-1342