
DUNHAM SURVEYING, S.C.
SURVEYING & SUBDIVIDING
DELAVAN, WISCONSIN 53115

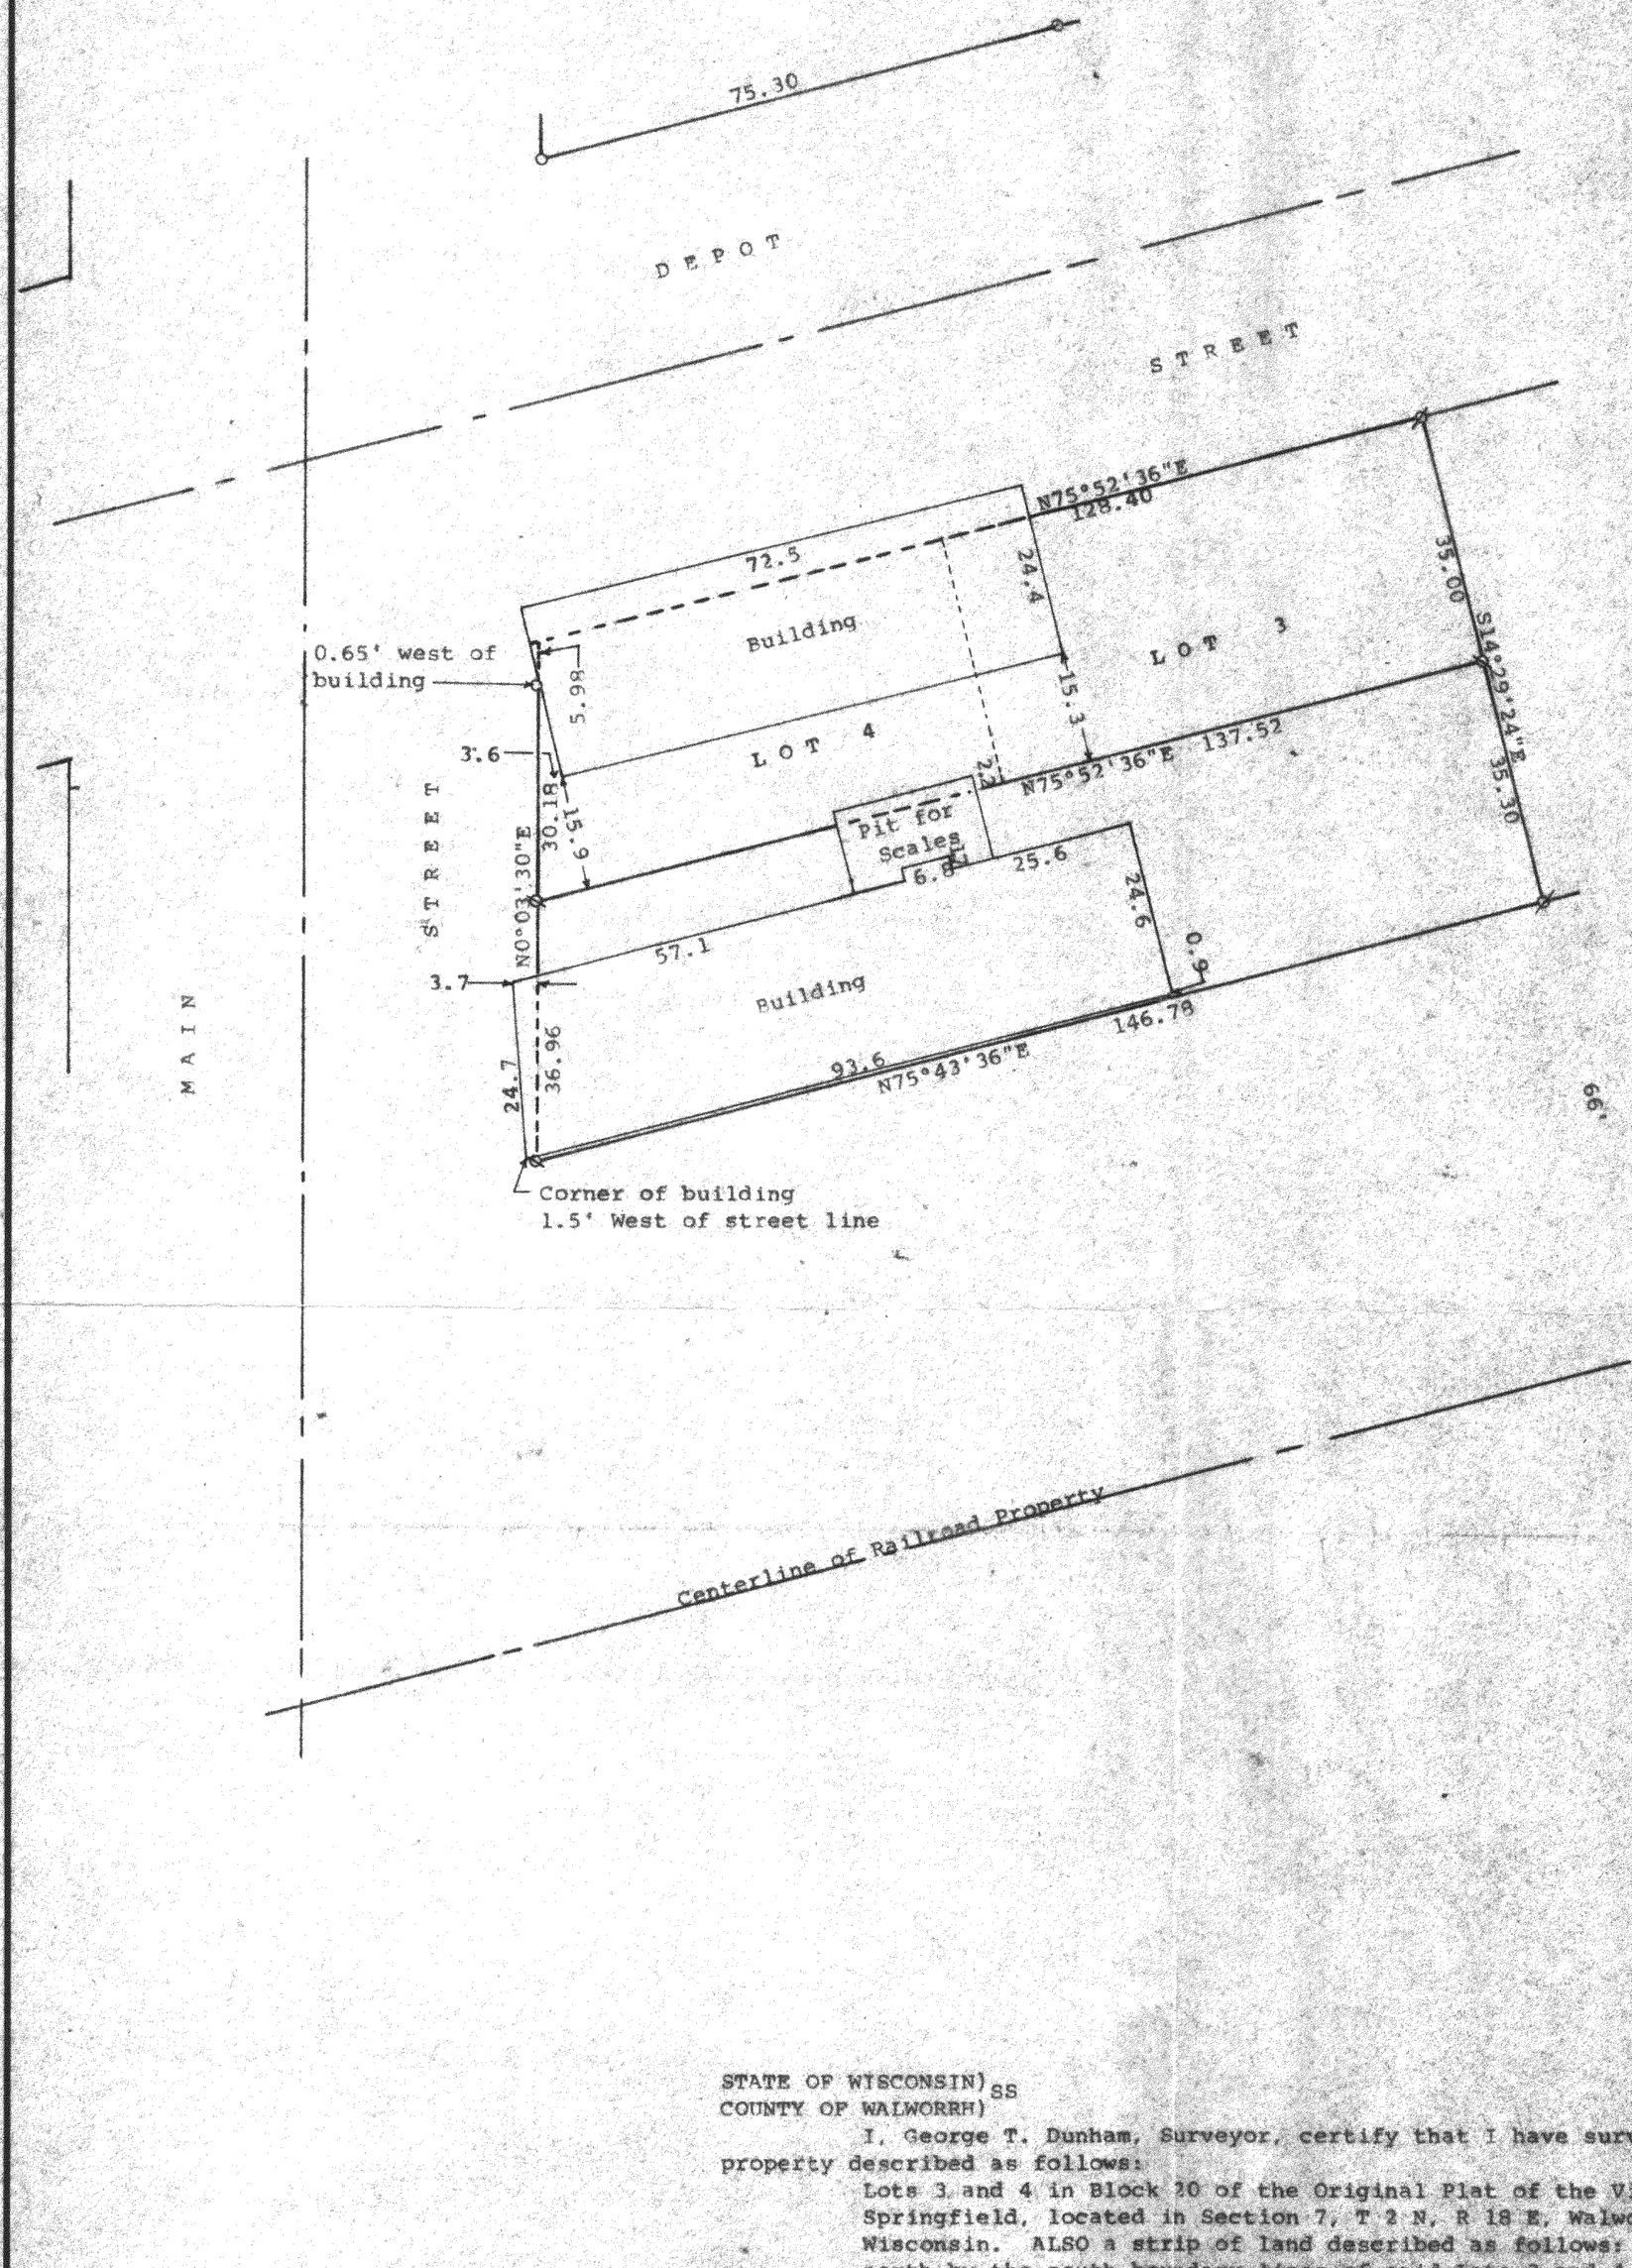

Scale - 1" = 20'
Ø = 1" Iron Pipe Found
⊗ = 1¼" Iron Pipe Set
○ = Iron Pipe Found. Size not noted

Survey ordered by:
Walter Schinke
Springfield, WI

STATE OF WISCONSIN)
COUNTY OF WALWORRH) SS

I, George T. Dunham, Surveyor, certify that I have surveyed the property described as follows:

Lots 3 and 4 in Block 20 of the Original Plat of the Village of Springfield, located in Section 7, T 2 N, R 18 E, Walworth County, Wisconsin. ALSO a strip of land described as follows: Bounded on north by the south boundary lines of said Lots 3 and 4 in Block 20; on the west by the east line of Main Street; on the south by the north boundary lands formerly owned by the Western Union Railroad Company and on the east by the southerly extension of the east line of said Lot 3 in Block 20

and that the plat shown hereon is a correct representation thereof and shows the size and location of the property, its exterior boundaries, the location of all visible structures and dimensions of all principal buildings thereon, boundary fences, apparent easements, roadways and visible encroachments, if any, and that I have surveyed the property hereon described, according to the official records, to the best of my knowledge and belief.

Survey Sept. 1987
Plat drawn November 4, 1996

George T. Dunham, Surveyor

RECEIVED
MAY 9 2003
SRP

WISCONSIN LAND SURVEYOR
GEORGE T. DUNHAM
S-306
DELAVAN WIS.

NVS-SD

GME 1020

218-1372