
#12-68

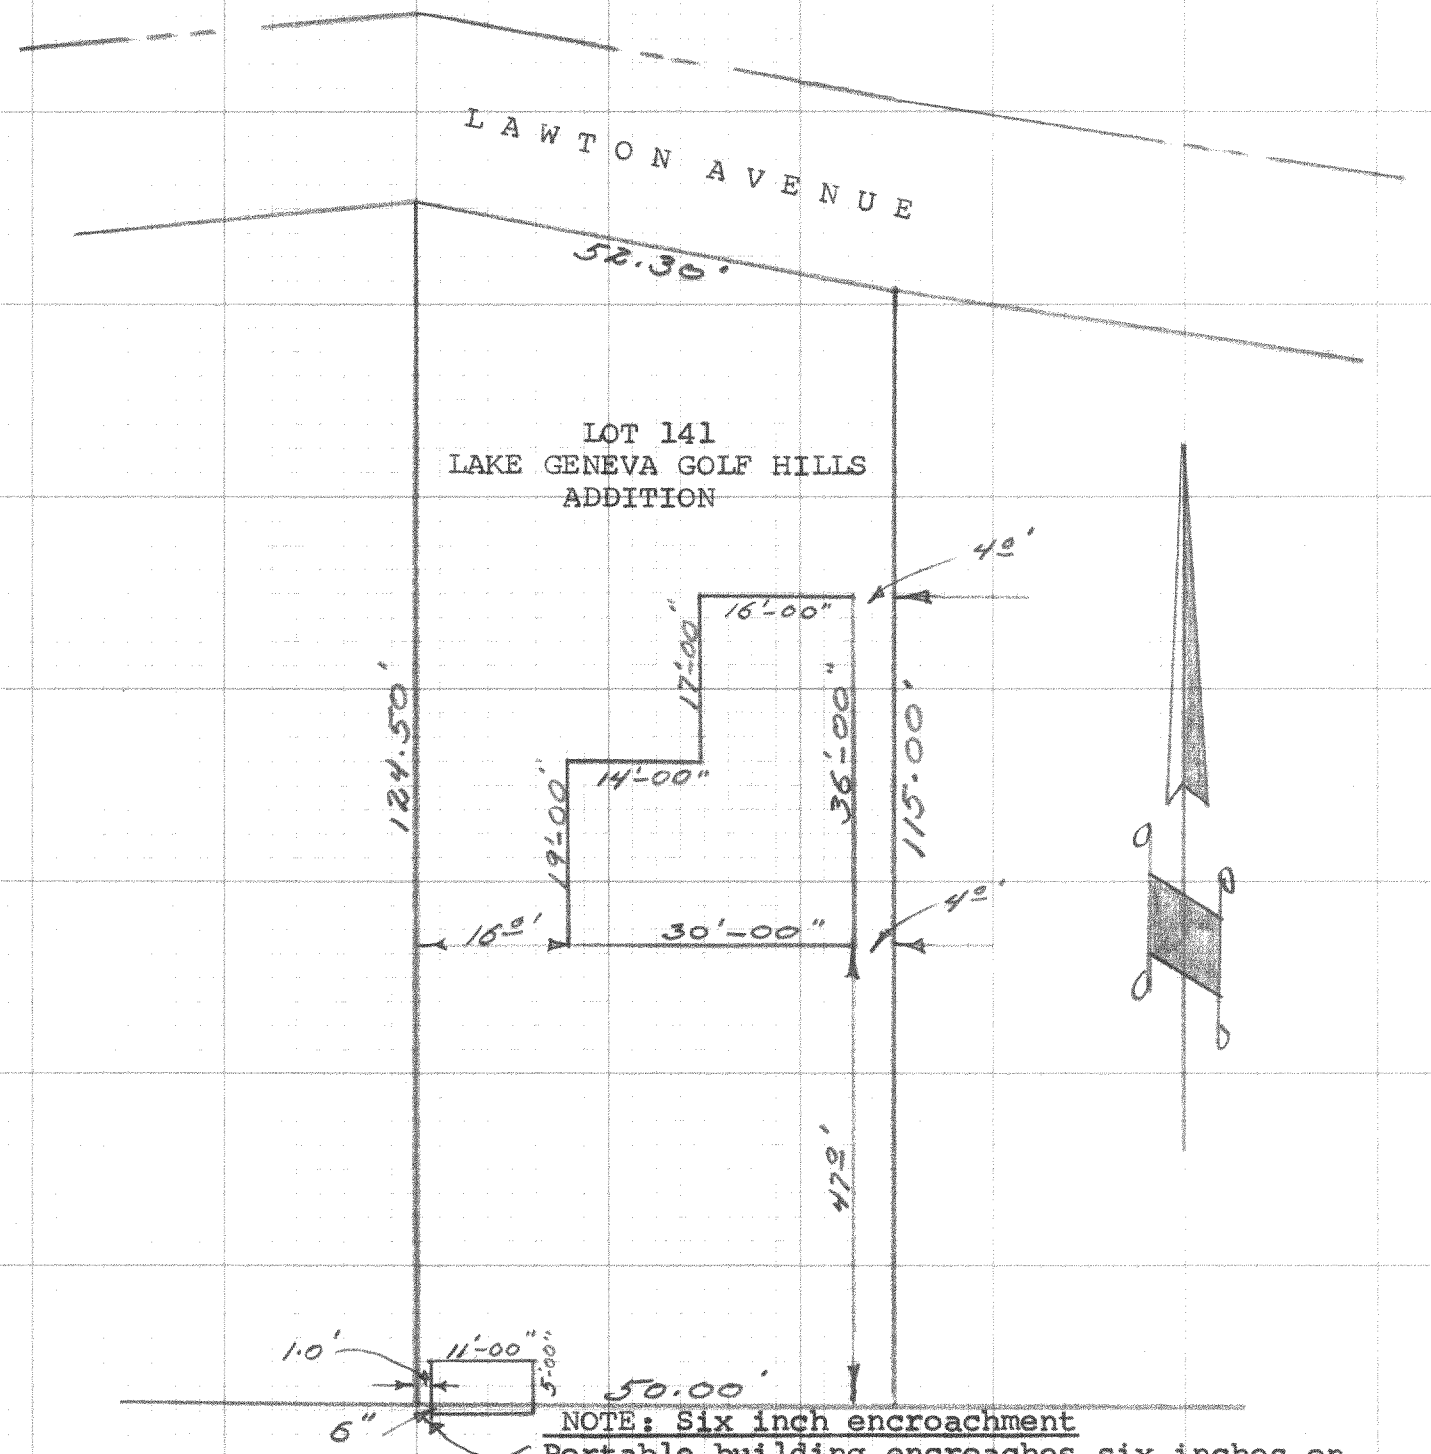

NOTE: Six inch encroachment
Portable building encroaches six inches on property south of Lot 141.

DESCRIPTION: Lot 141, Lake Geneva Golf Hills Addition, in Section 31, Town 2 north, Range 18 east, Lyons Township, Walworth County, Wisconsin.

CERTIFICATE: I, hereby certify that I have surveyed the above mentioned property and that the hereon portrayed is an accurate survey and a true representation thereof and correctly shows the exterior boundary lines and the location of the buildings and other improvements thereof.

James F. Biagi

James F. Biagi. RLS 272
Elkhorn, Wisconsin.

Dated: July 22nd 1968.

218-139