PLAT OF SURVEY


- OF -

UNIT 172 OF PHASE 2 OF COUNTRY ESTATES A CONDOMINIUM LOCATED IN THE NORTHWEST 1/4 OF SECTION 8, TOWN 2 NORTH , RANGE 18 EAST, WALWORTH COUNTY , WISCONSIN.

PREPARED FOR:

JAN TWING
5680 PARLAMENT LN.
NO. 111
DELAVAN, WI 53115

J.K. SURVEYING INC.
N3705 WILLOWBEND LANE
LAKE GENEVA, WI, 53147
262-248-3697

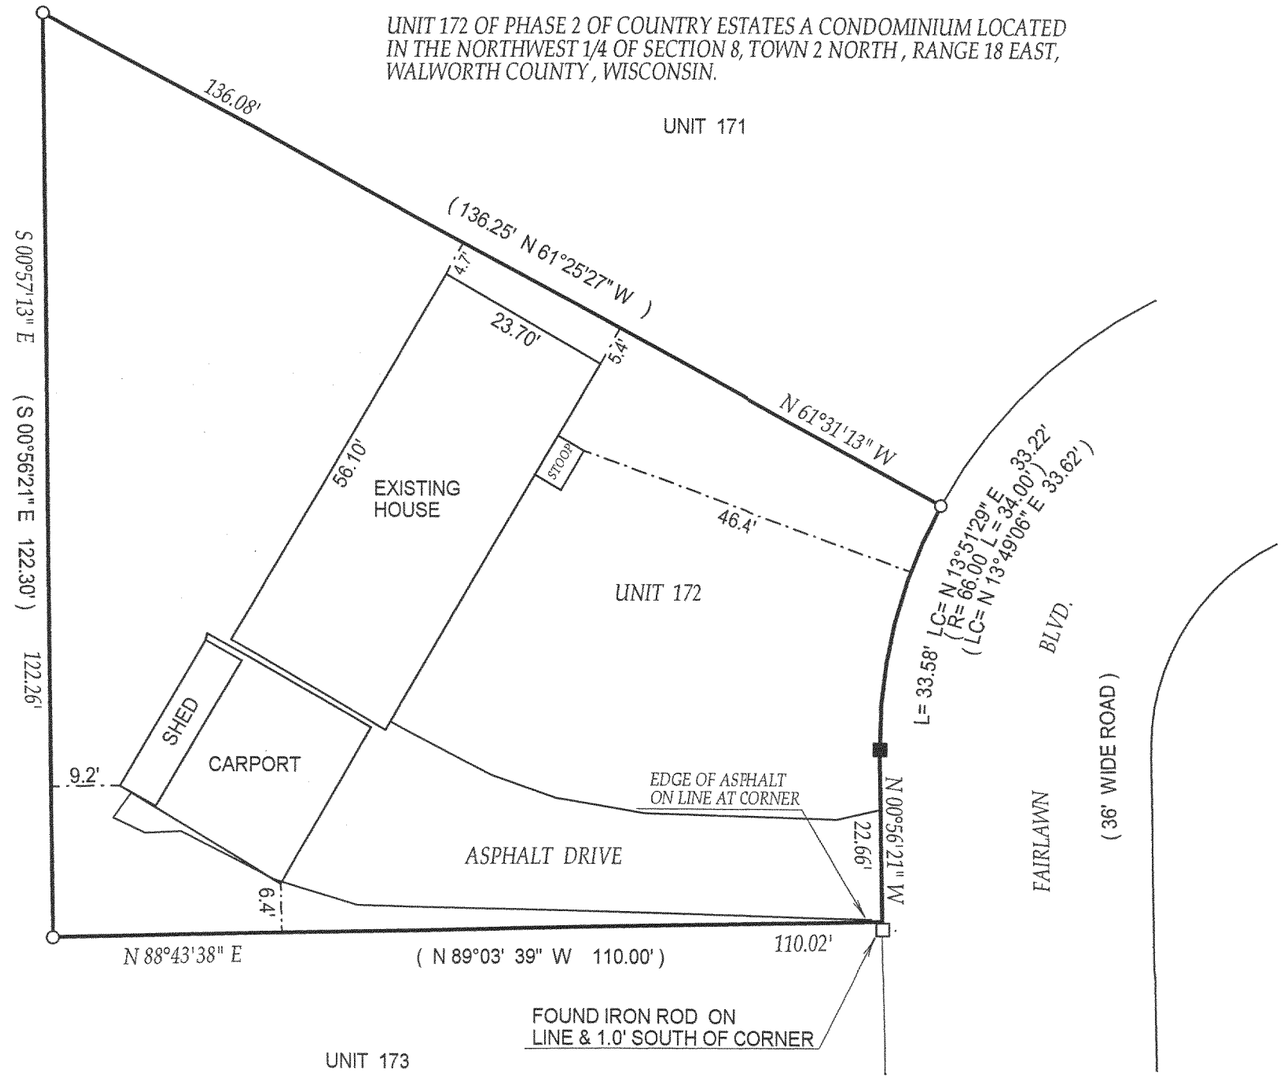

( )= recorded as

□ = found iron bar

○ = found iron pipe

● = set iron pipe

■ = set iron bar

SCALE 1" = 20'

JOB # 03-471

TAX ID # NCS00172

OCT - 3 2003

DRP

COMPARE LEGAL DESCRIPTION ABOVE AND DRAWING WITH DEED. FOR BUILDING RESTRICTIONS AND EASEMENTS NOT SHOWN,REFER TO DEED, ABSTRACT SOURCES AND LOCAL MUNICIPAL CODES. NOTIFY THE SURVEYOR IMMEDIATELY OF ANY DISCREPANCY.

"I hereby certify that I have surveyed the above described property and that the above map is a true representation thereof and shows the size and location of all visible structures, apparent easements and encroachments if any."
This survey is made for the present owners of the property, and those who purchase, mortgage, or guarantee the title thereto, within one year from the date hereof.

DATED THIS 21st. , DAY OF AUGUST , 2003

WISCONSIN
JOHN P. KROTT
S-2258
LAKE GENEVA, WIS.
LAND SURVEYOR

JOHN KROTT S - 2258
Wisconsin Registered Land Surveyor
(original if signed in red)

218-1417