PLAT OF SURVEY

–OF–

LOT 37, CLEAR VIEW ESTATES SUBDIVISION, ACCORDING TO THE RECORDED PLAT THEREOF. SAID LAND BEING IN THE TOWN OF LYONS, WALWORTH COUNTY, WISCONSIN.


SURVEY FOR: BOB LEMBKE

SURVEY ADDRESS: 6343 2ND AVE.

JUL 10 2006

BMF

2ND (66' WIDE) *AVE.*

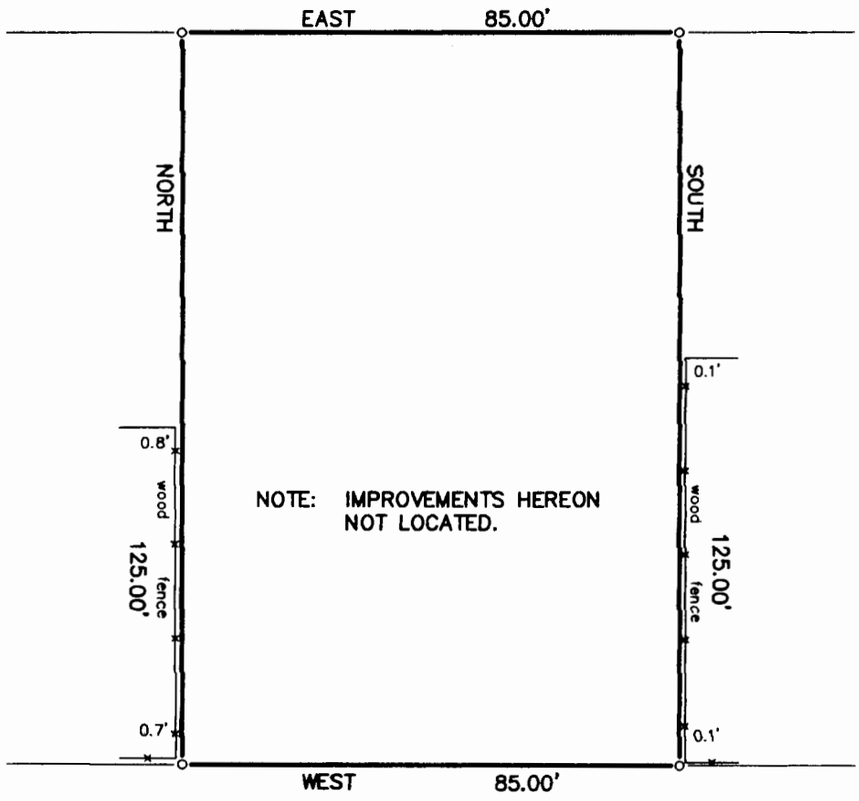




SCALE 1" = 30'

"I hereby certify that I have surveyed the above described property and that the above map is a correct representation thereof and shows the size and location of the property, its exterior boundaries, the location of all visible structures and dimensions of all principal buildings thereon, boundary fences, apparent easements, roadways and encroachments, if any."

"This survey is made for the use of the present owners of the property, and those who purchase, mortgage, or guarantee the title thereto within one year from date hereof."

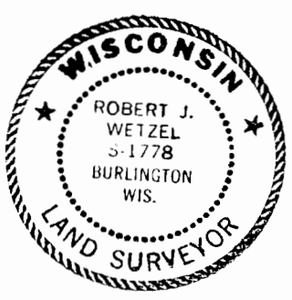

LEGEND

- ○ FOUND IRON ROD
- ● SET IRON PIPE



B.W. SURVEYING, INC.

412 N. PINE STREET
BURLINGTON, WI 53105
(262)–767–0225

THIS IS NOT AN ORIGINAL PRINT UNLESS THIS SEAL IS RED.

Robert J. Wetzel

ROBERT J. WETZEL S–1778

JUNE 20, 2006 DATE

218–1587 7302 JOB NUMBER

NCL–37