
PLAT OF SURVEY
-OF-

LOT 2 OF CERTIFIED SURVEY MAP NO. 3780, RECORDED APRIL 6, 2005 IN THE OFFICE OF THE REGISTER OF DEEDS IN AND FOR WALWORTH COUNTY, WISCONSIN IN VOLUME 22 OF CERTIFIED SURVEY MAPS ON PAGE 339 AS DOCUMENT NO. 000635829 AND BEING A PART OF THE SOUTHWEST 1/4 OF THE SOUTHEAST 1/4 OF SECTION 26 AND PART OF THE NORTHWEST 1/4 OF THE NORTHEAST 1/4 OF SECTION 35, ALL IN TOWNSHIP 2 NORTH, RANGE 18 EAST OF THE FOURTH PRINCIPAL MERIDIAN, IN THE TOWNSHIP OF LYONS, WALWORTH COUNTY, WISCONSIN.

SURVEY FOR: TERRY SCHY

SURVEY ADDRESS: 5537 CRANBERRY ROAD

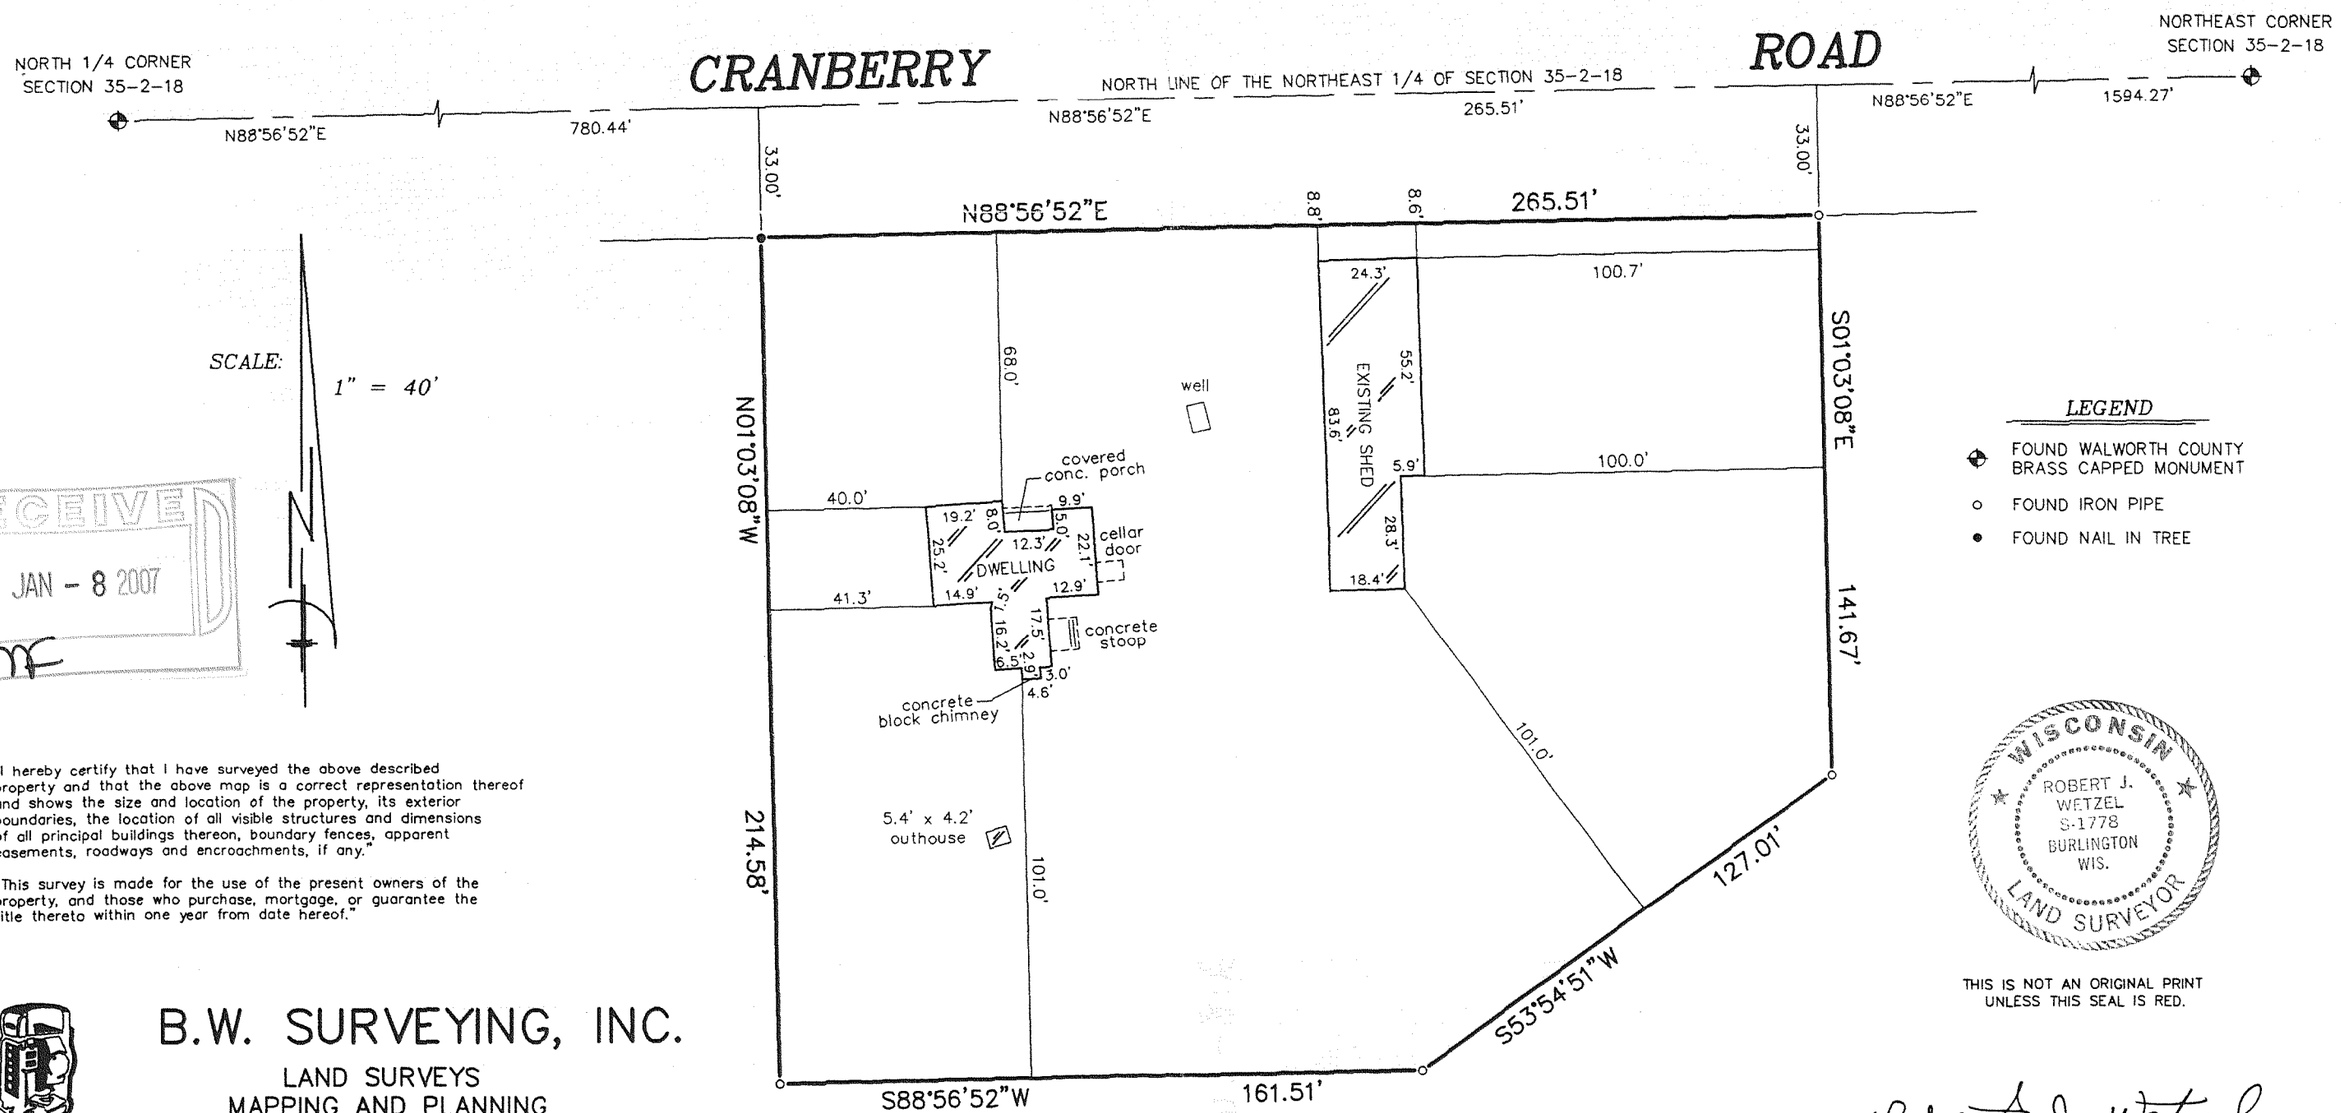

RECEIVED
JAN - 8 2007

LEGEND


- FOUND WALWORTH COUNTY BRASS CAPPED MONUMENT
- FOUND IRON PIPE
- FOUND NAIL IN TREE

"I hereby certify that I have surveyed the above described property and that the above map is a correct representation thereof and shows the size and location of the property, its exterior boundaries, the location of all visible structures and dimensions of all principal buildings thereon, boundary fences, apparent easements, roadways and encroachments, if any."

"This survey is made for the use of the present owners of the property, and those who purchase, mortgage, or guarantee the title thereto within one year from date hereof."

WISCONSIN
ROBERT J. WETZEL
S-1778
BURLINGTON WIS.
LAND SURVEYOR

THIS IS NOT AN ORIGINAL PRINT UNLESS THIS SEAL IS RED.

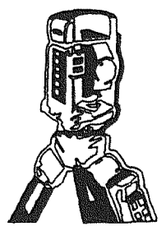

B.W. SURVEYING, INC.
LAND SURVEYS
MAPPING AND PLANNING
412 N. PINE STREET
BURLINGTON, WI 53105
(262)-767-0225

Robert J Wetzel
ROBERT J. WETZEL S-1778

NOVEMBER 13, 2006 — DATE

7447 — JOB NUMBER

NA3780-2

218-1616